


2/23/2005 8:35:55 AM

2/24/2005 11:22:07 AM SAP-CILVORED SK-122178-21-06_001_000_00_CURRENT_COP100.TIF

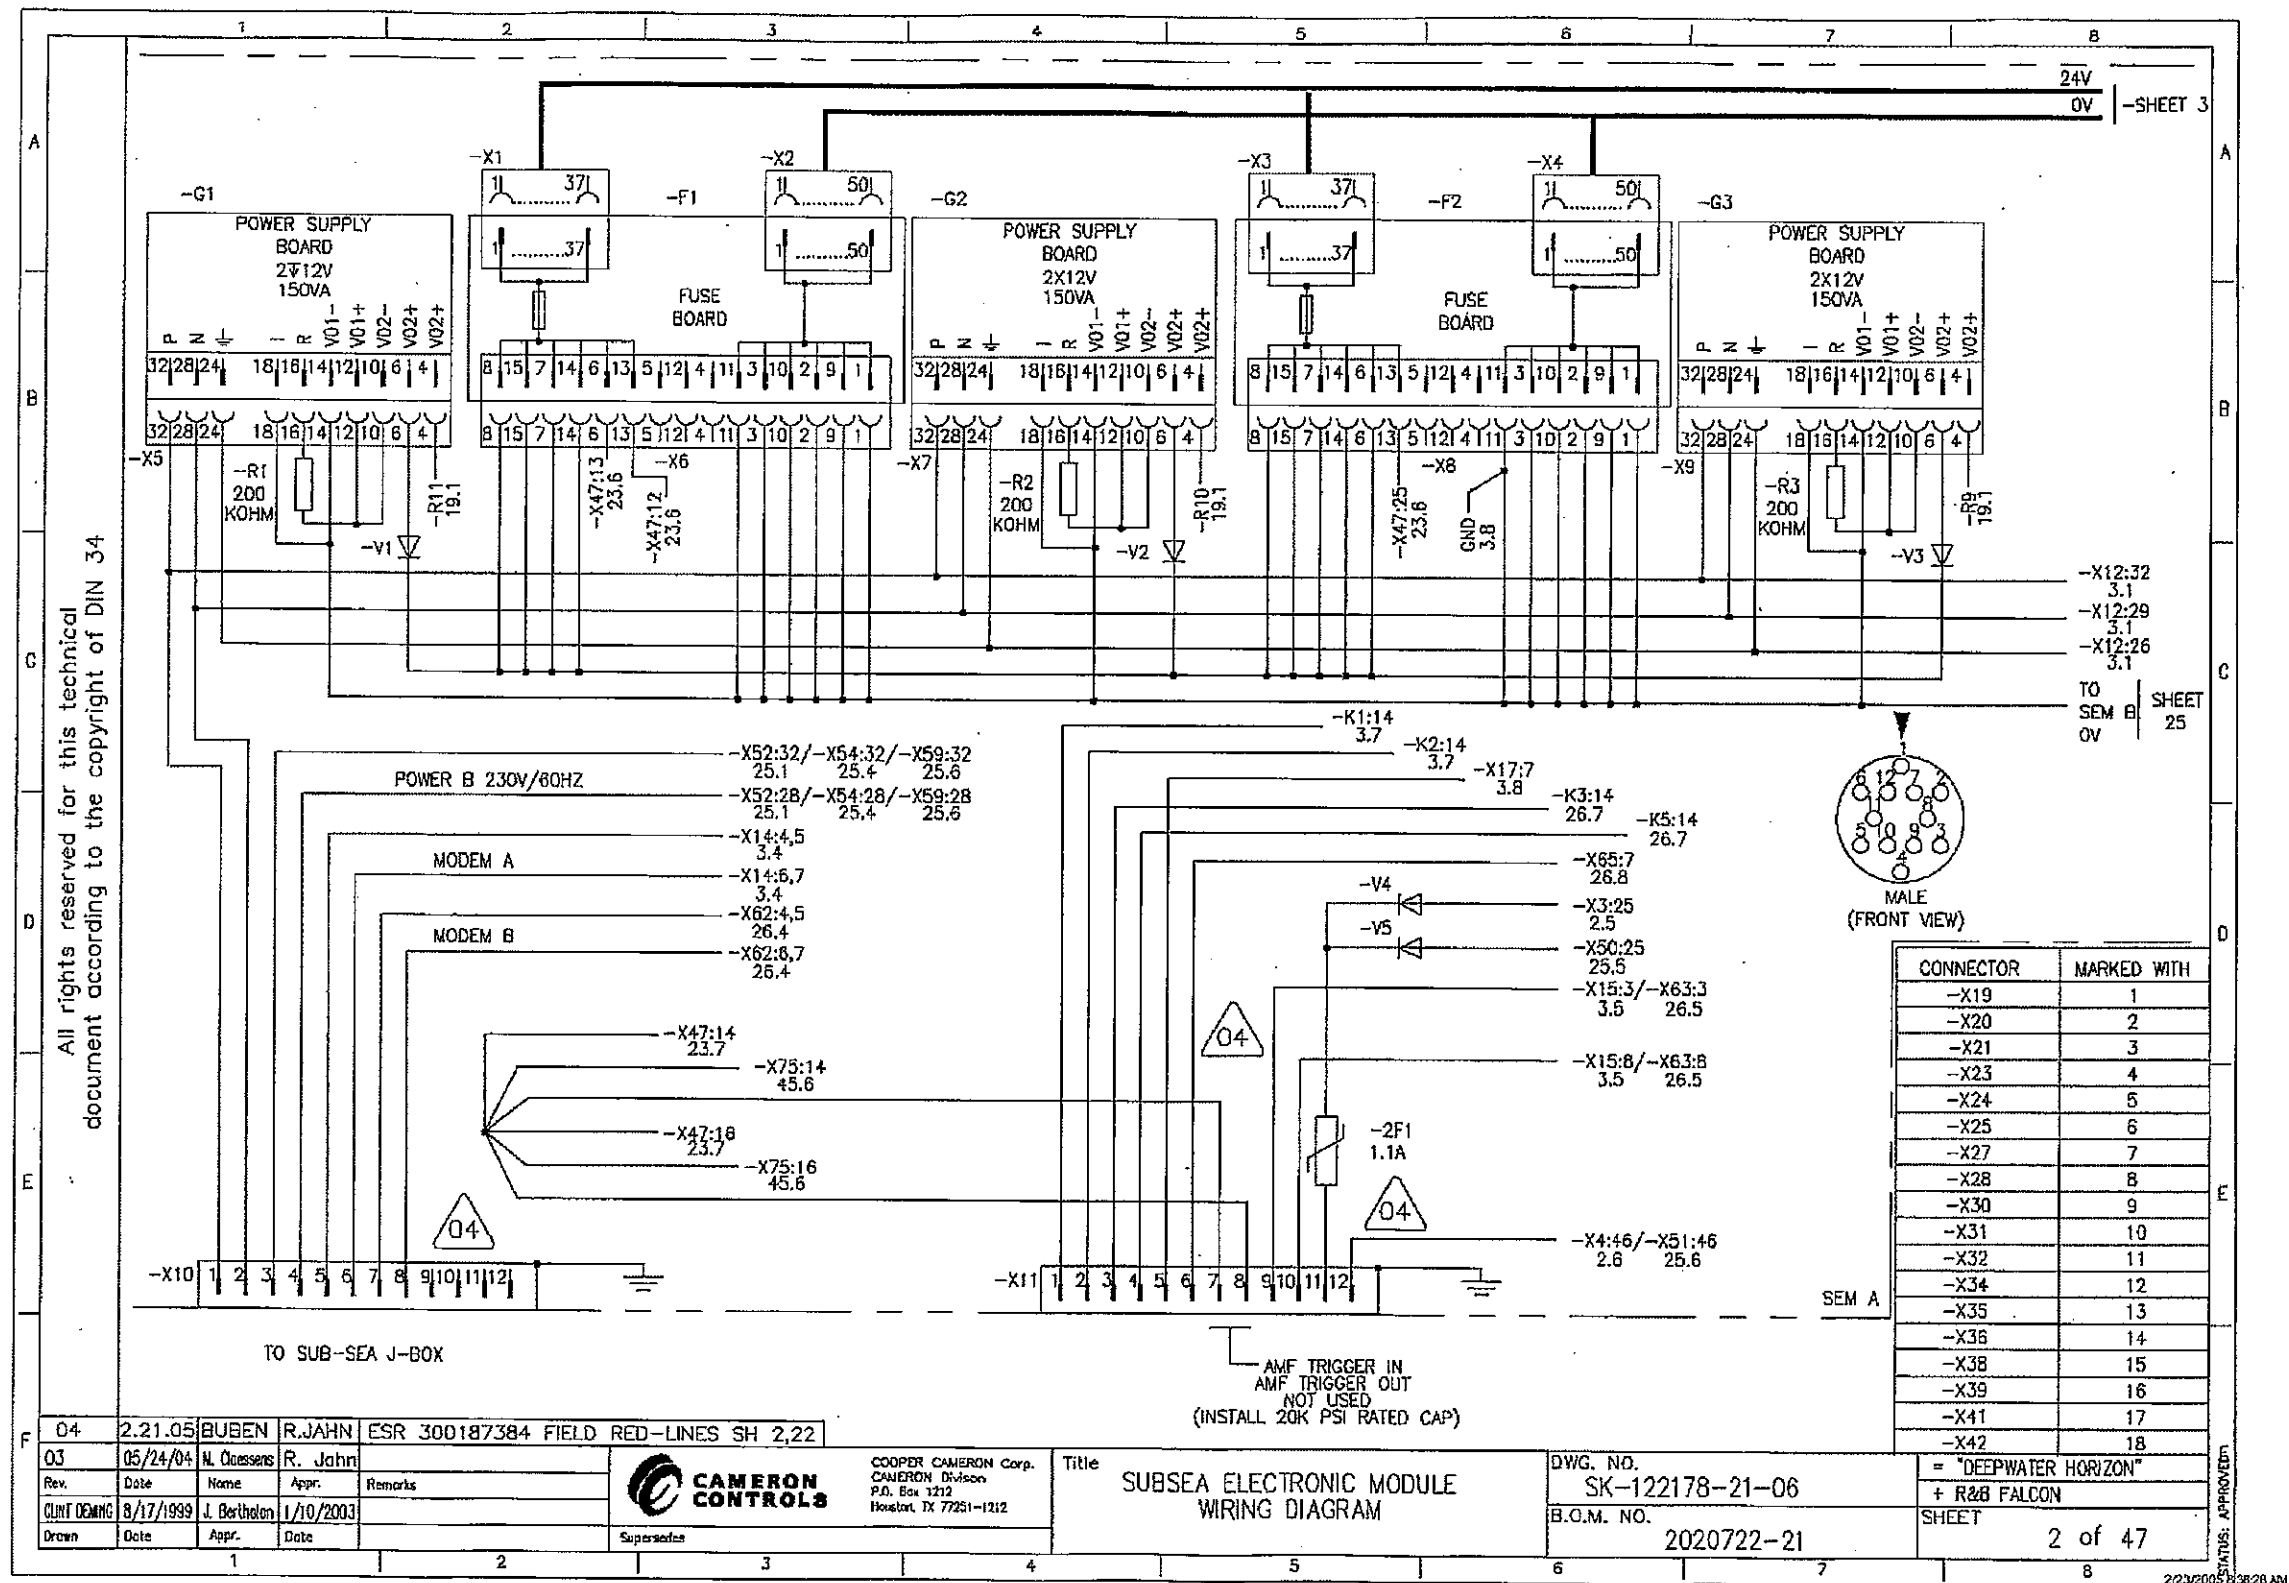


CONFIDENTIAL

TRN-MDL-00304716




2/24/2005 11:22:07 AM SAP-GILMORED SK-122178-21-06_001_000_000_CURRENT_CCP100.TIF

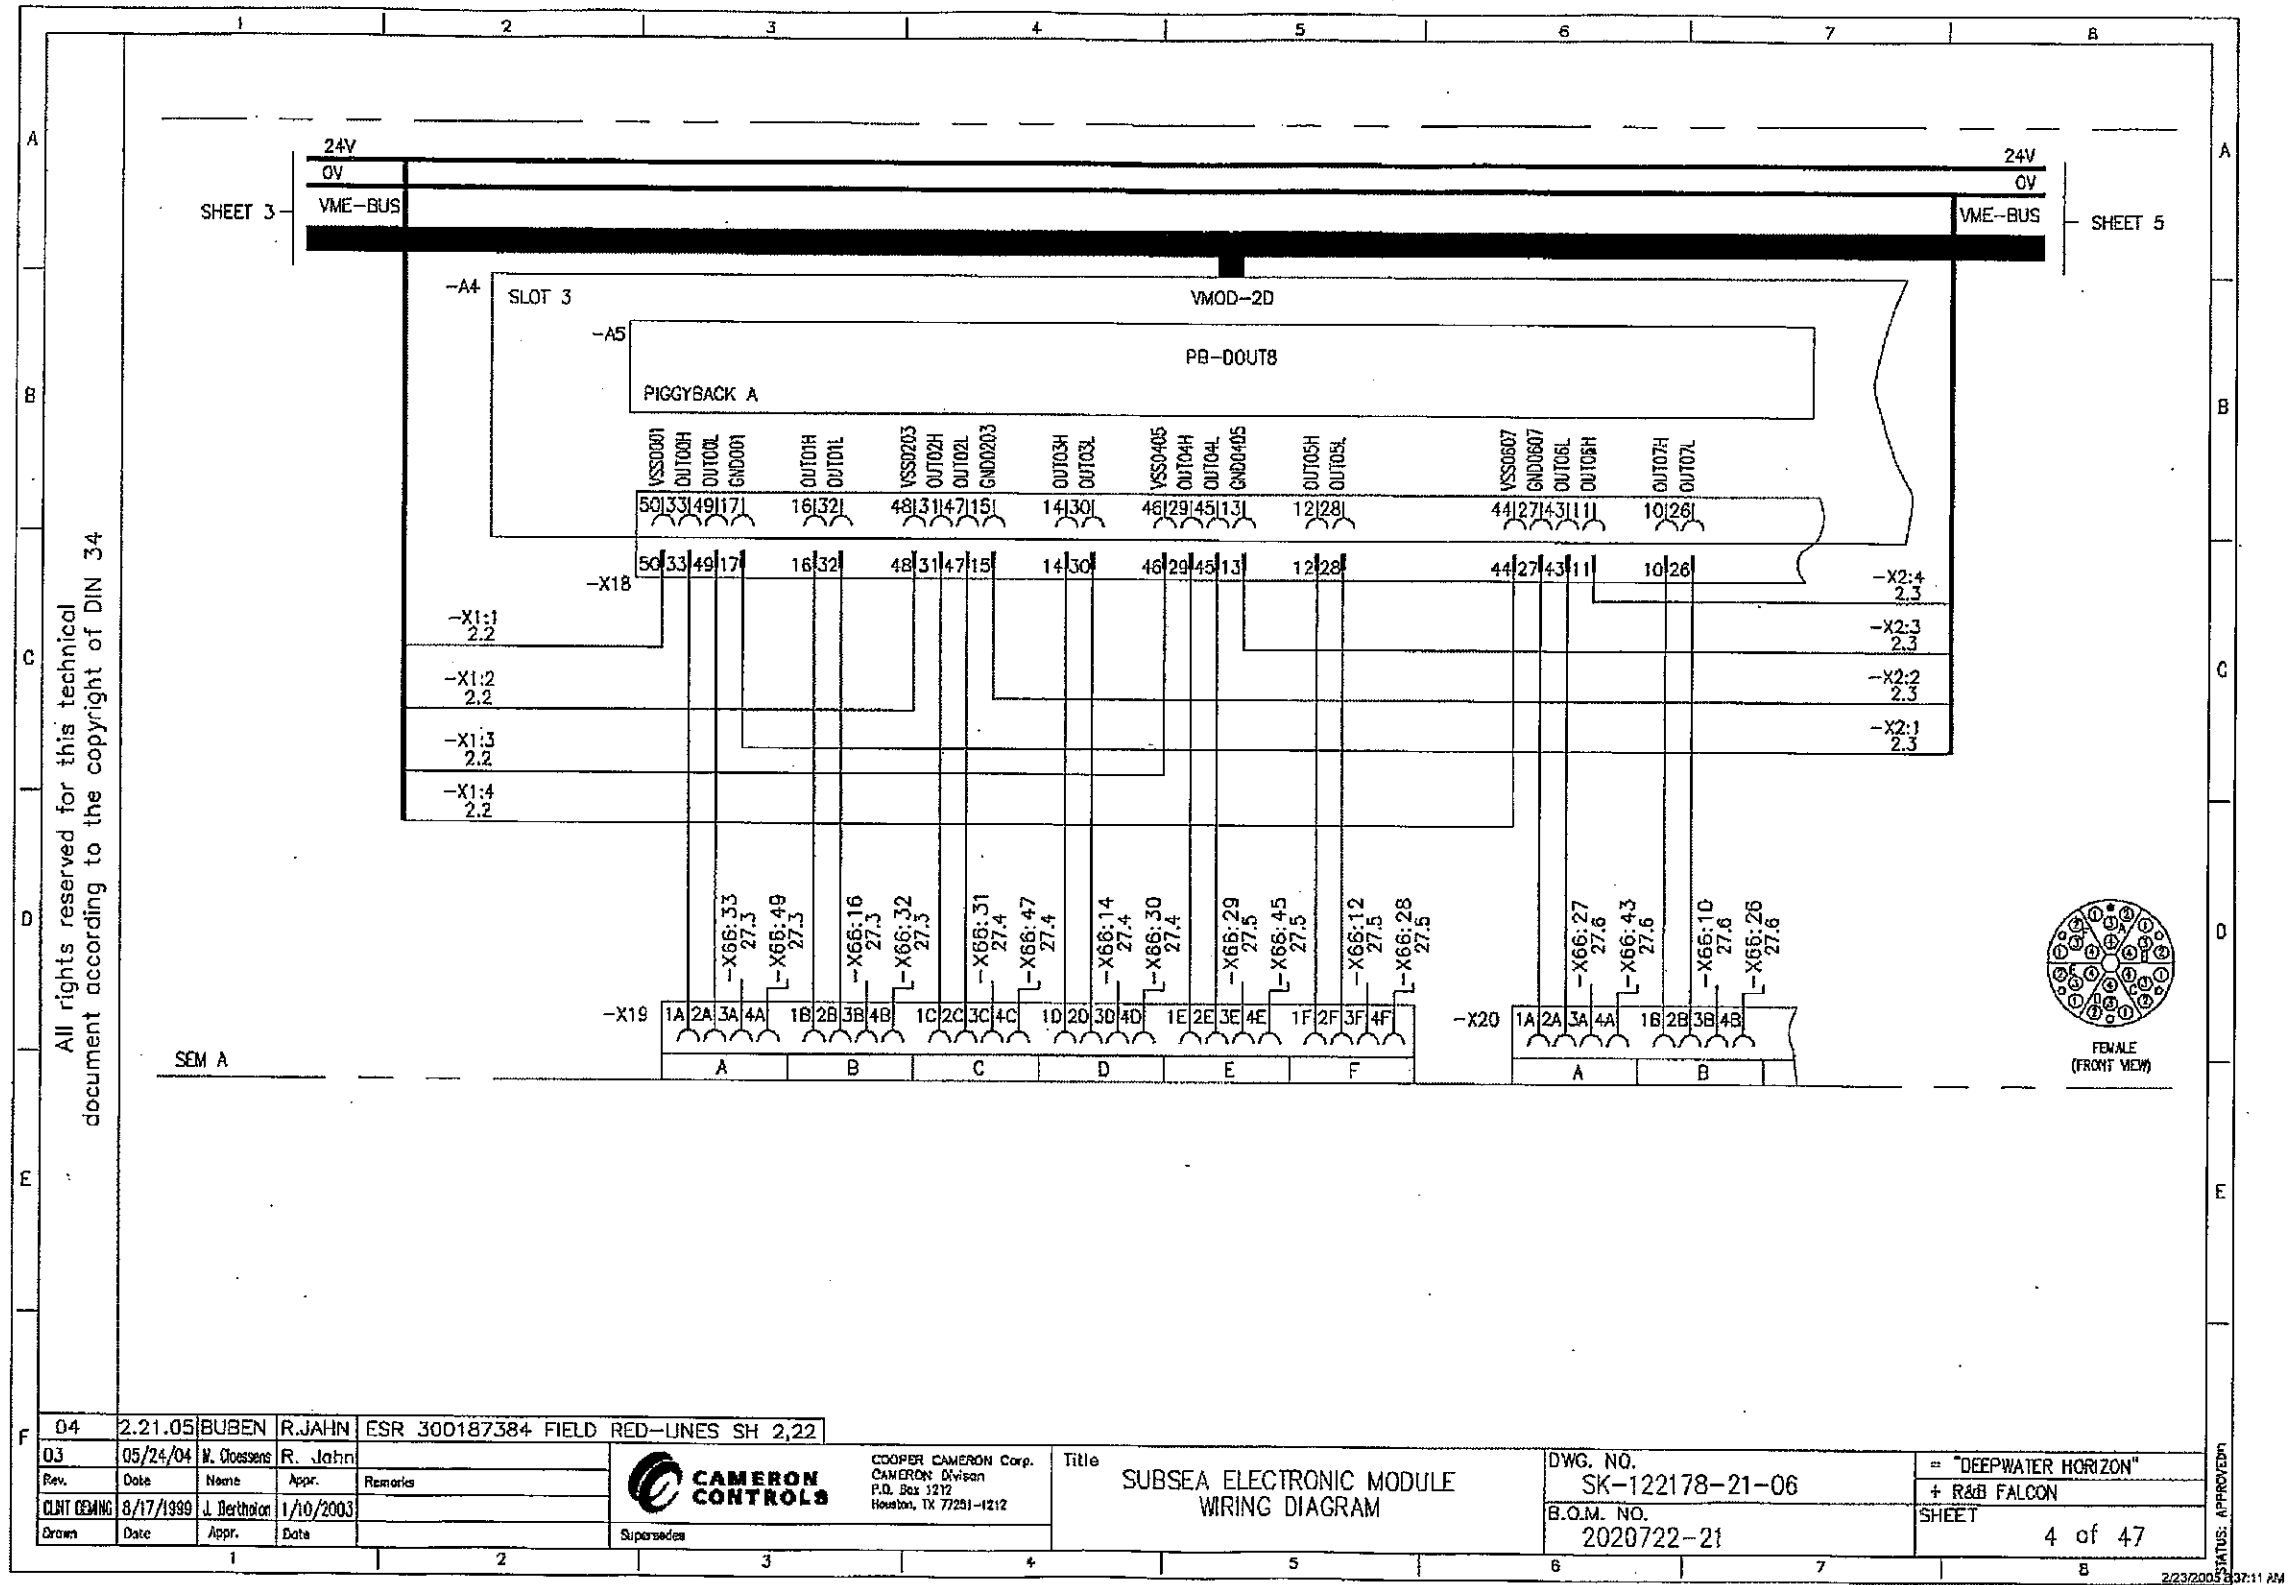

CONFIDENTIAL

TRN-MDL-00304718


2/24/2005 11:22:07 AM SAP-DILMORED SK-122178-21-06.001.000.00_CURRENT_COPY00.TIF

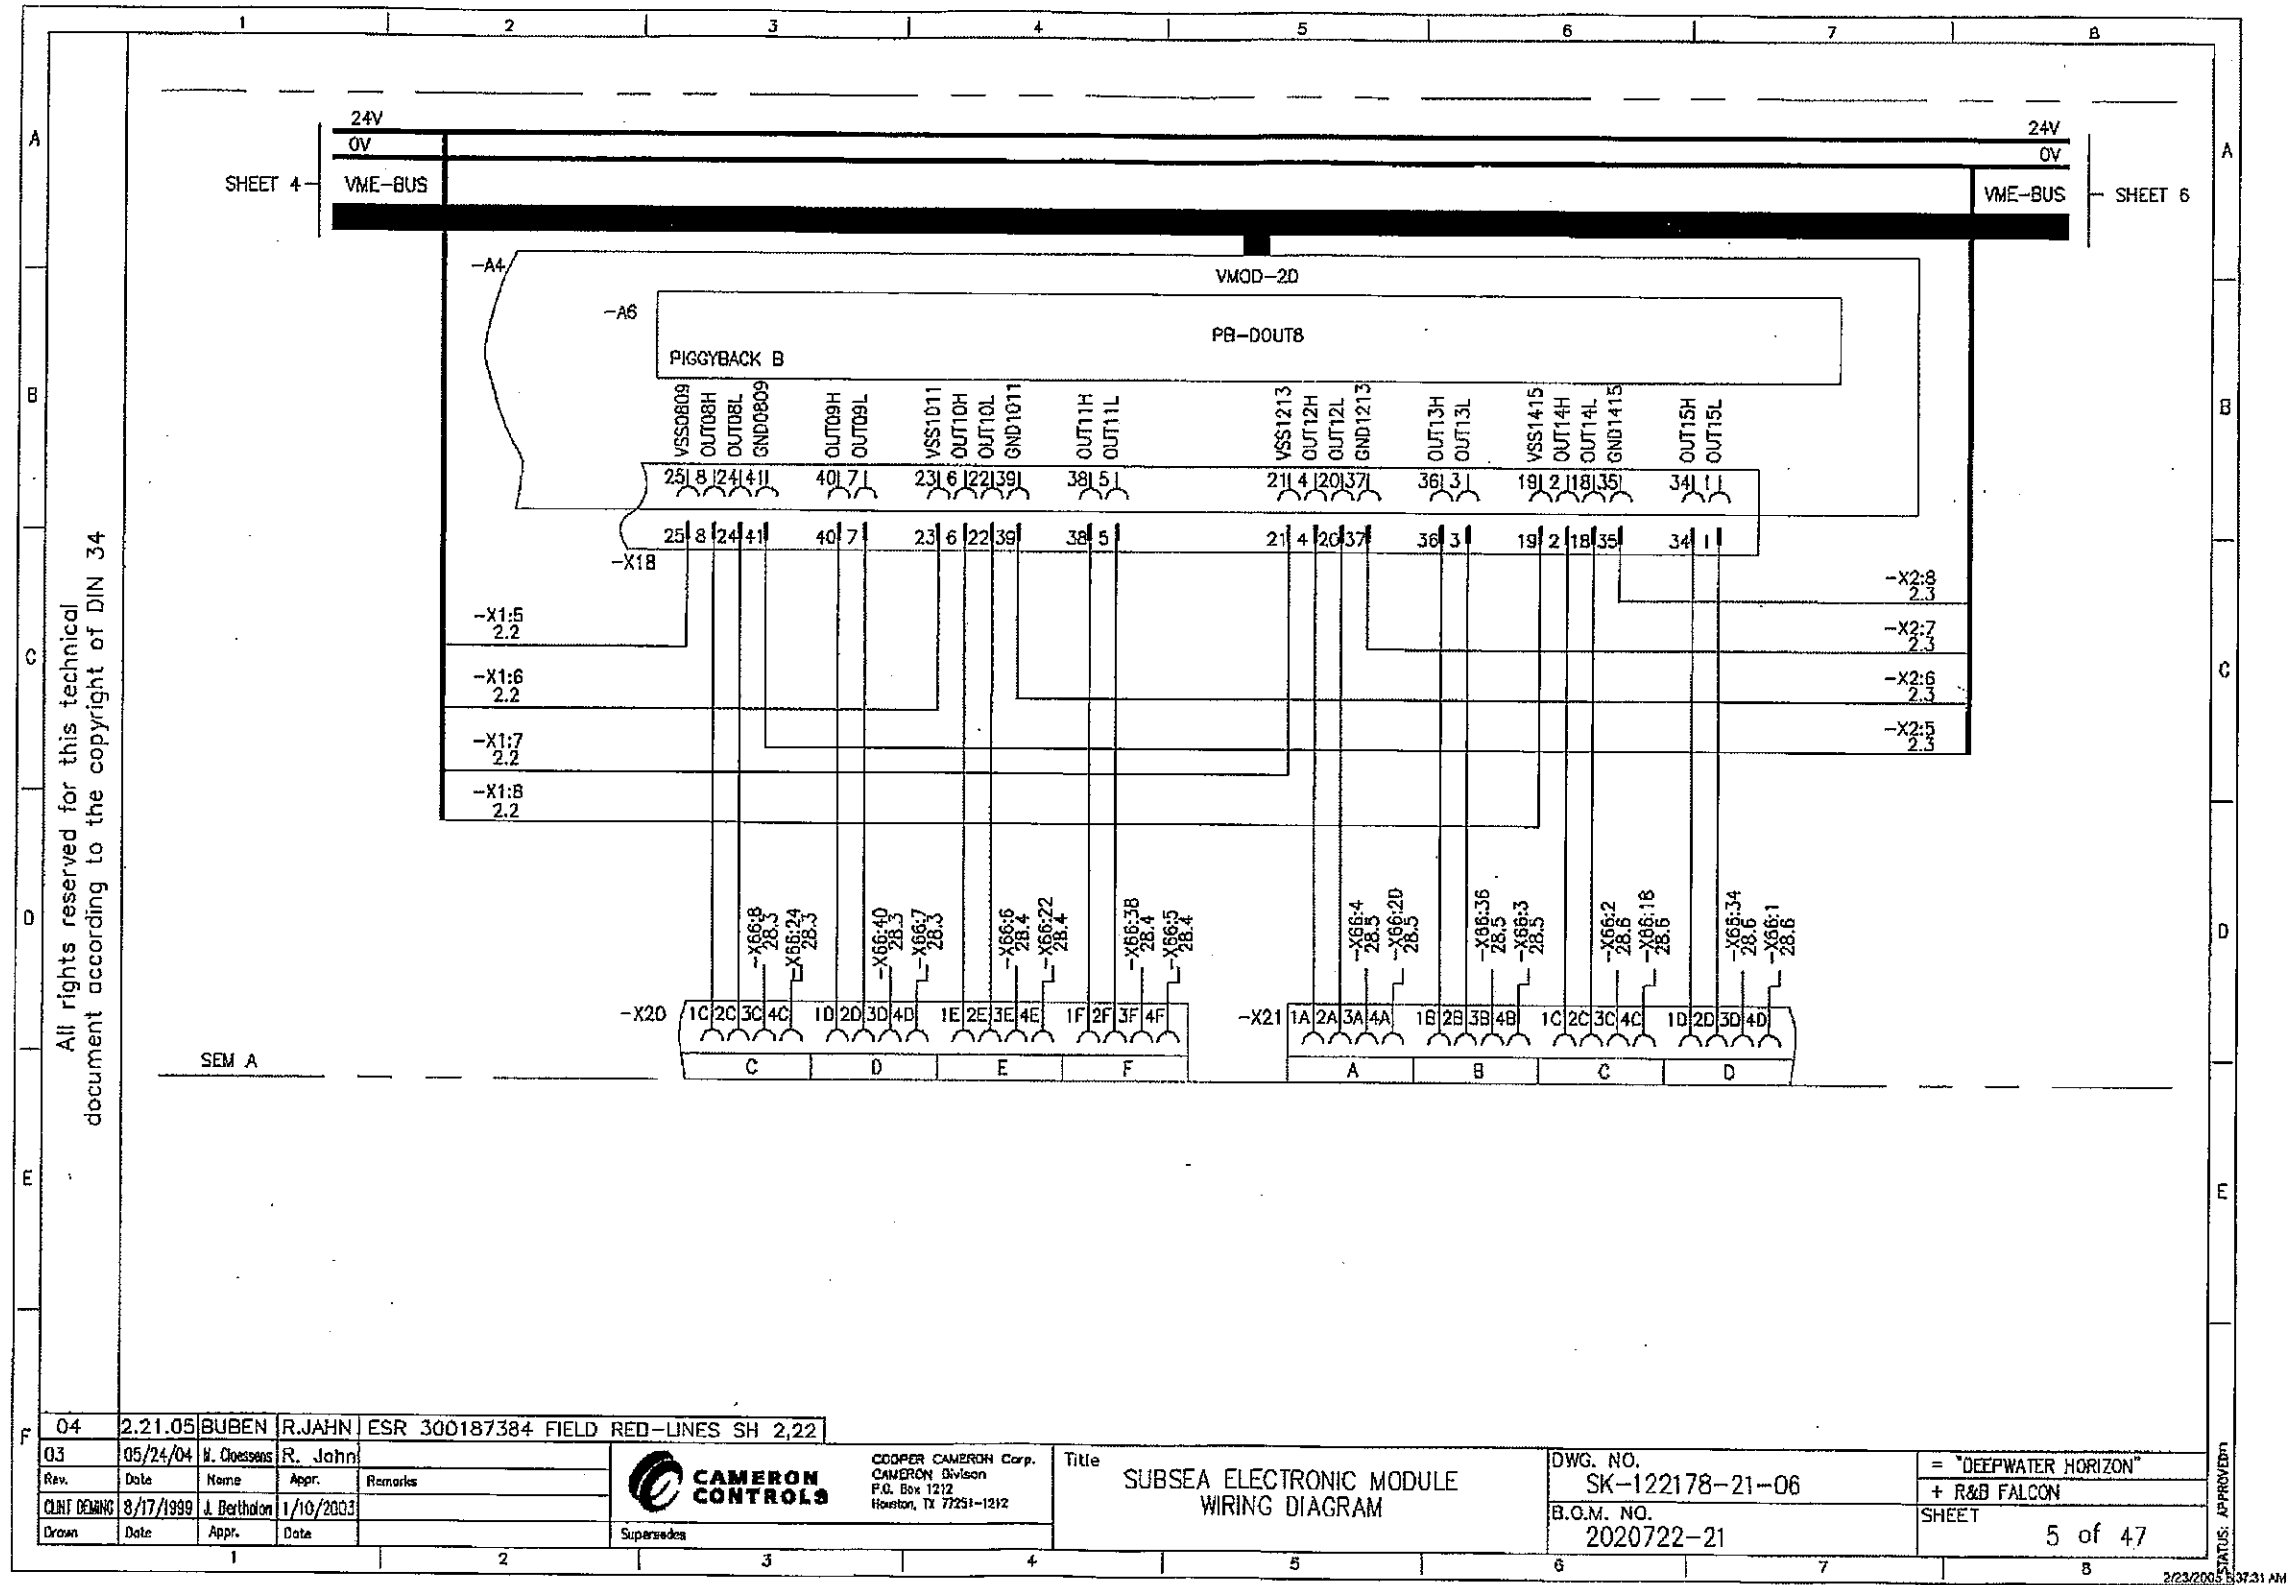

CONFIDENTIAL

TRN-MDL-00304719


2/24/2005 11:22:07 AM SAP-GILMORED SK-122178-21-06.001.000.00 CURRENT_COPY000.TIF

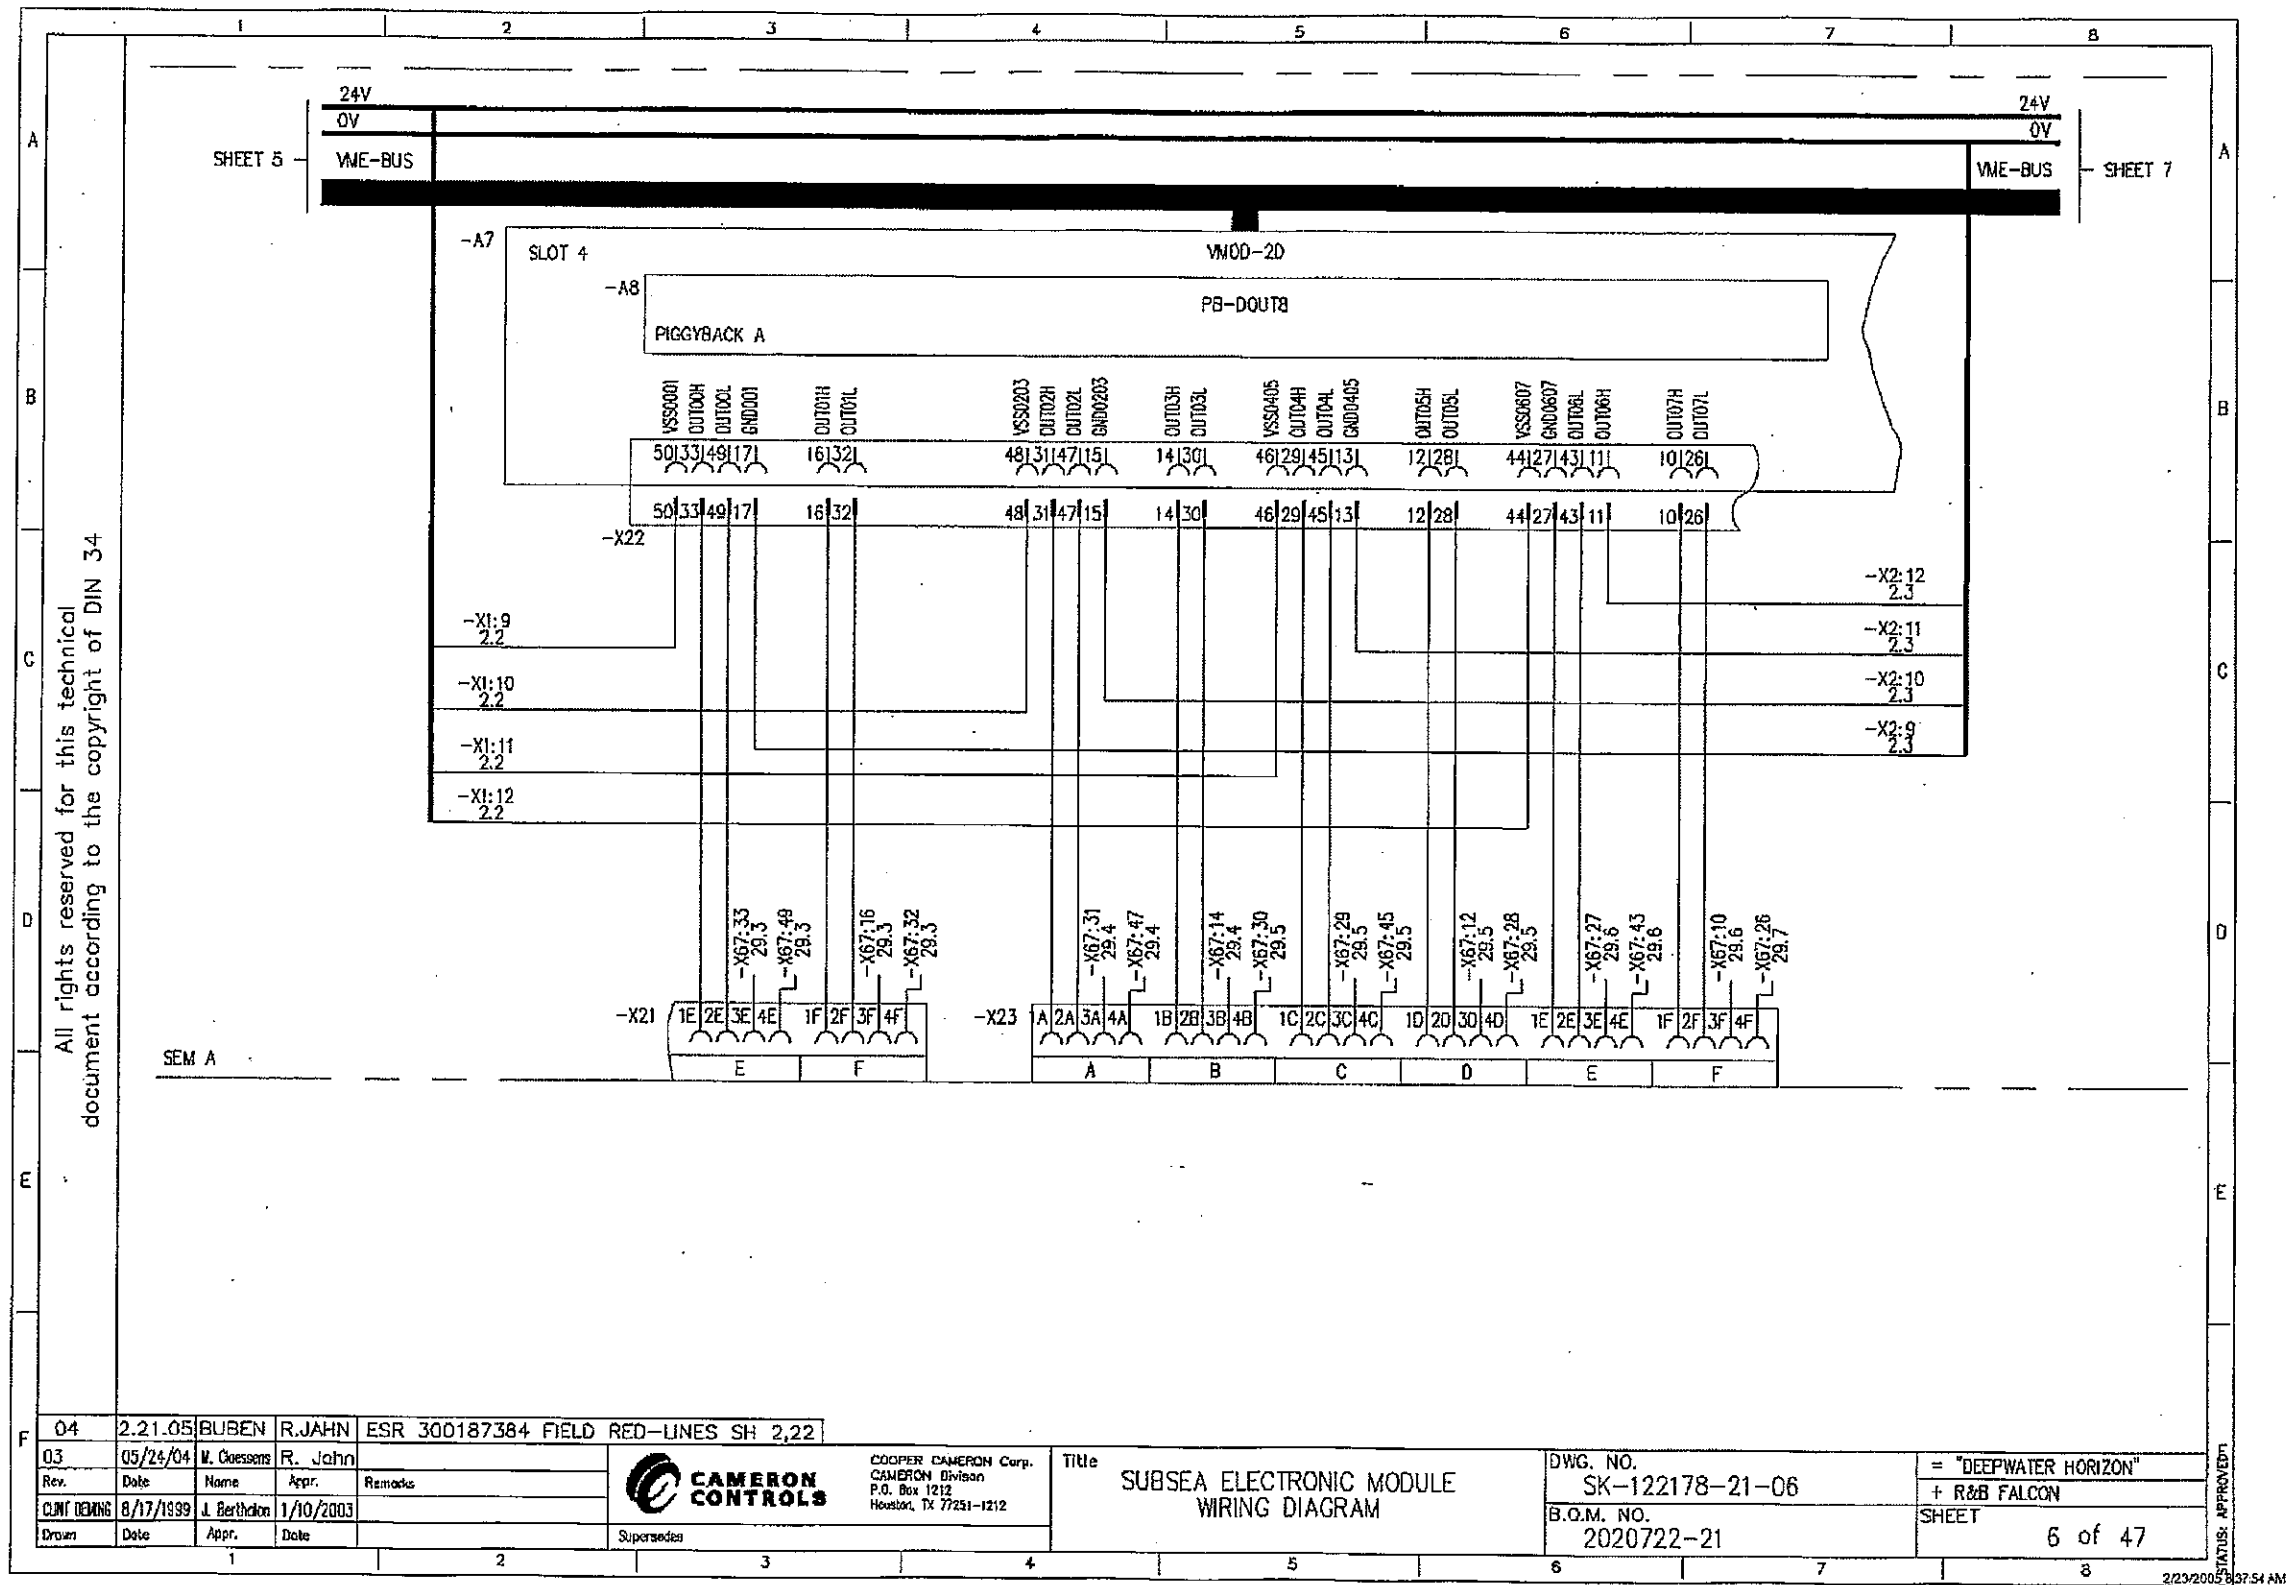

CONFIDENTIAL

TRN-MDL-00304720


2/24/2005 11:22:07 AM SAP-GILMORED SK-122178-21-06_001_000_00_CURRENT_COP100.TIF

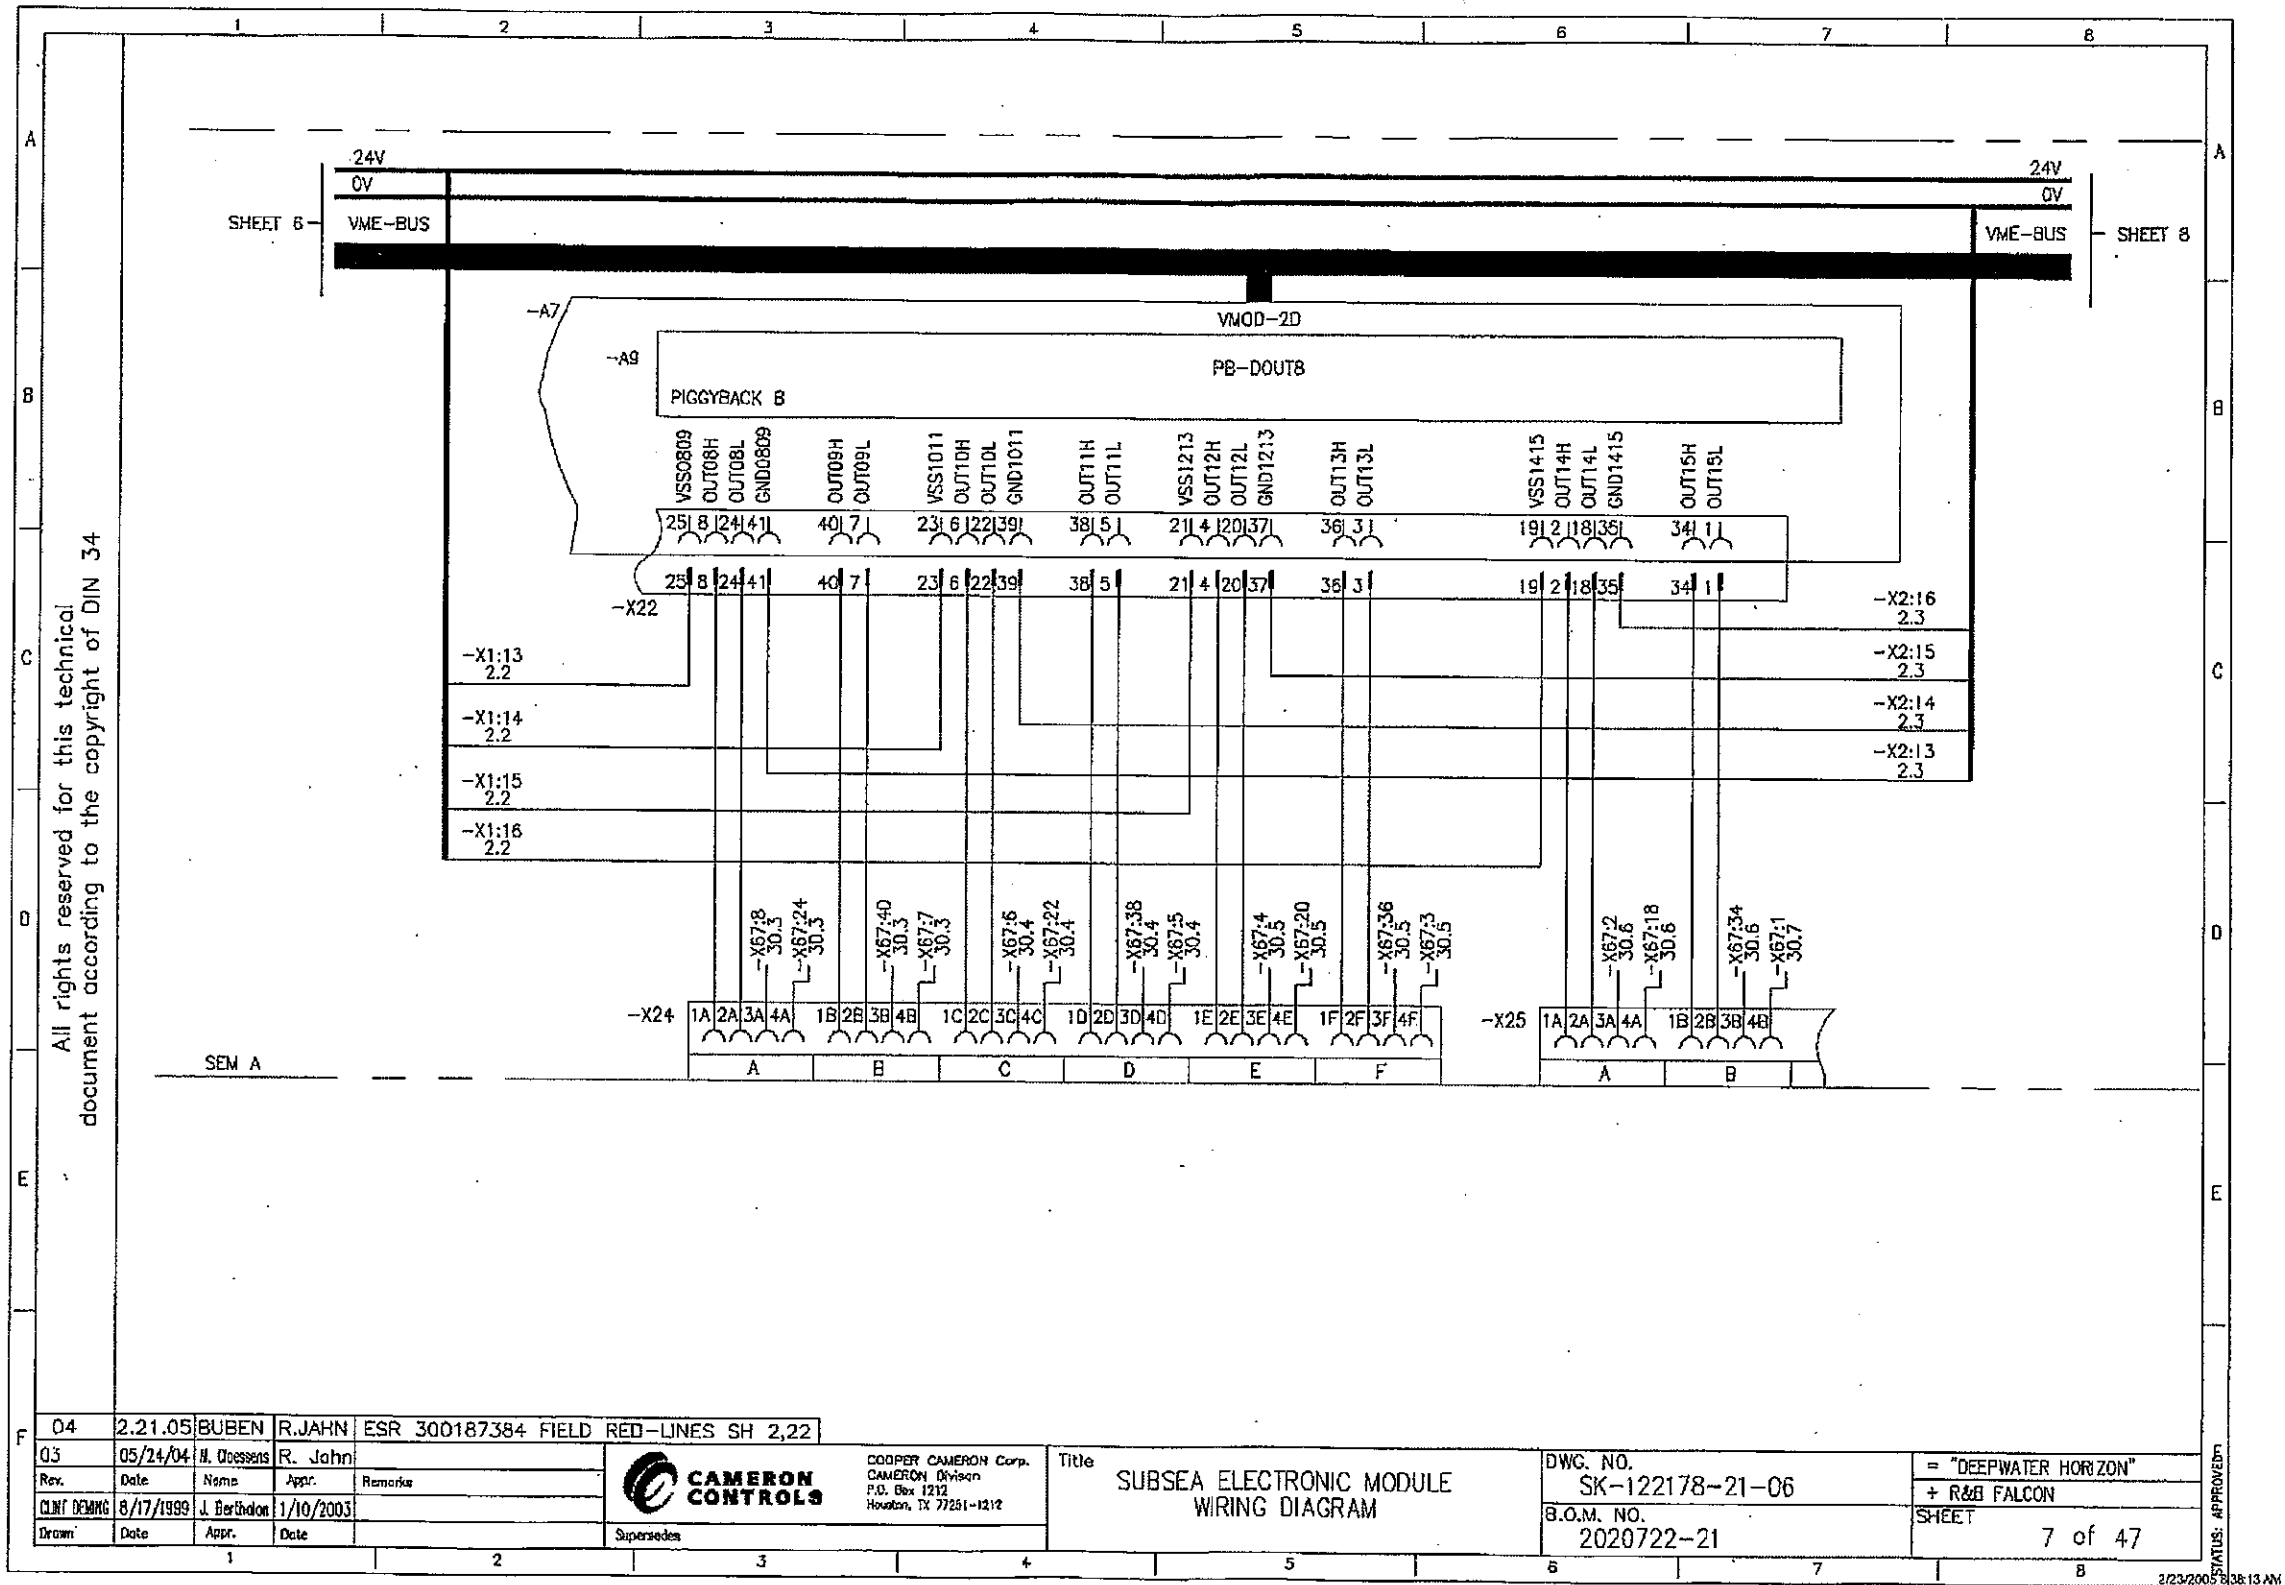

TRN-MDL-00304721

CONFIDENTIAL


2/24/2005 11:22:07 AM SAP-GILMORED SK-122178-21-06_001_000_00_CURRENT.CCP100.TIF

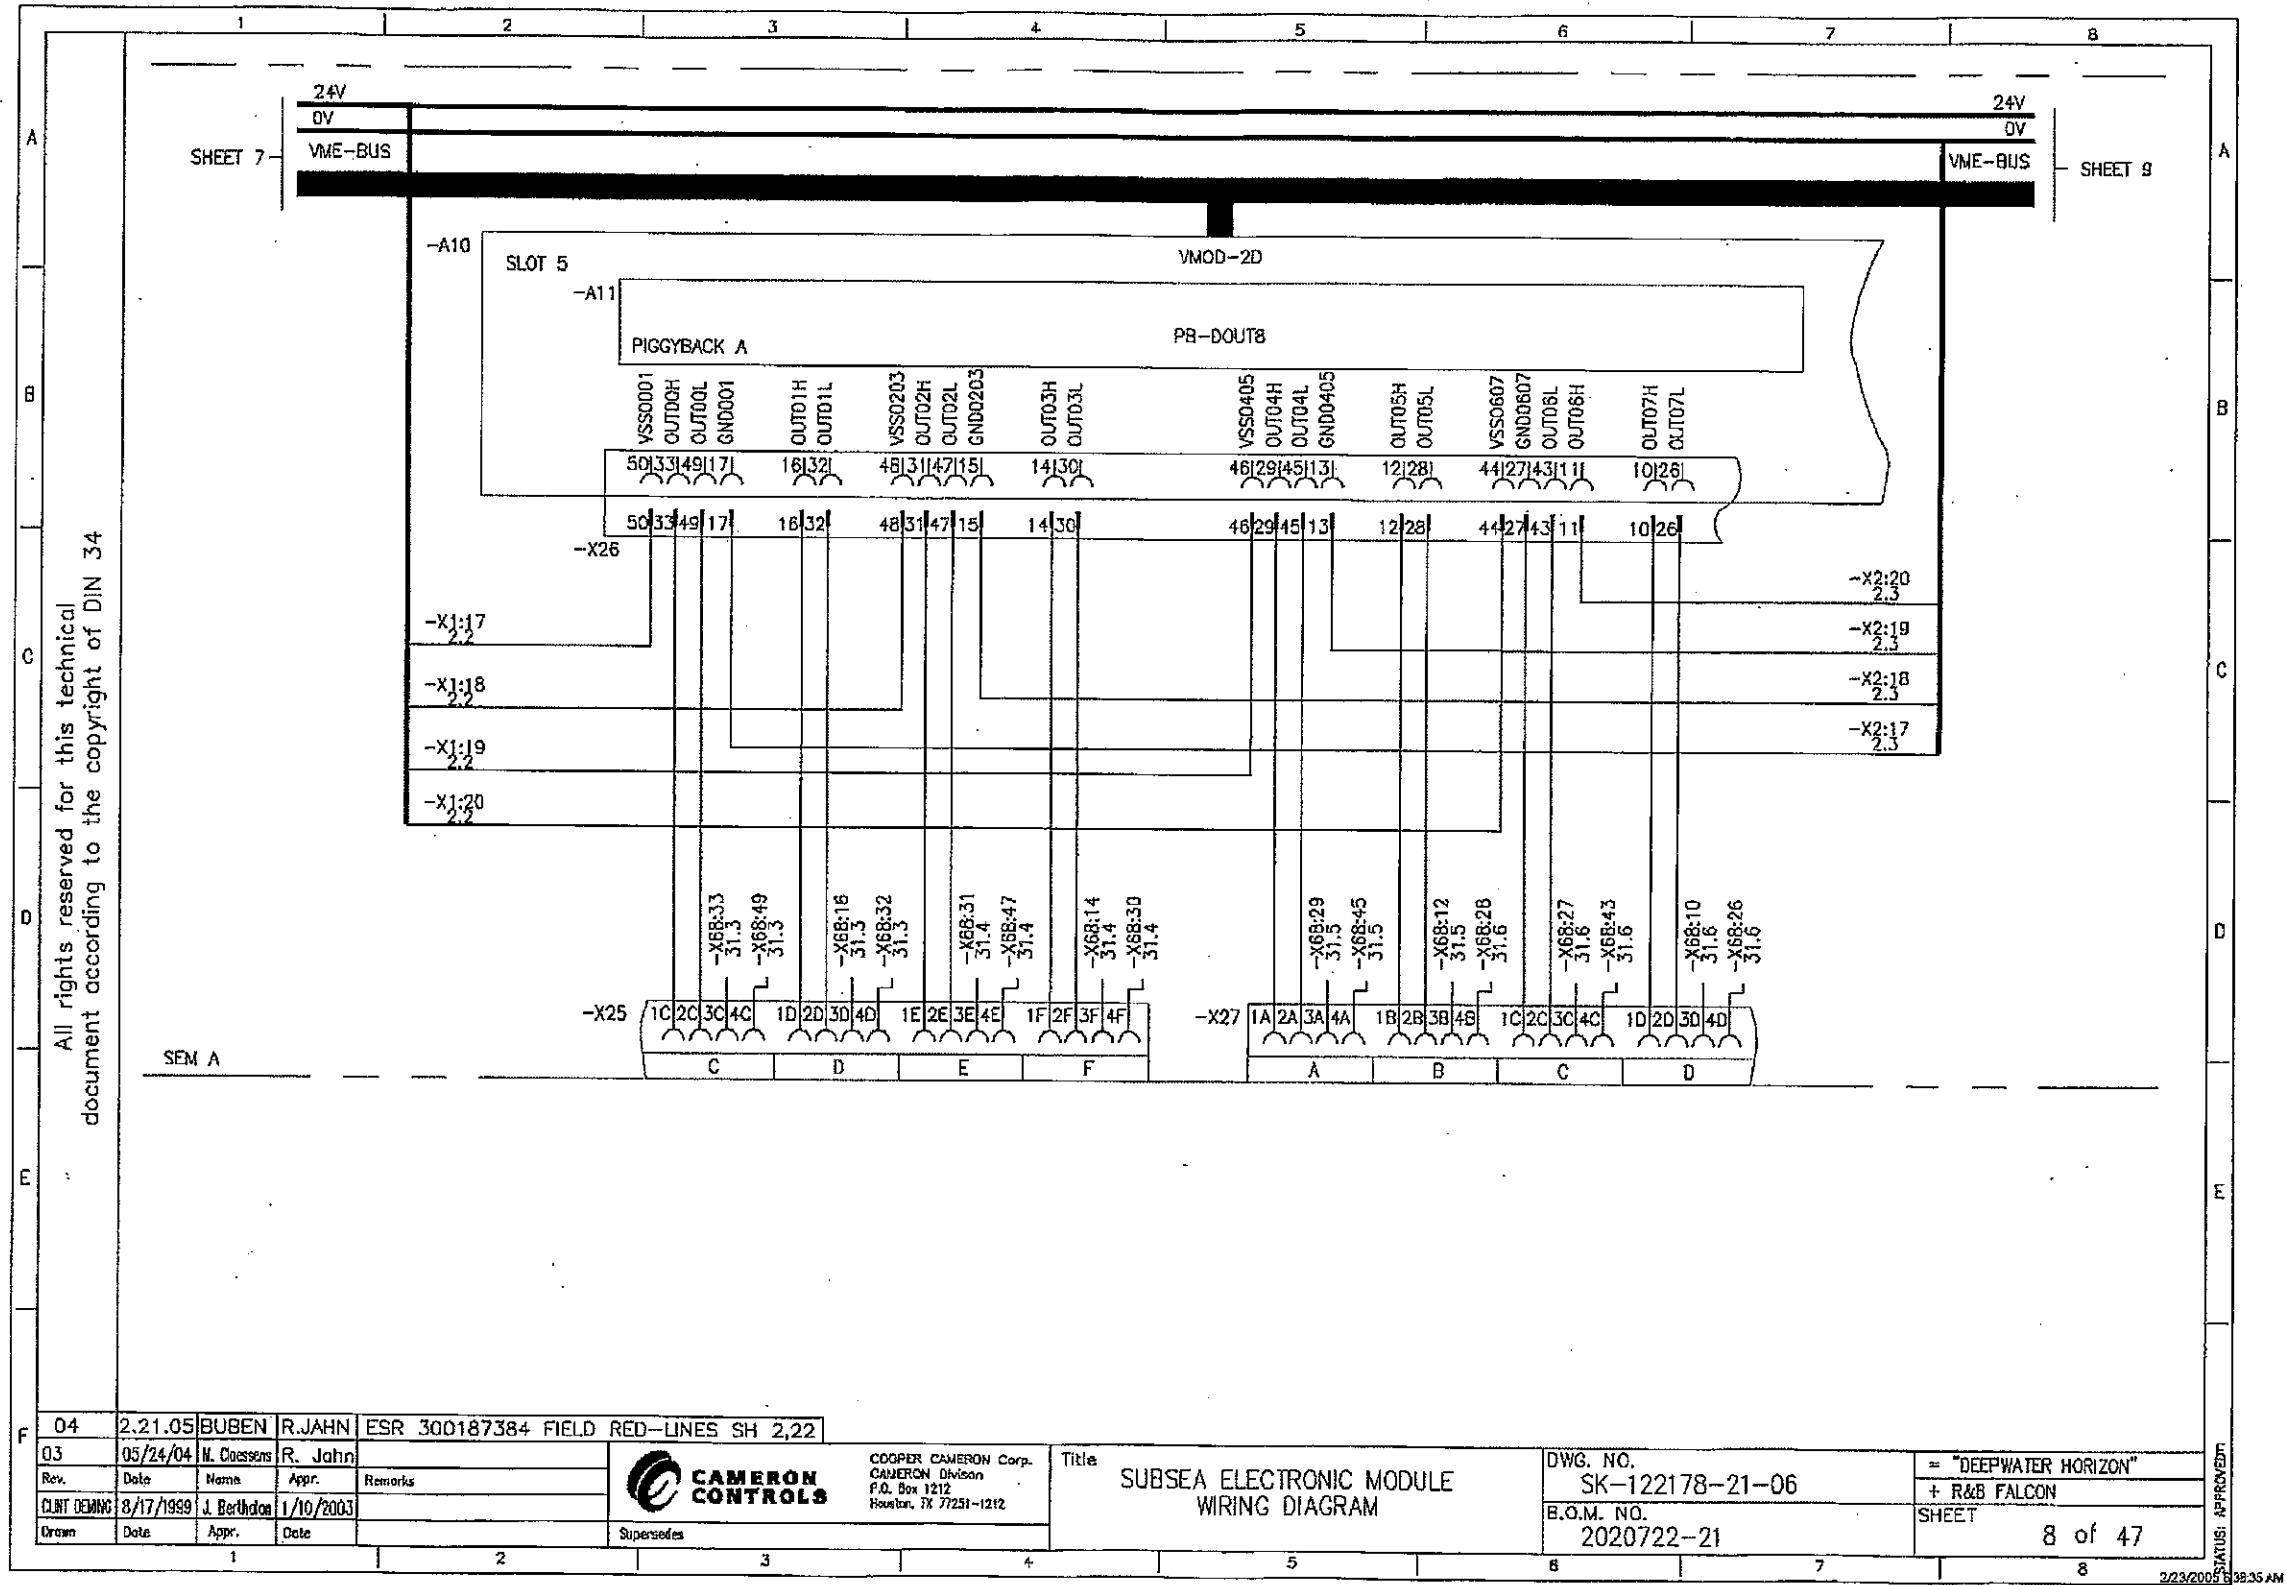

CONFIDENTIAL

TRN-MDL-00304722


2/24/2005 11:22:07 AM SAP-CILMORED SK-122178-21-06.001.000.00.CURRENT_COP100.TIF

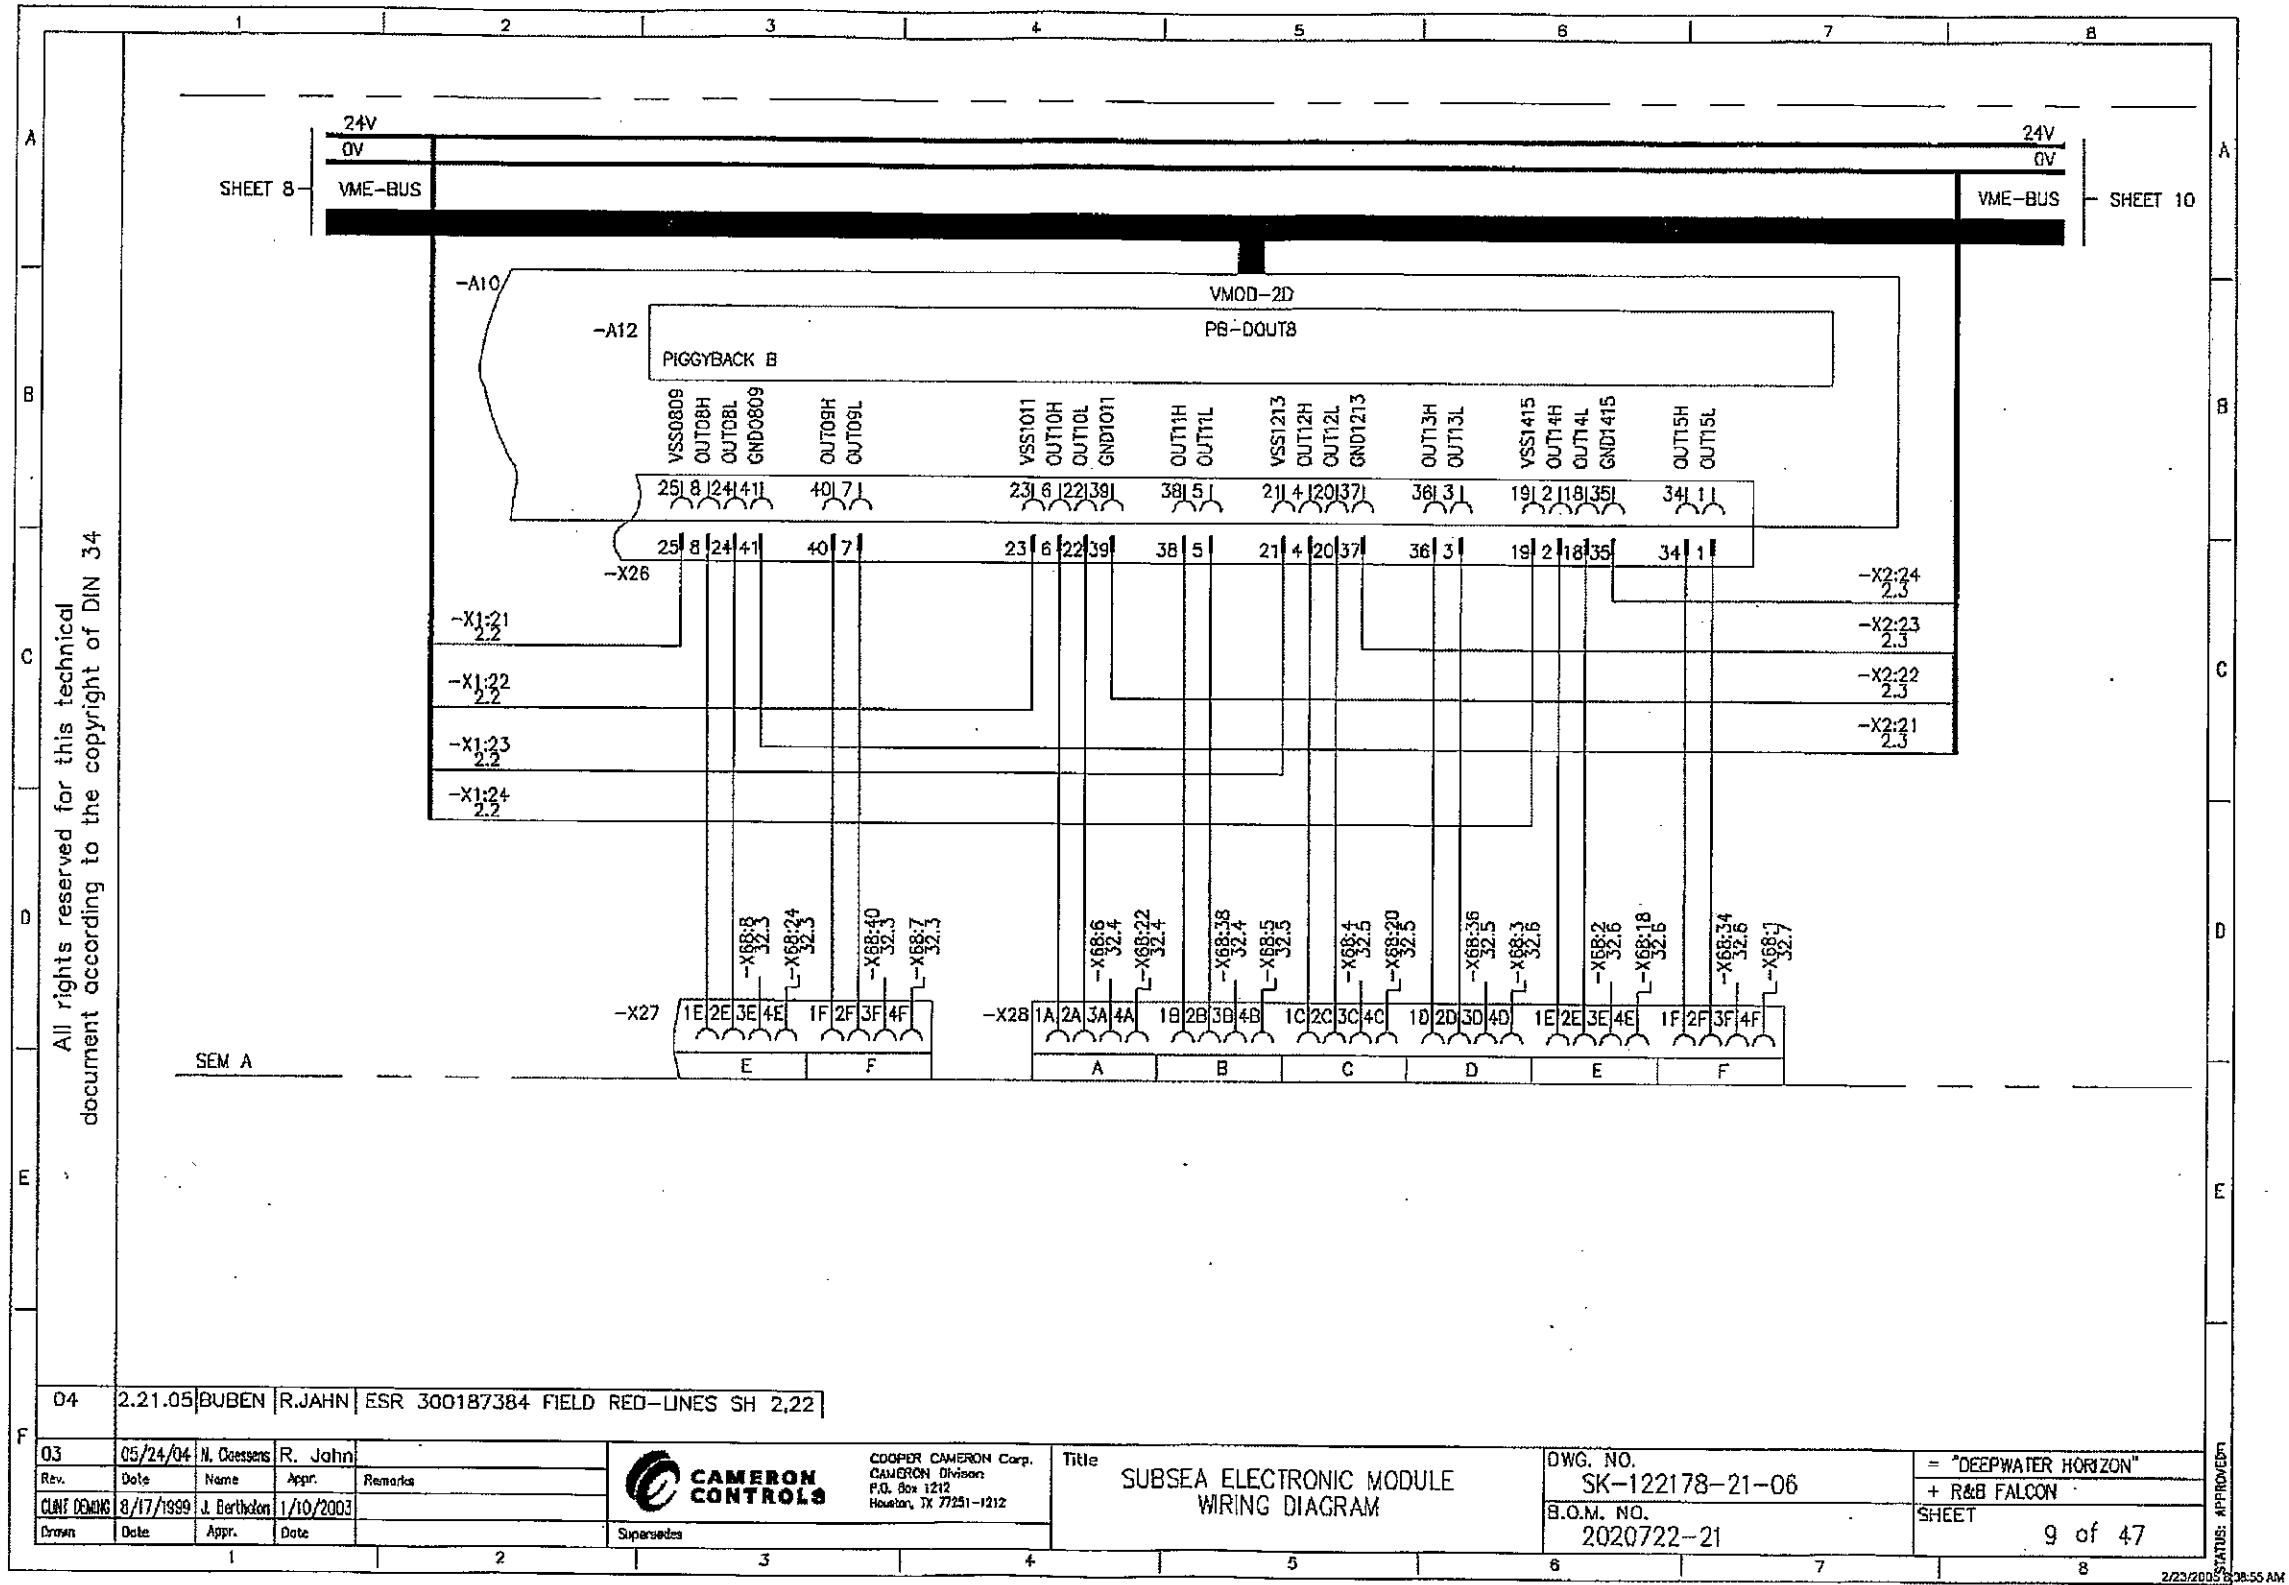

CONFIDENTIAL


TRN-MDL-00304723

2/24/2005 11:22:07 AM SAP-GILMORED SK-122178-21-06_001_000_00_CURRENT_CCP100.TIF

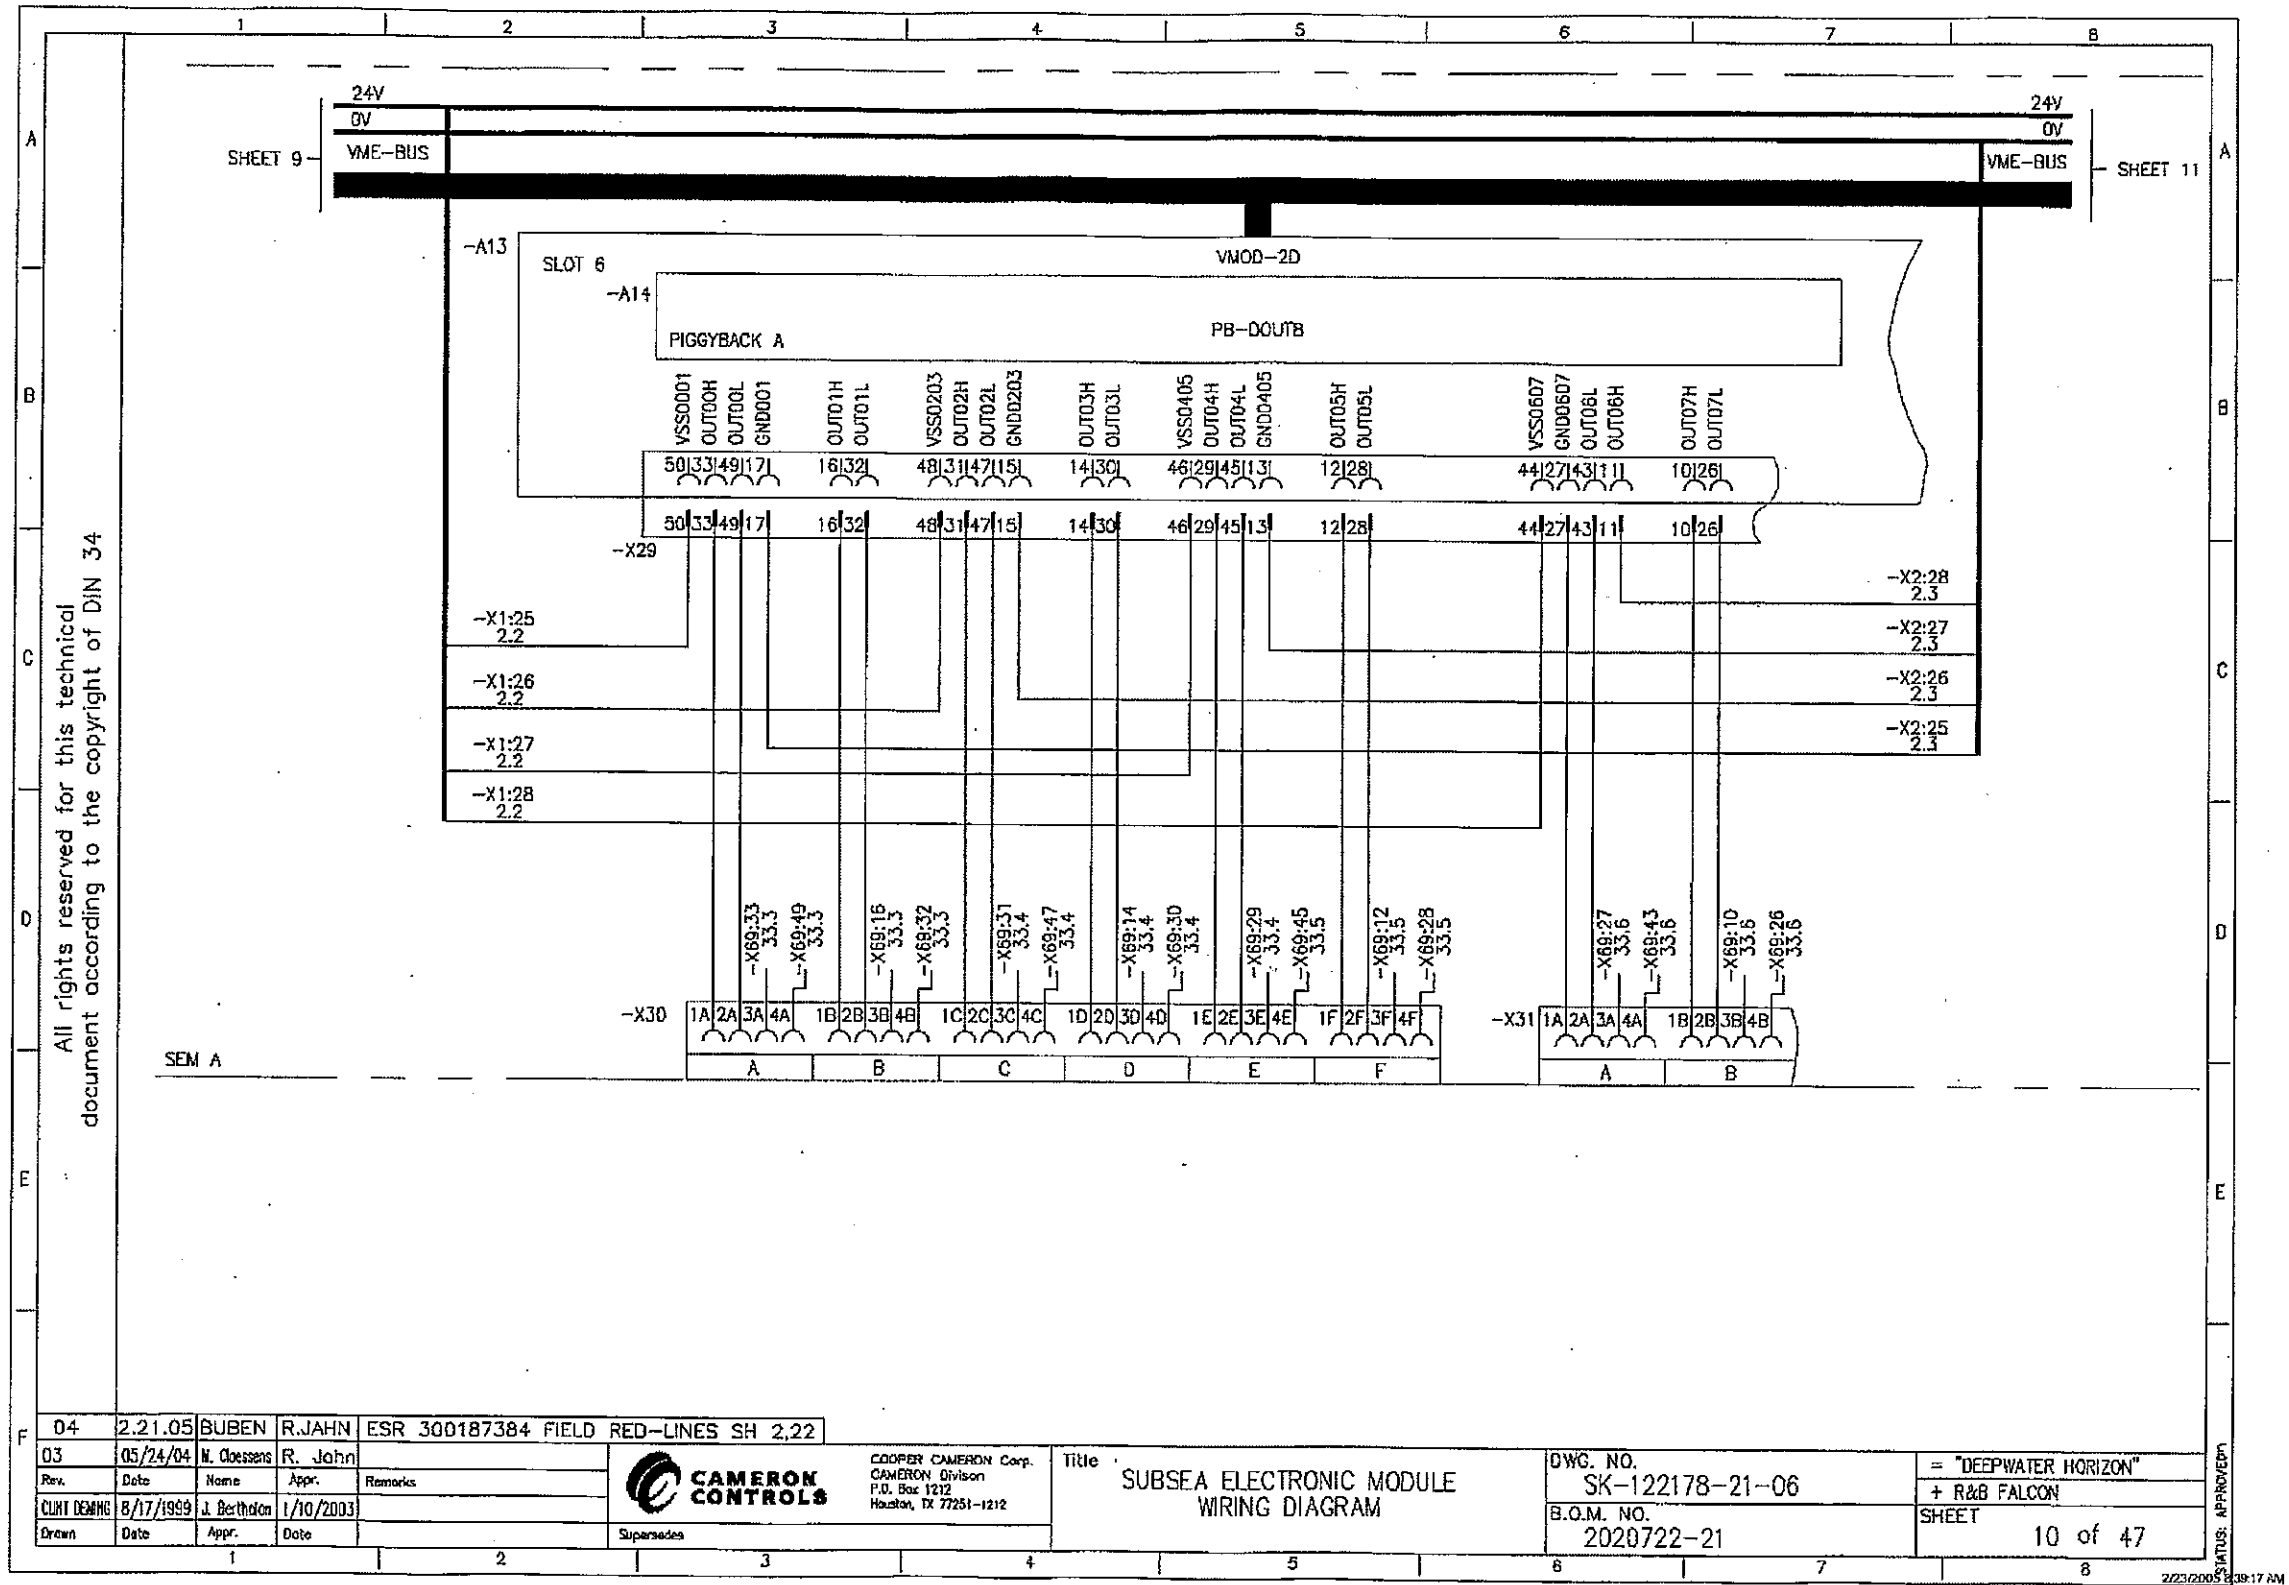


CONFIDENTIAL

TRN-MDL-00304724

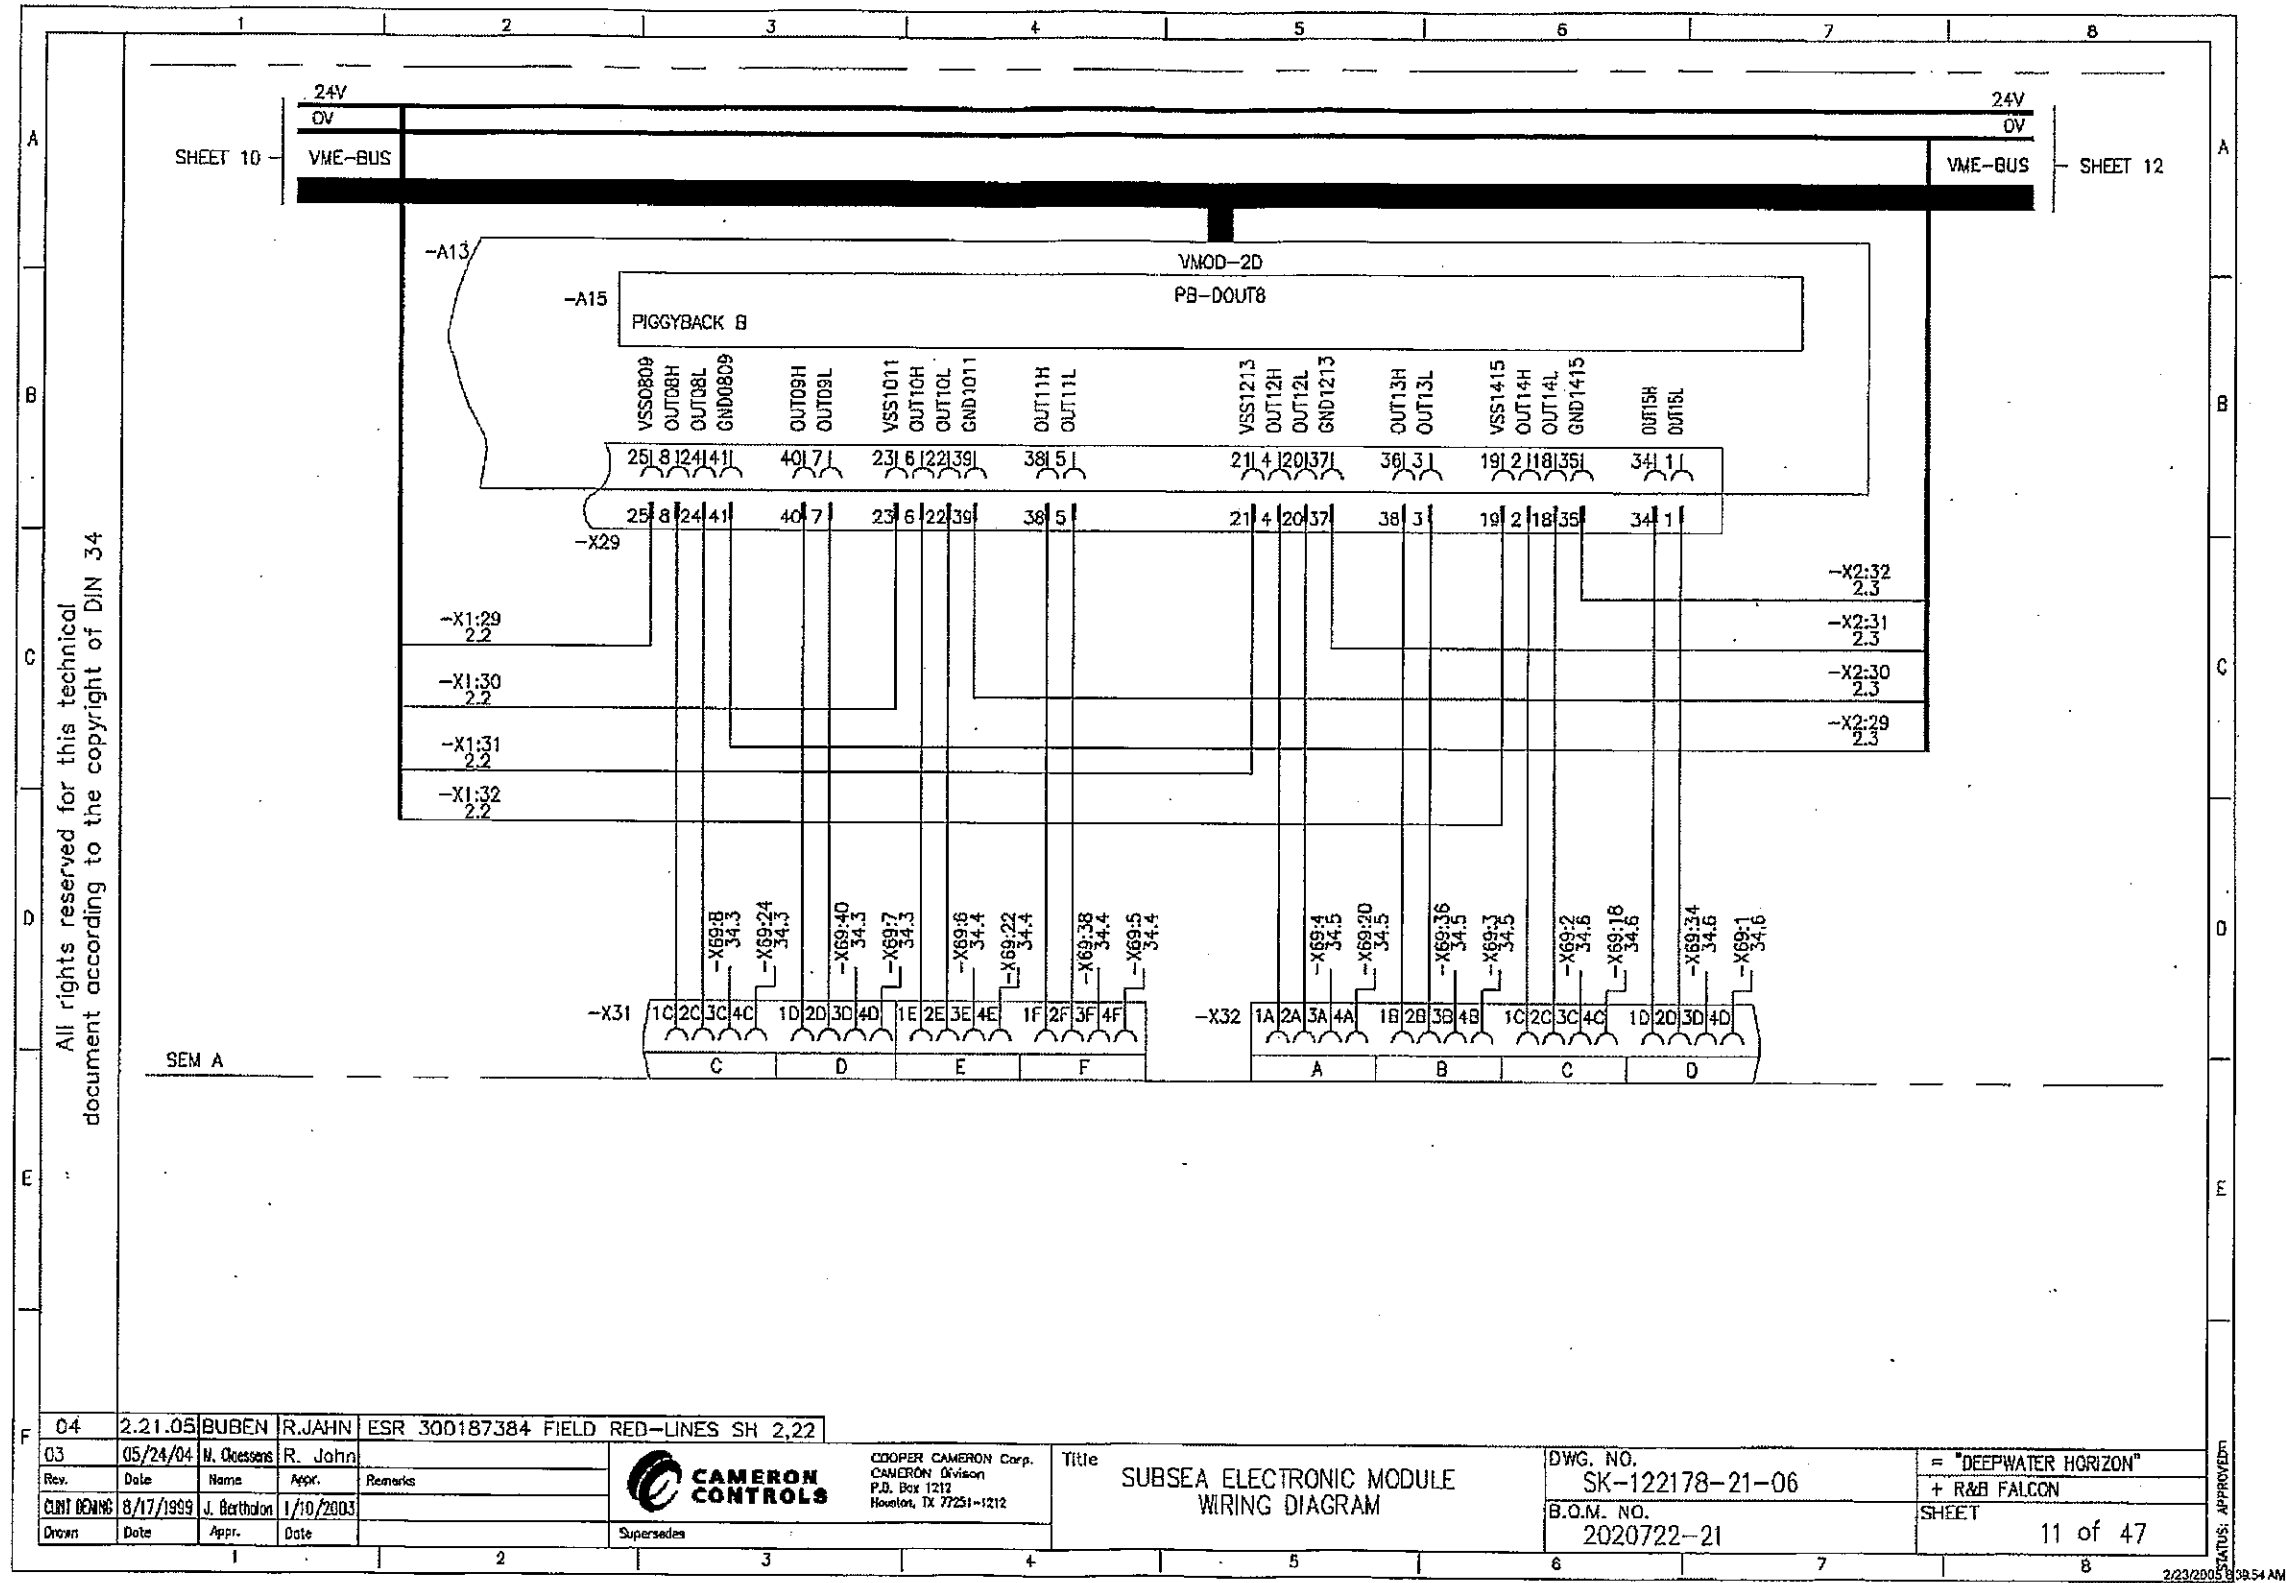


TRN-MDL-00304725

CONFIDENTIAL

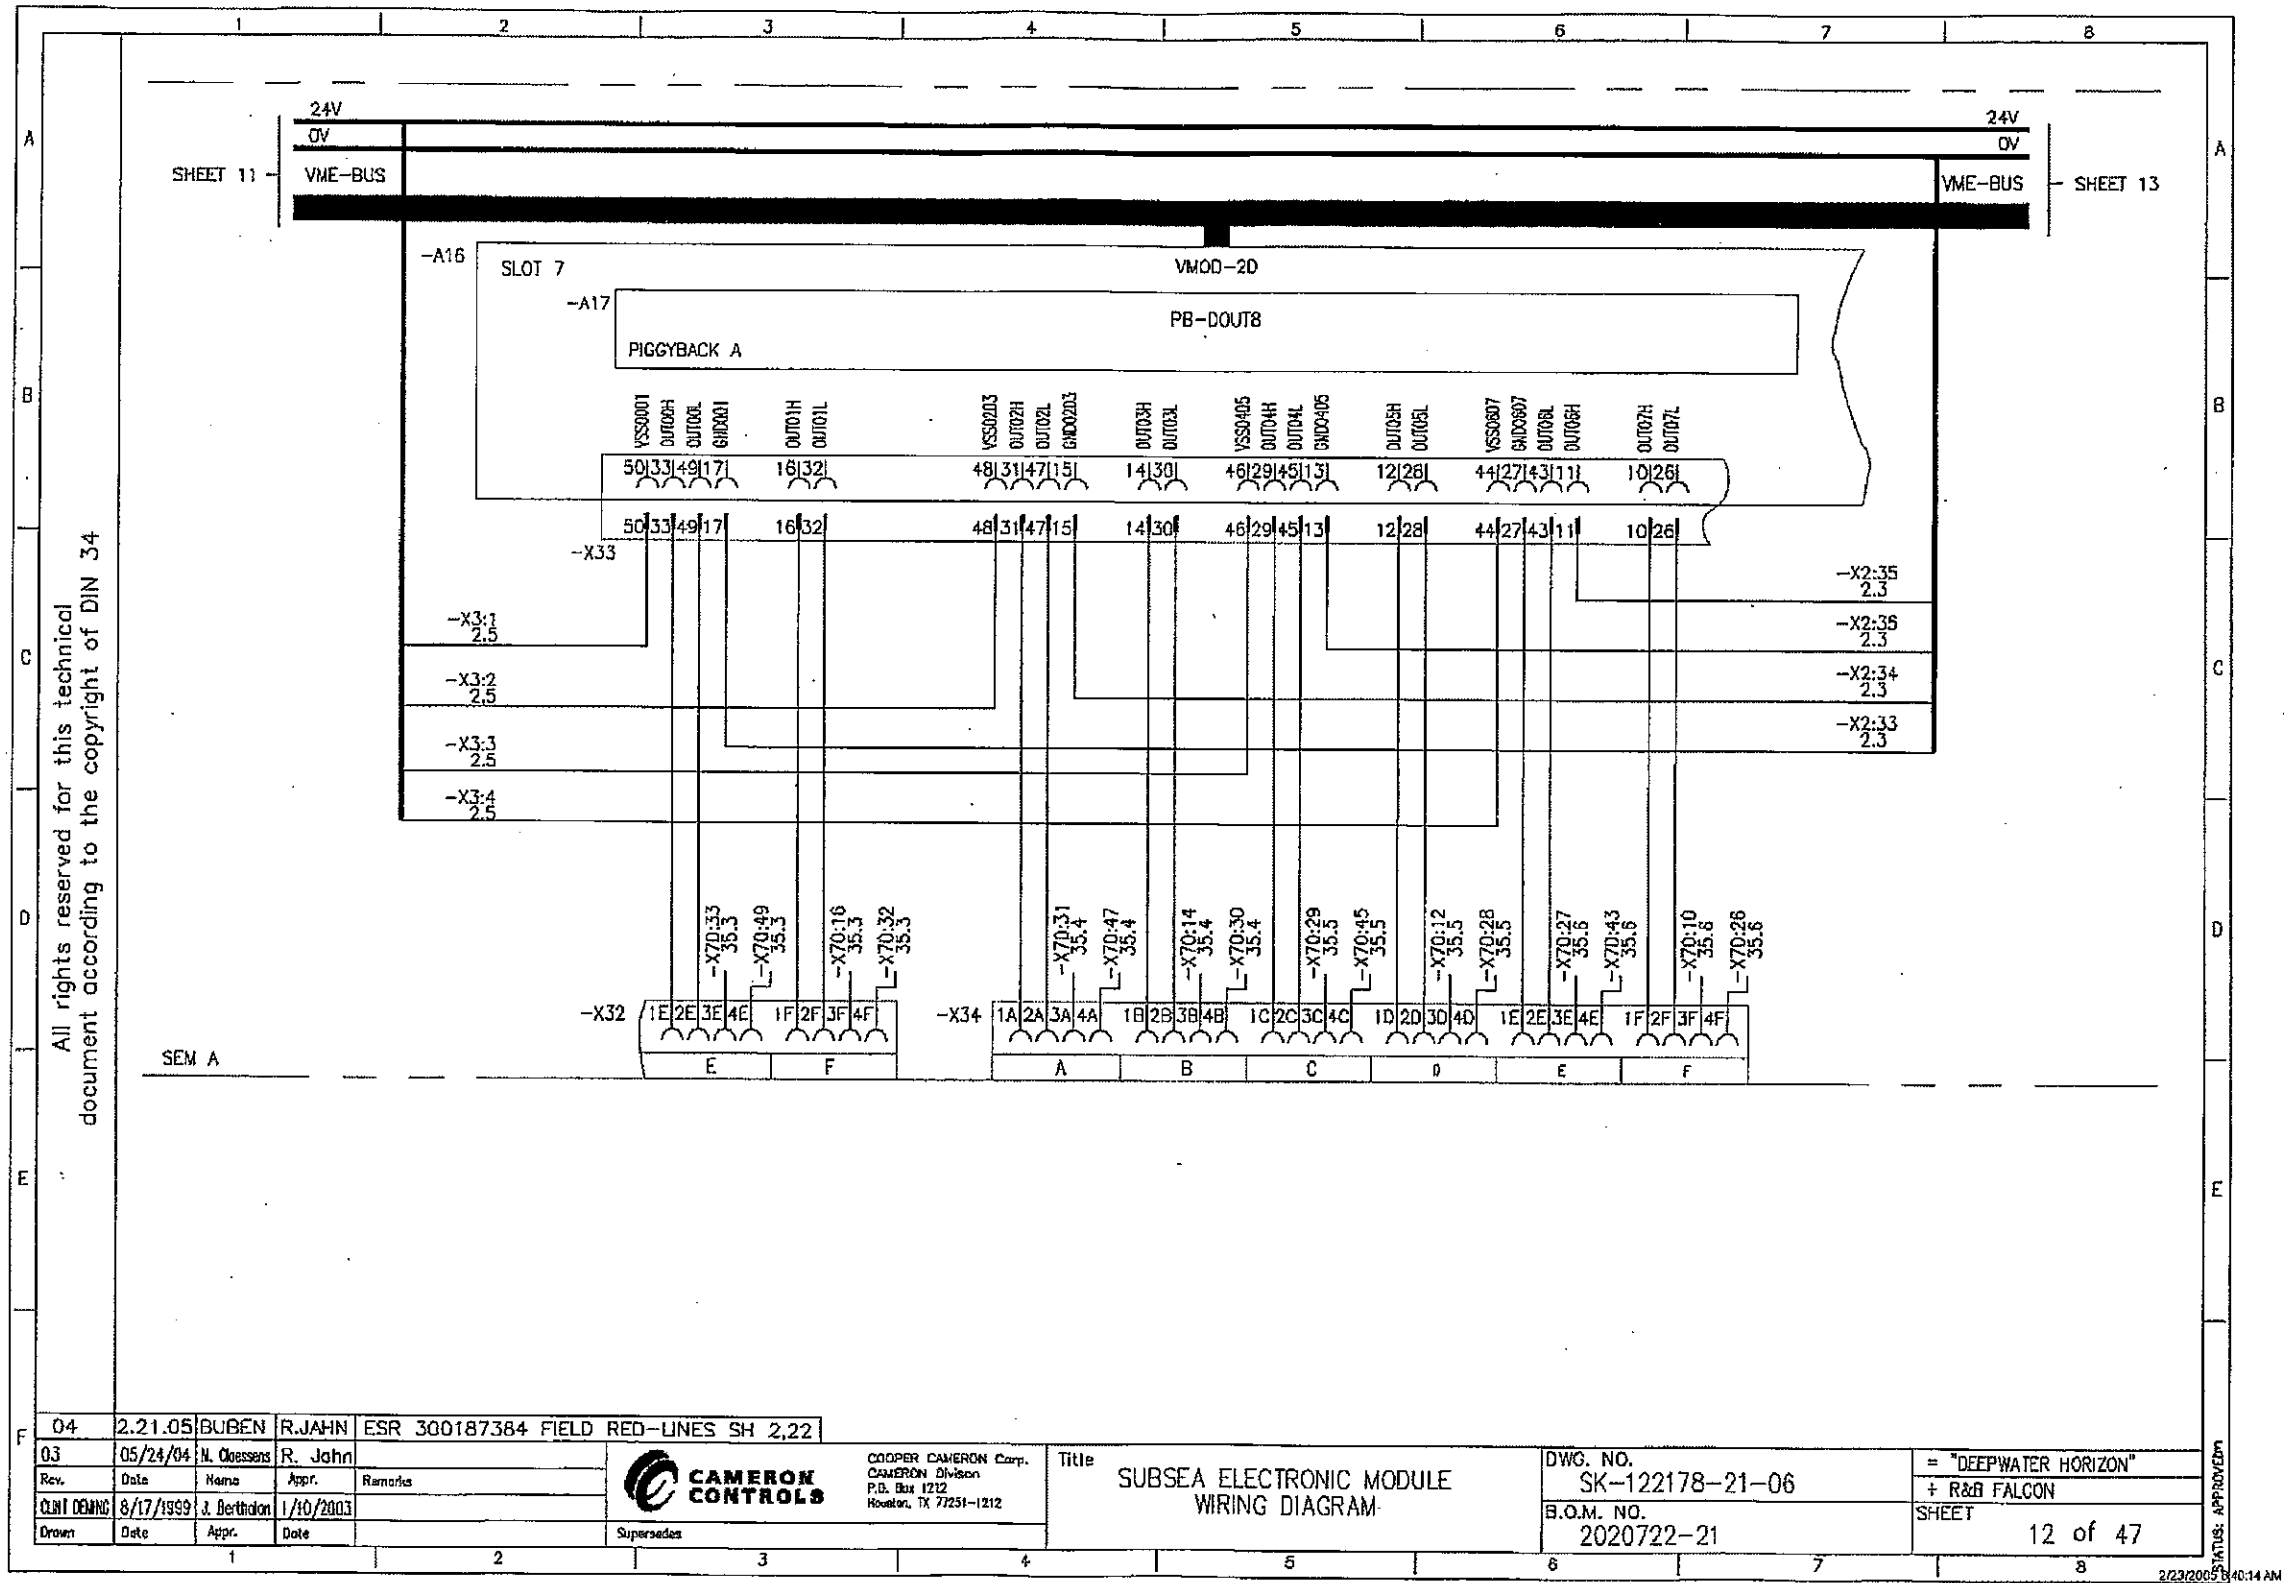

2/24/2005 11:22:07 AM SAP-CILMORED SK-122178-21-06.001.000.00.CURRENT_CCP100.TIF

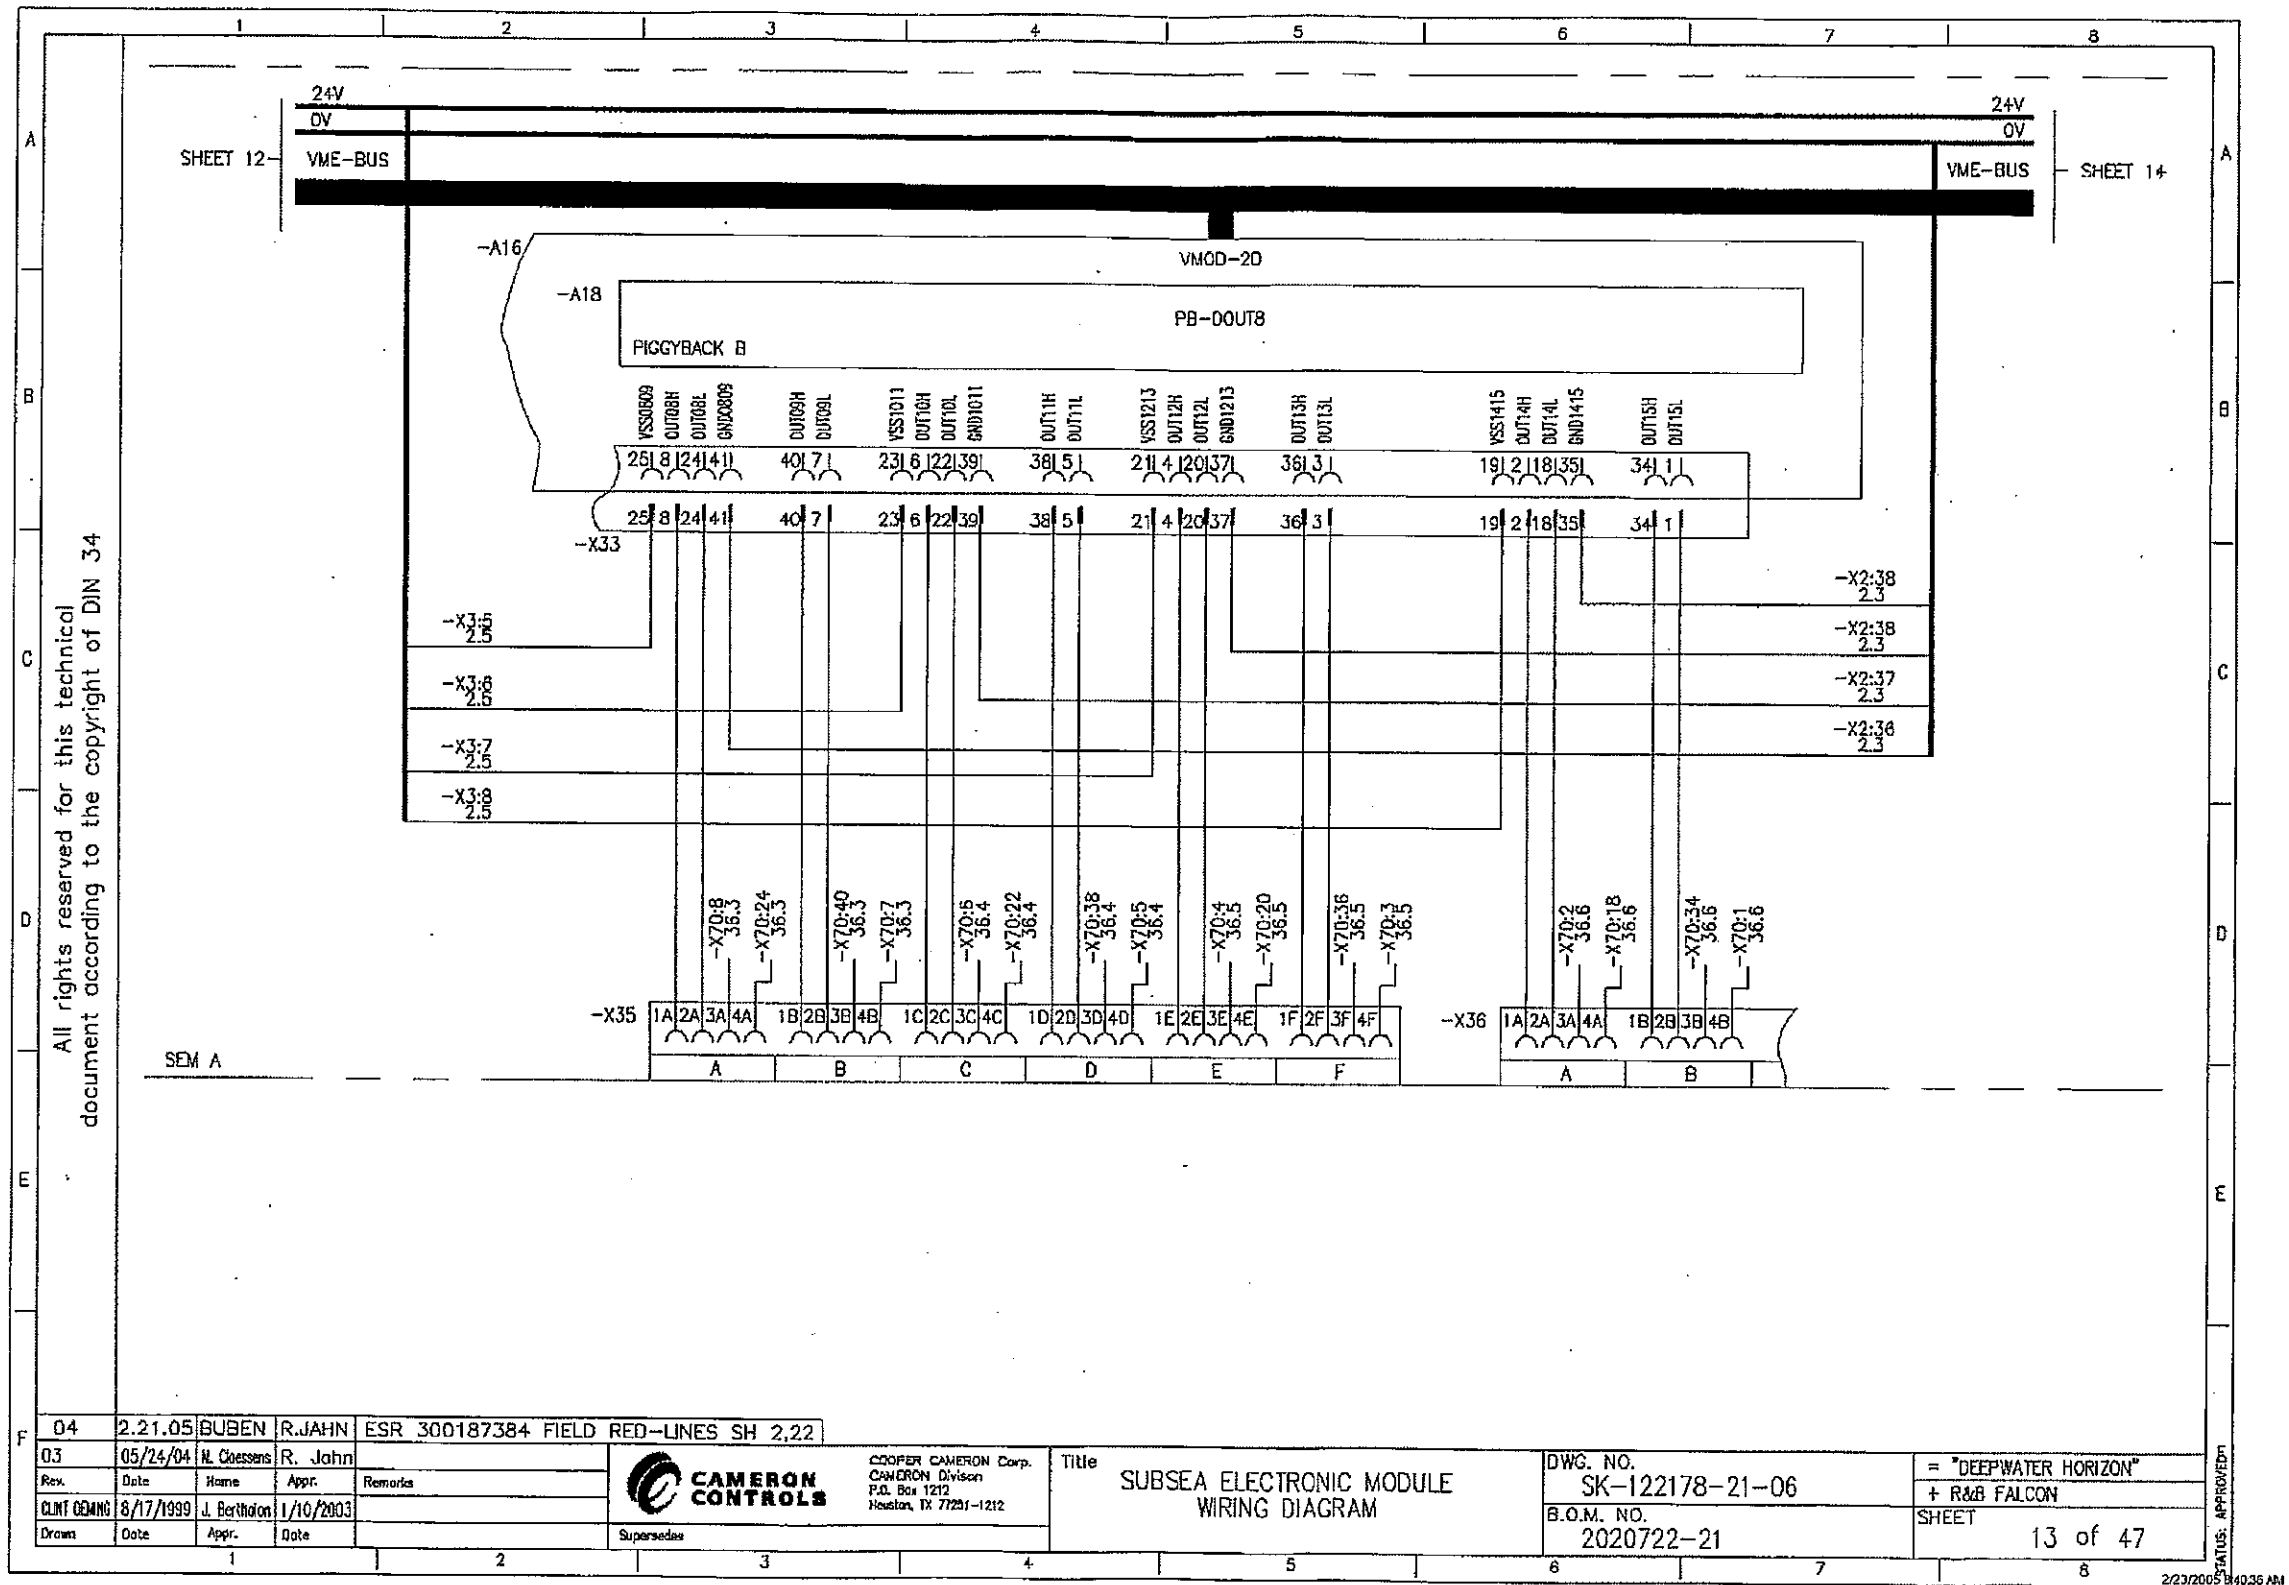


CONFIDENTIAL

TRN-MDL-00304727




2/24/2005 11:22:07 AM SAP-GILMORED SK-122178-21-06.001.000.00.CURRENT_COP100.TIF

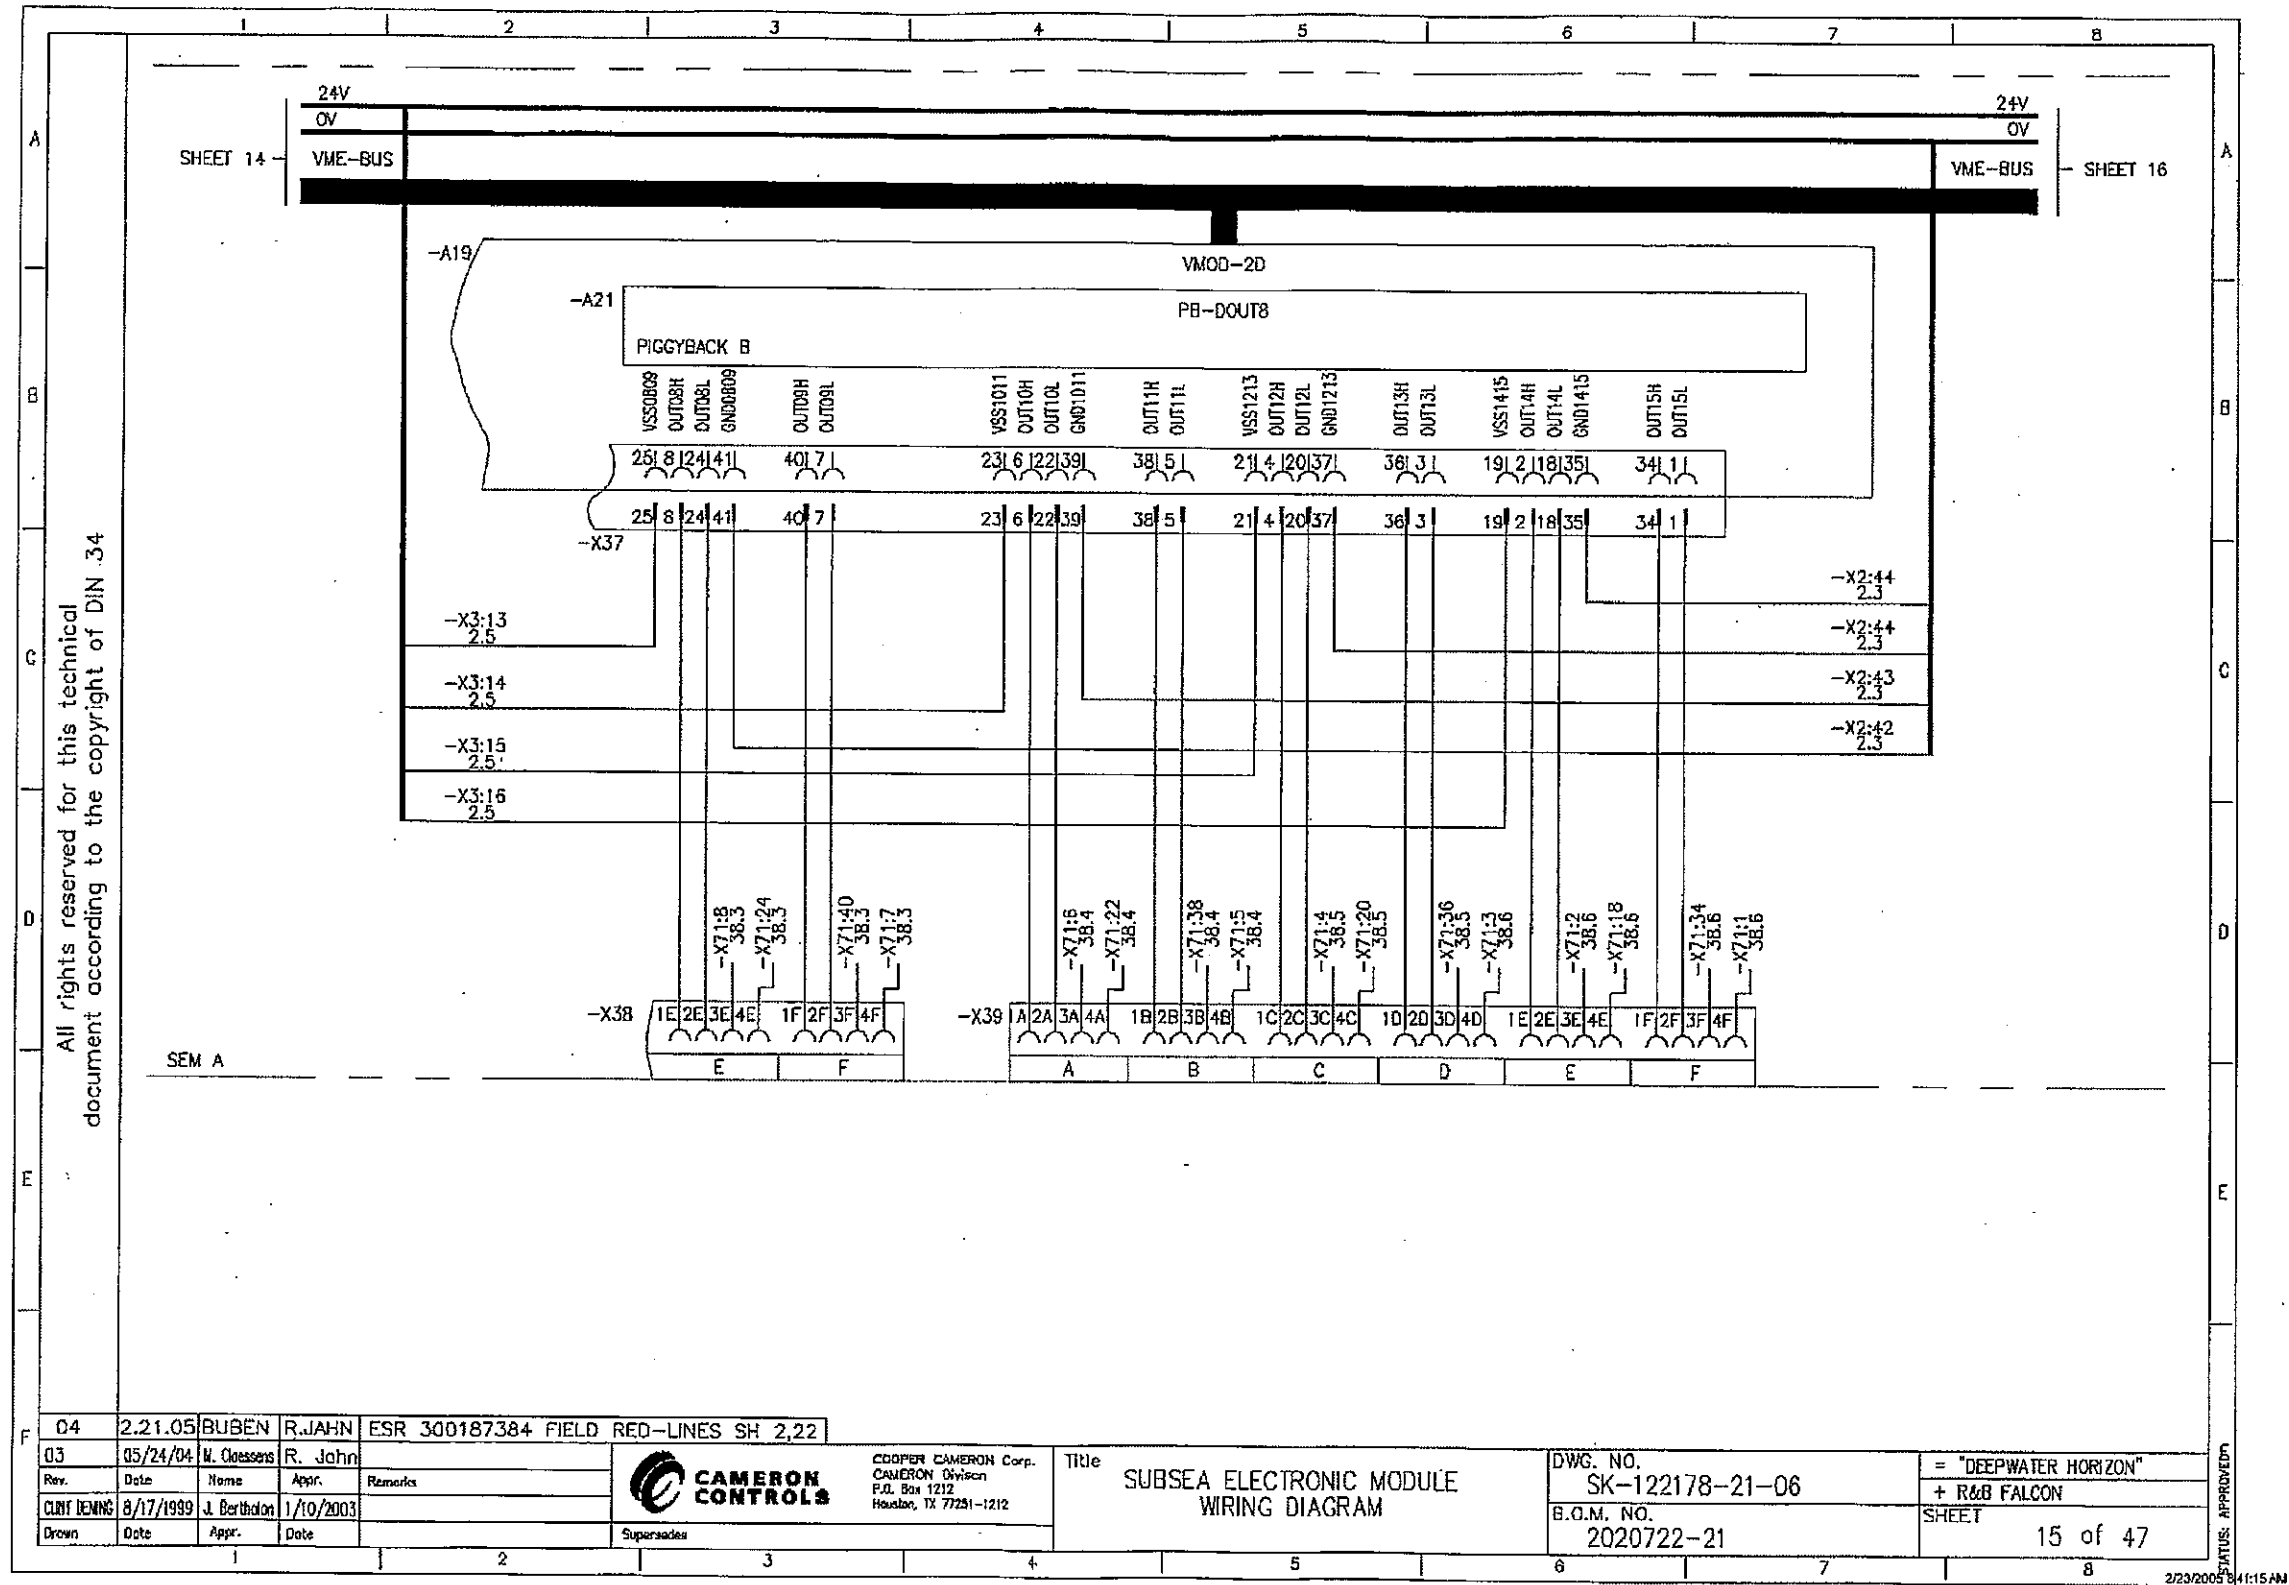

CONFIDENTIAL

TRN-MDL-00304729


2/24/2005 11:22:07 AM SAP-GILMORED SK-122178-21-06_001.000_00_CURRENT_CCP100.TIF

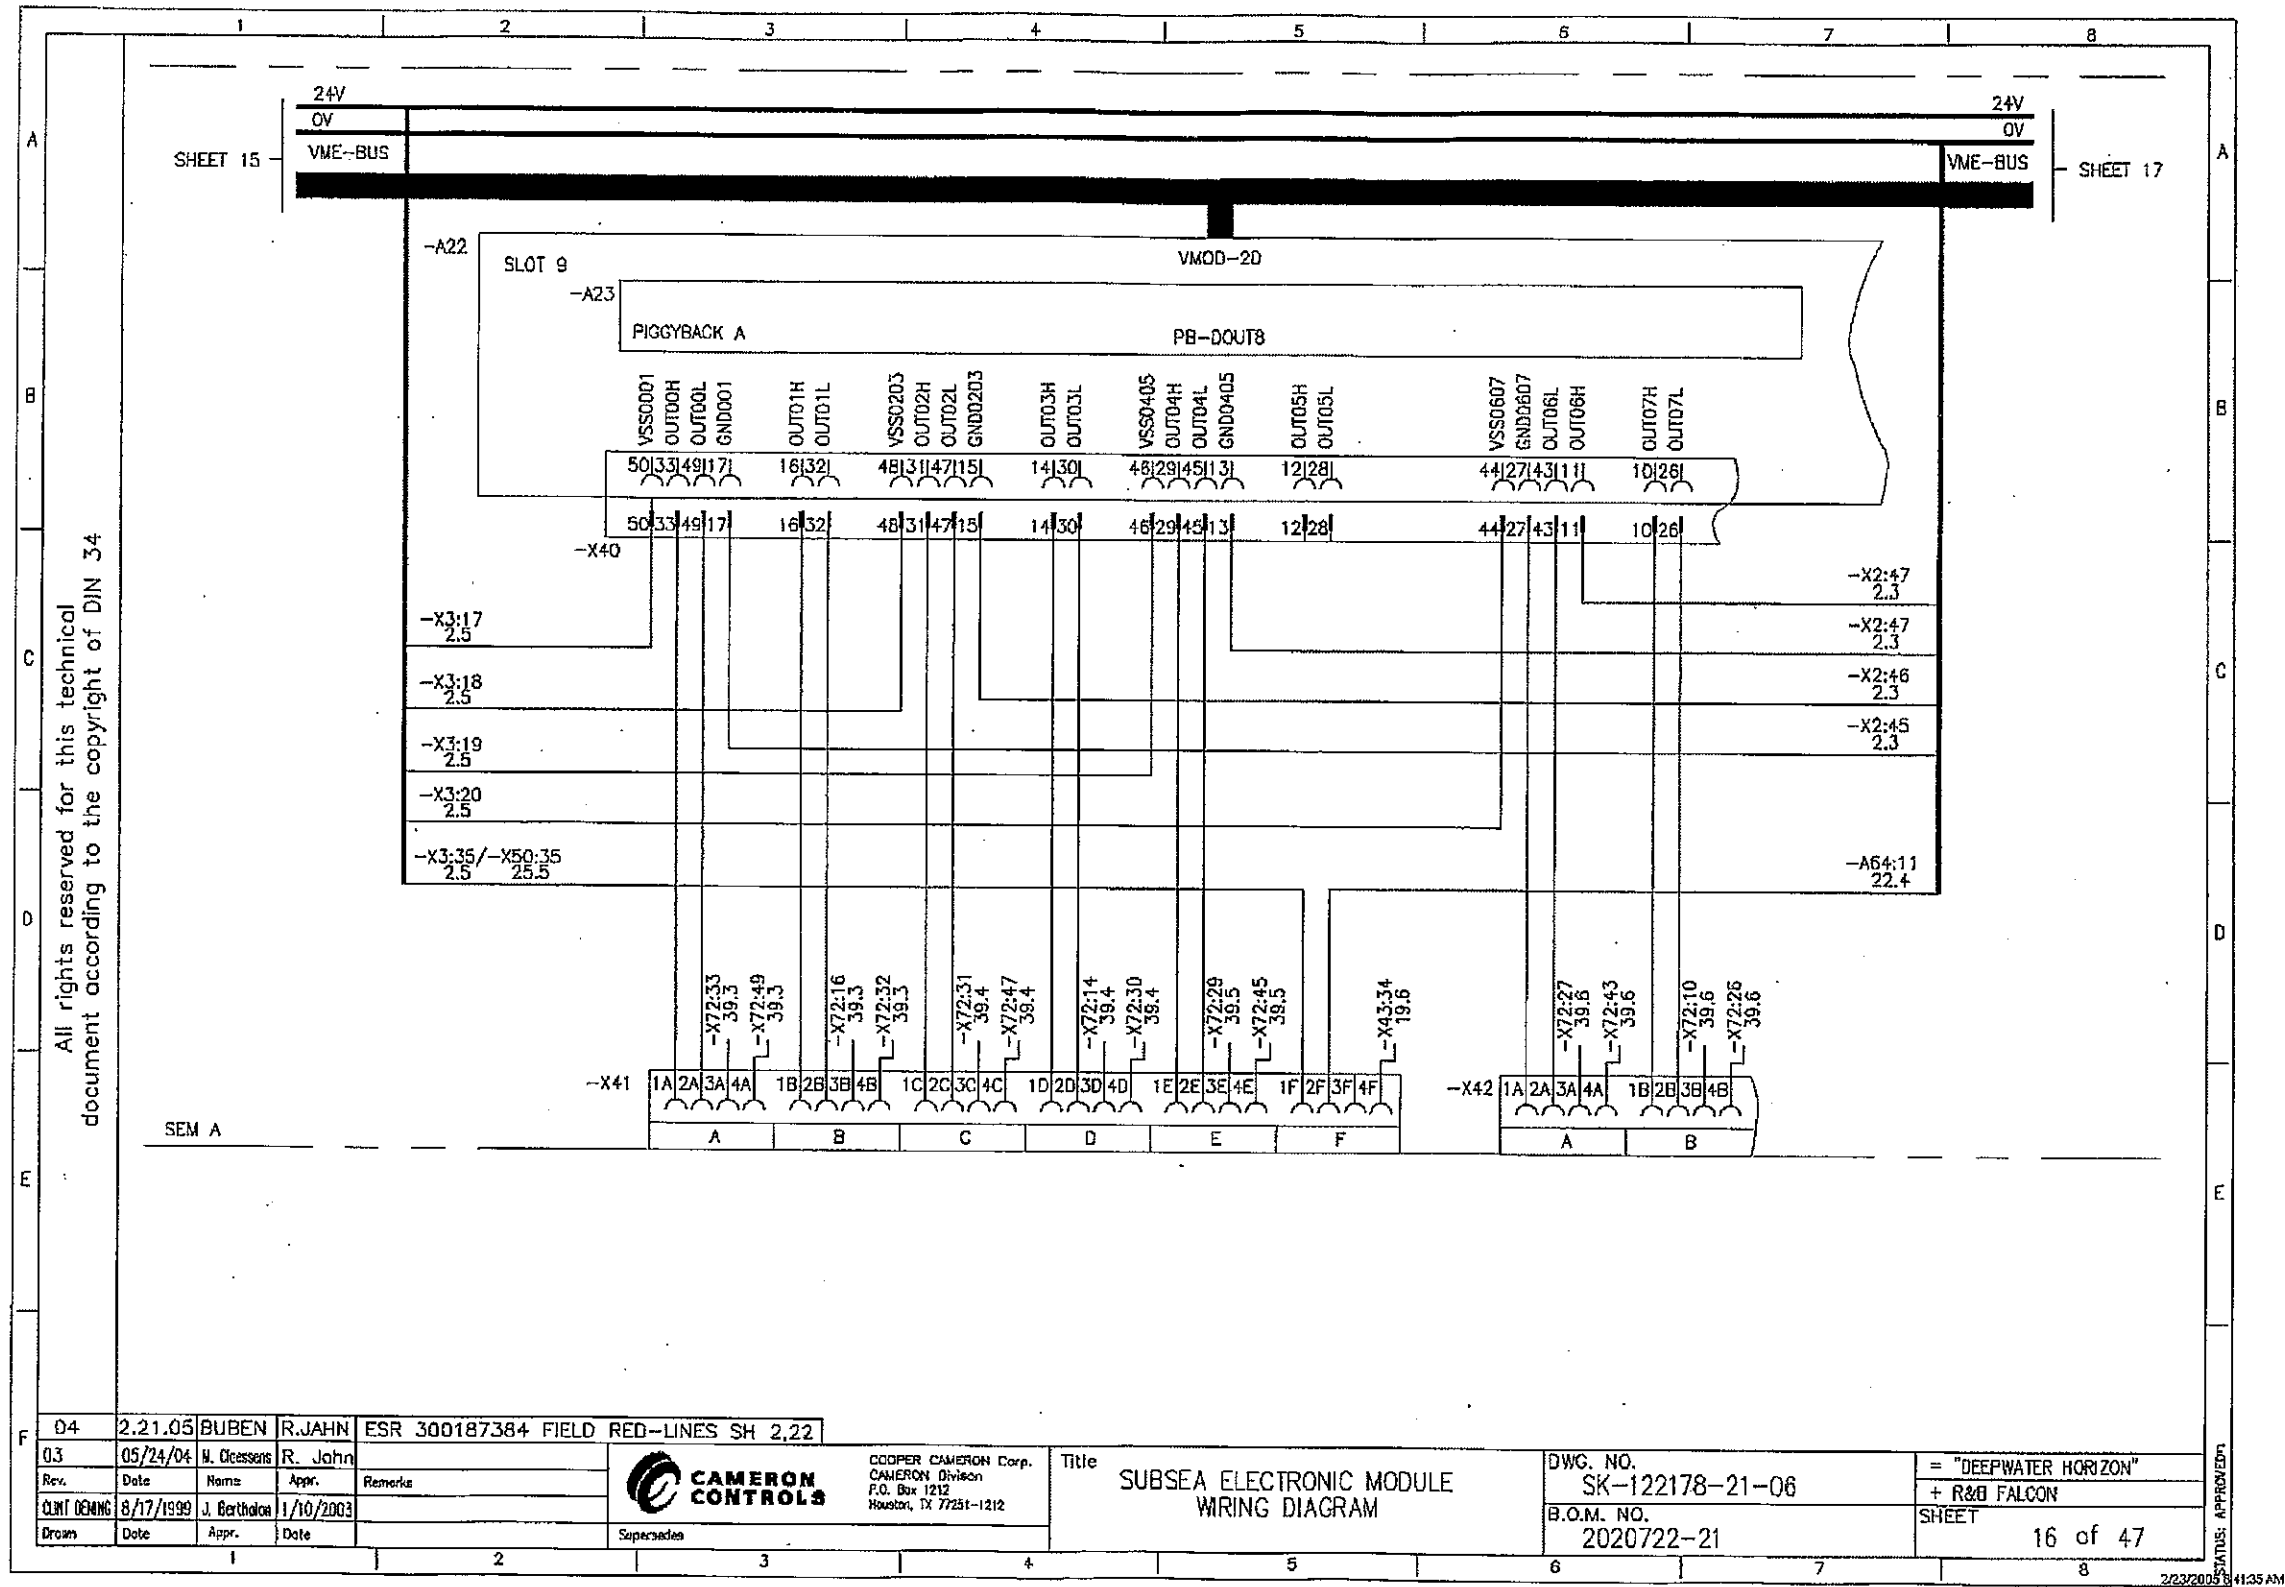

TRN-MDL-00304730

CONFIDENTIAL


2/24/2005 11:22:07 AM SAP-GILMORED SK-122178-21-06_001_000_00_CURRENT_COPY000.TIF

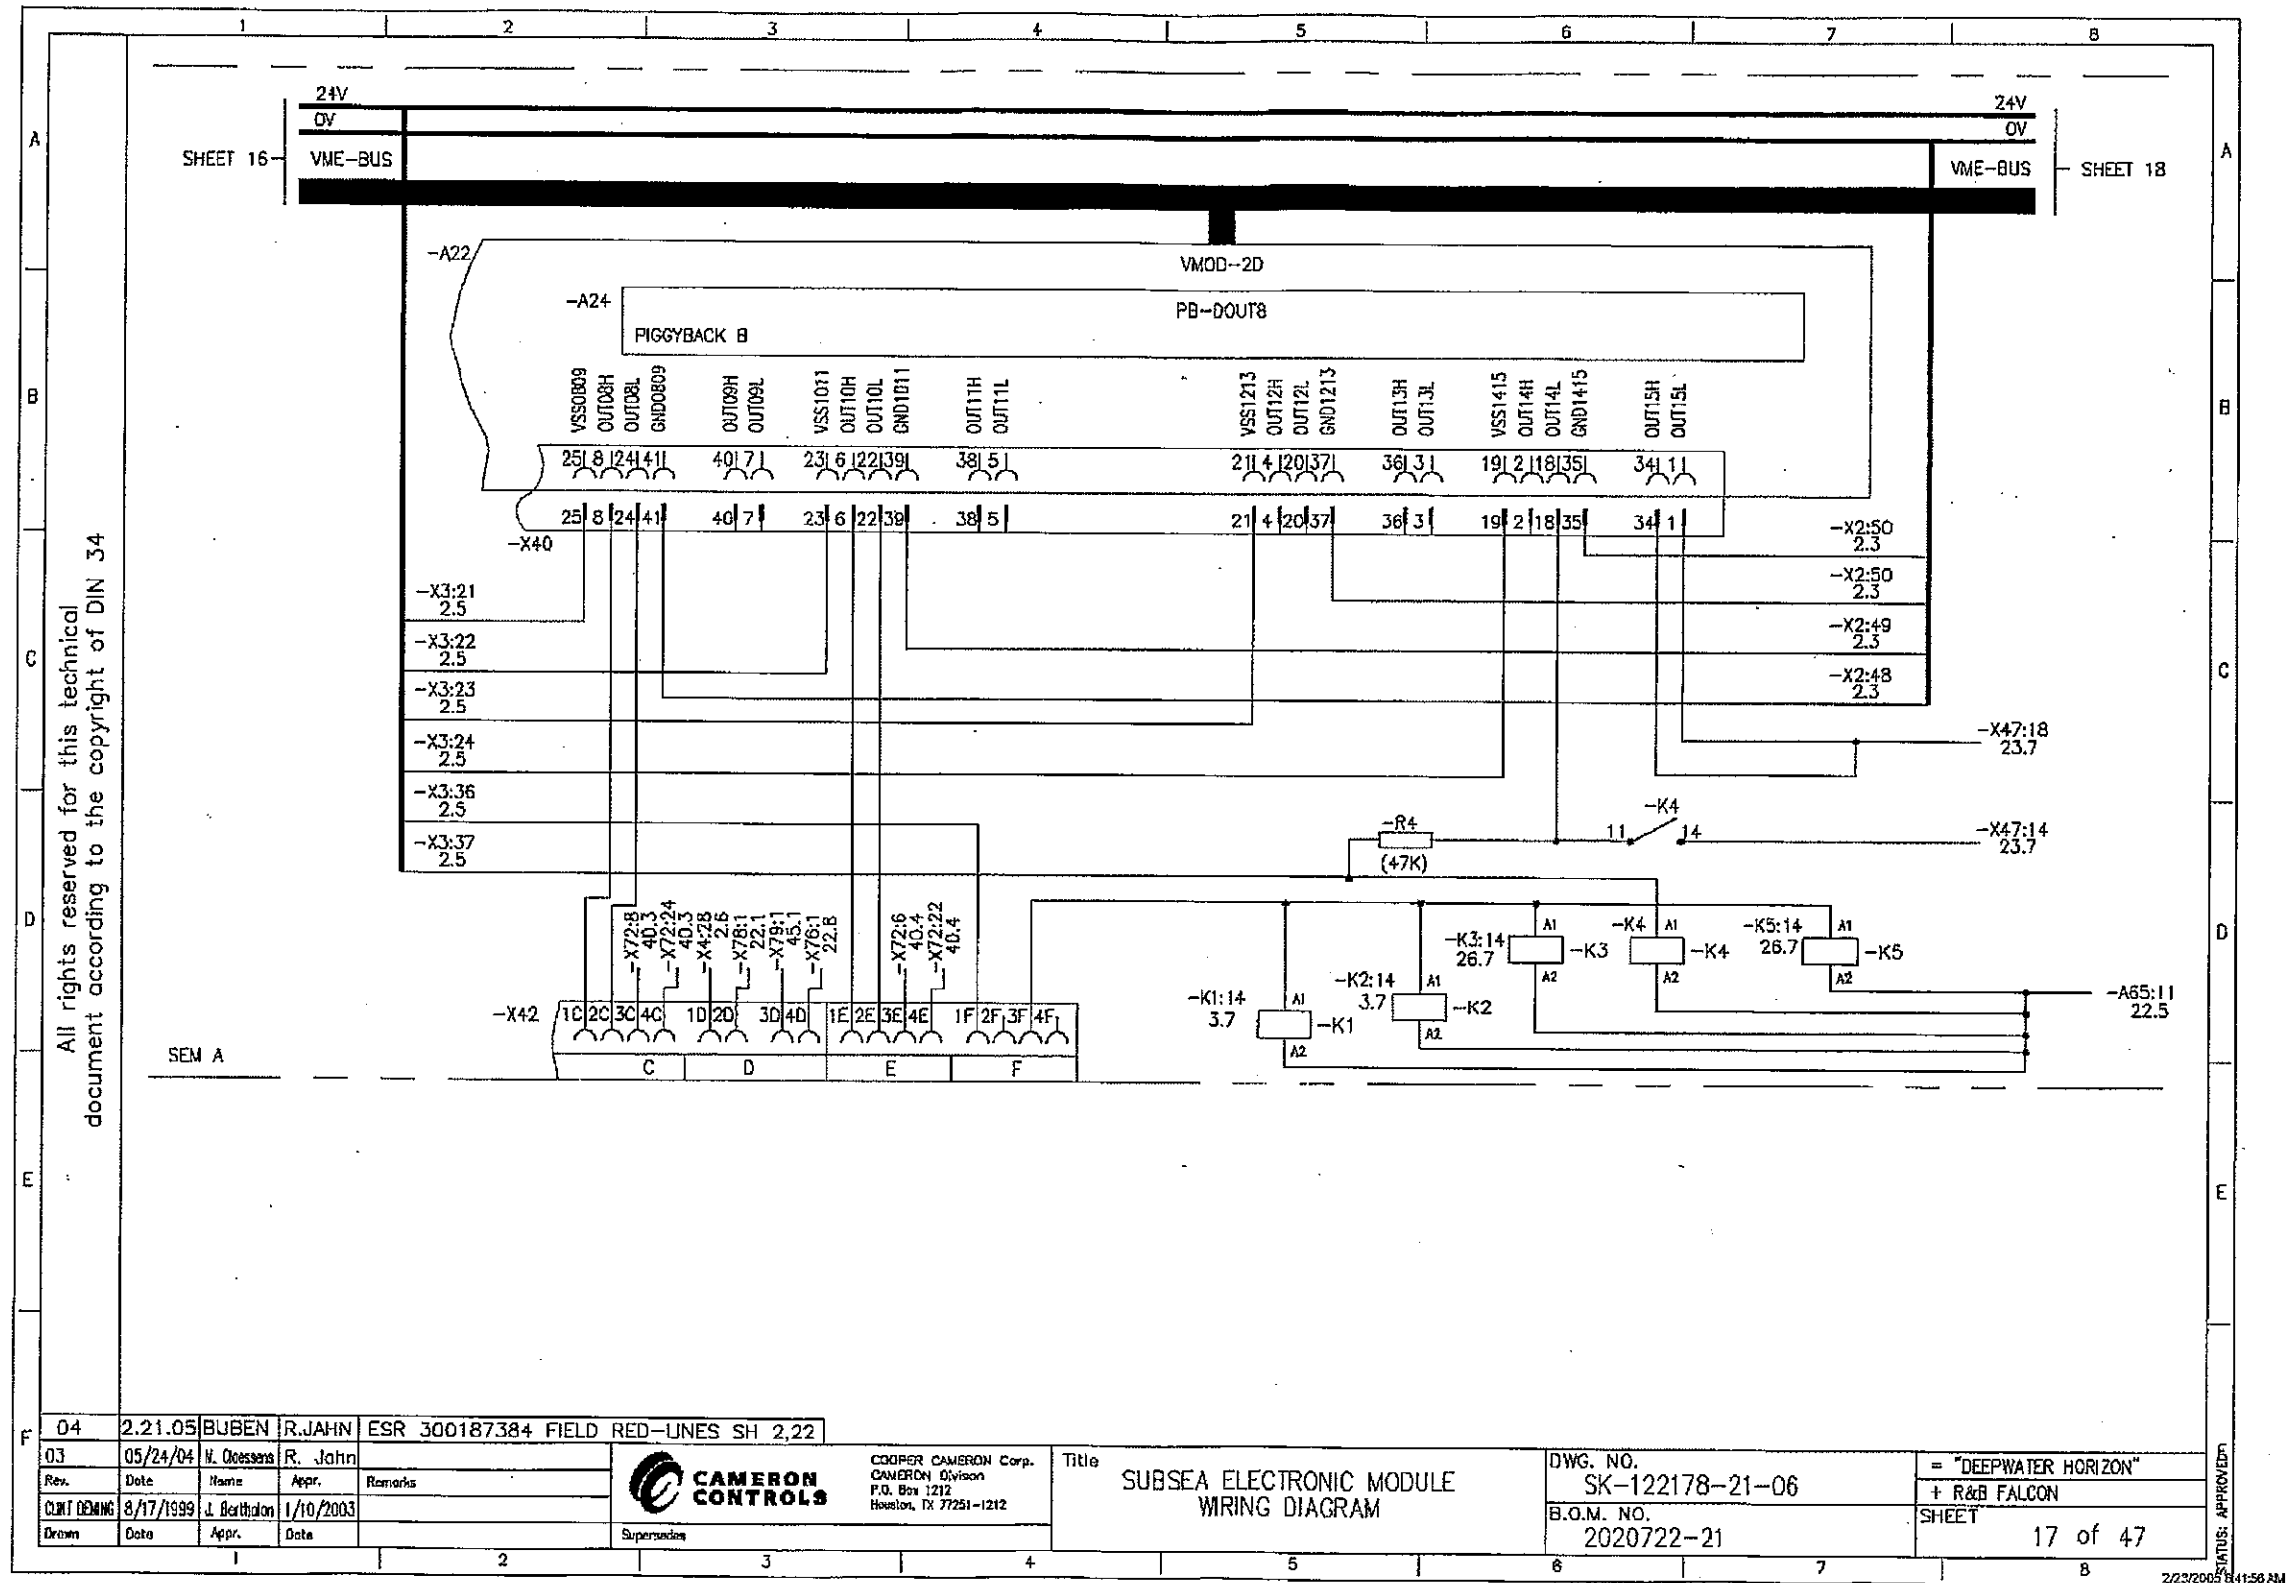

CONFIDENTIAL

TRN-MDL-00304731


2/24/2005 11:22:07 AM SAP-GILMORED SK-122178-21-06_001_000_00_CURRENT_DCP100.TIF

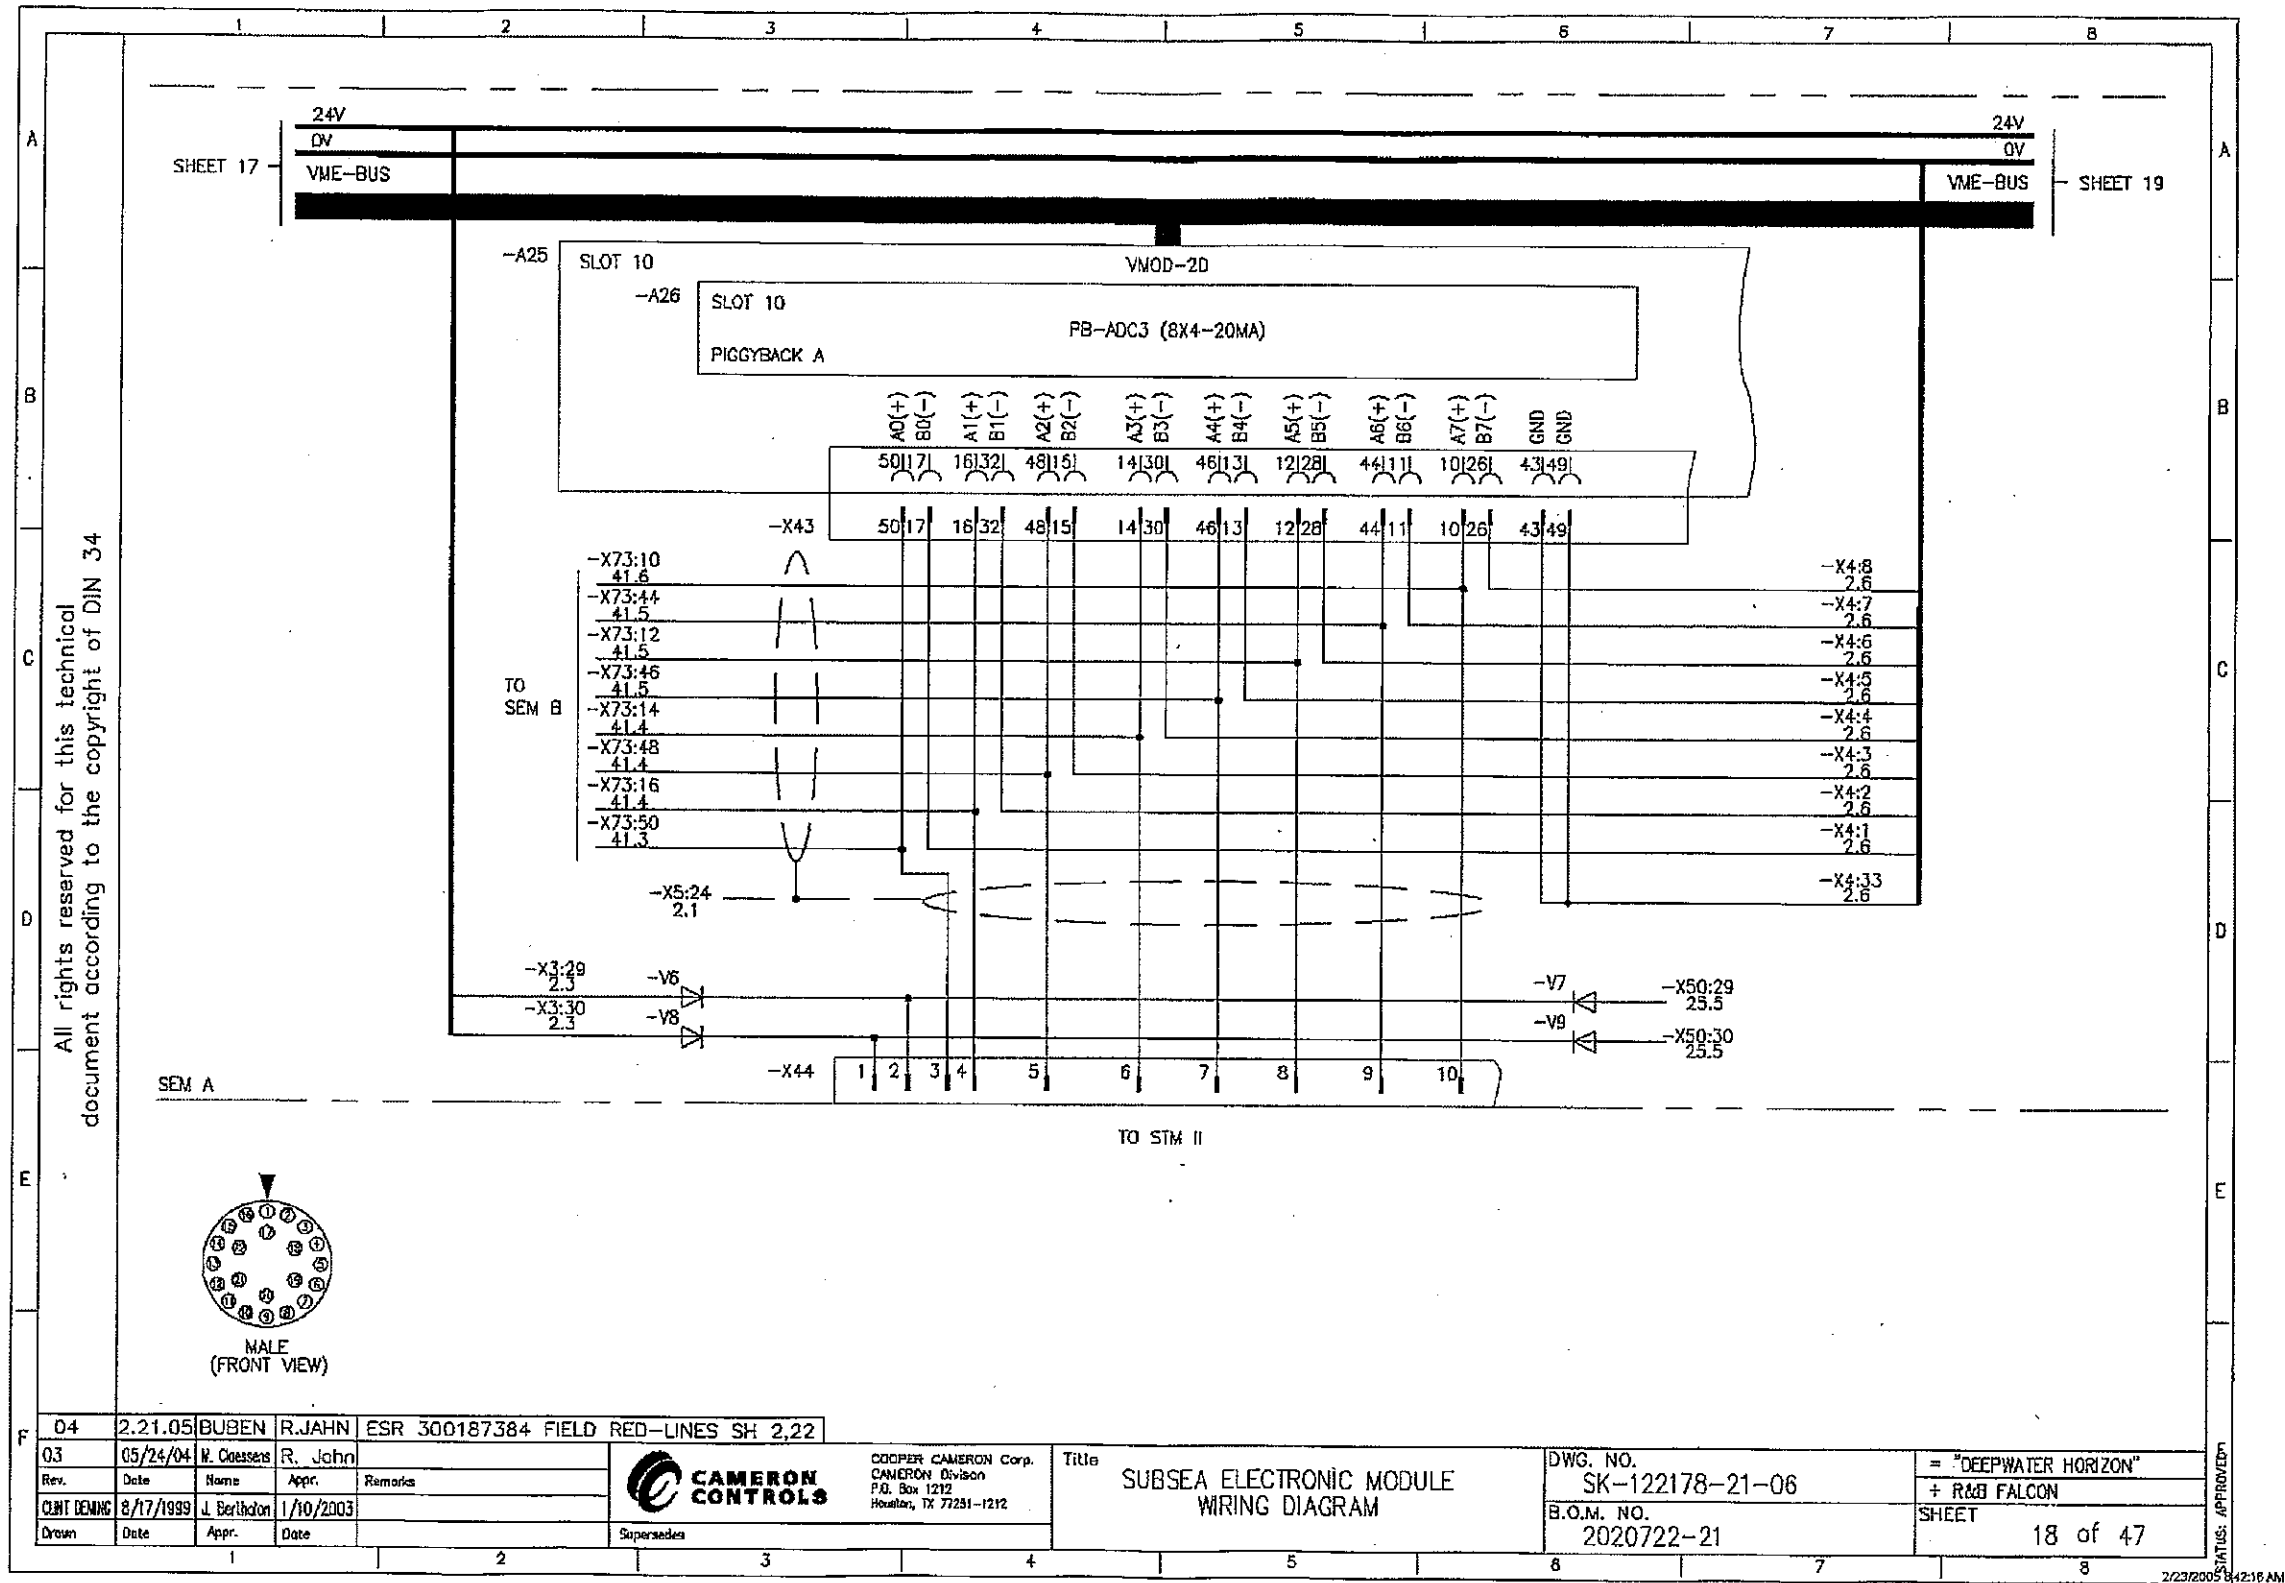

CONFIDENTIAL

TRN-MDL-00304732


2/24/2005 11:22:07 AM SAP-GILMORED SK-122178-21-06_001_000_00_CURRENT_COP100.TIF

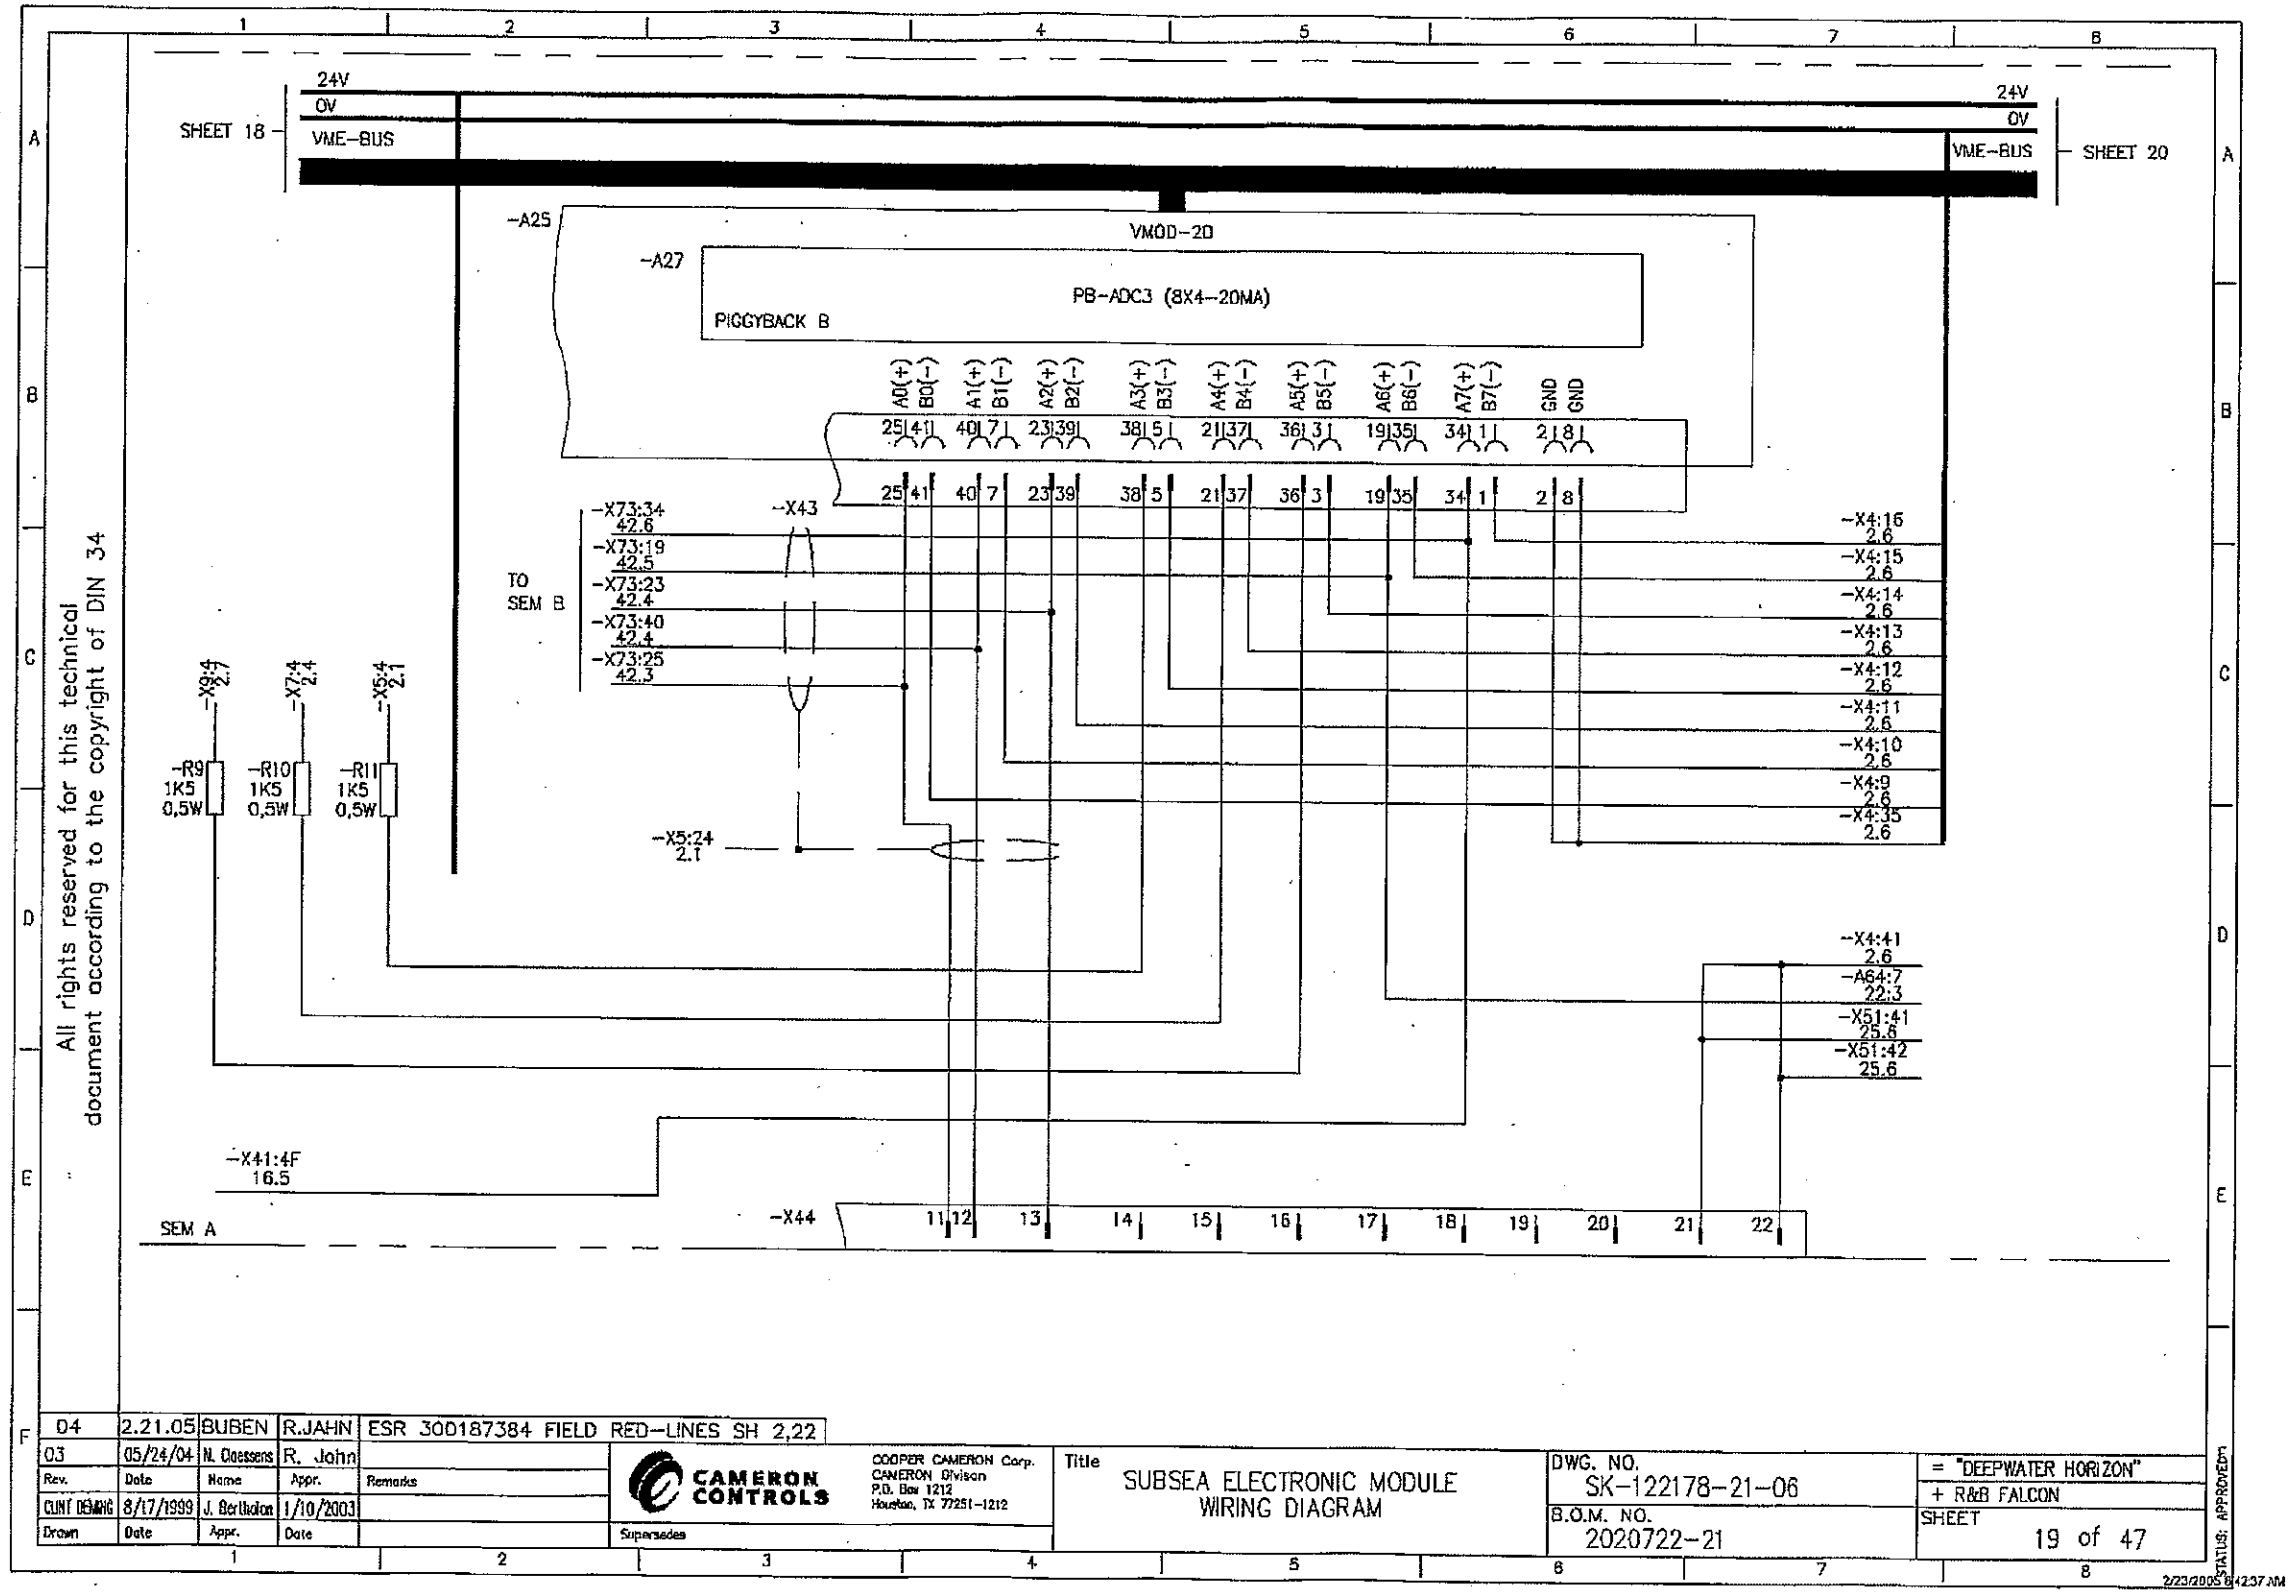

CONFIDENTIAL

TRN-MDL-00304733


2/24/2005 11:22:07 AM SAP-GILMORED SK-122178-21-06_001_000_00_CURRENT_CCP100.TIF

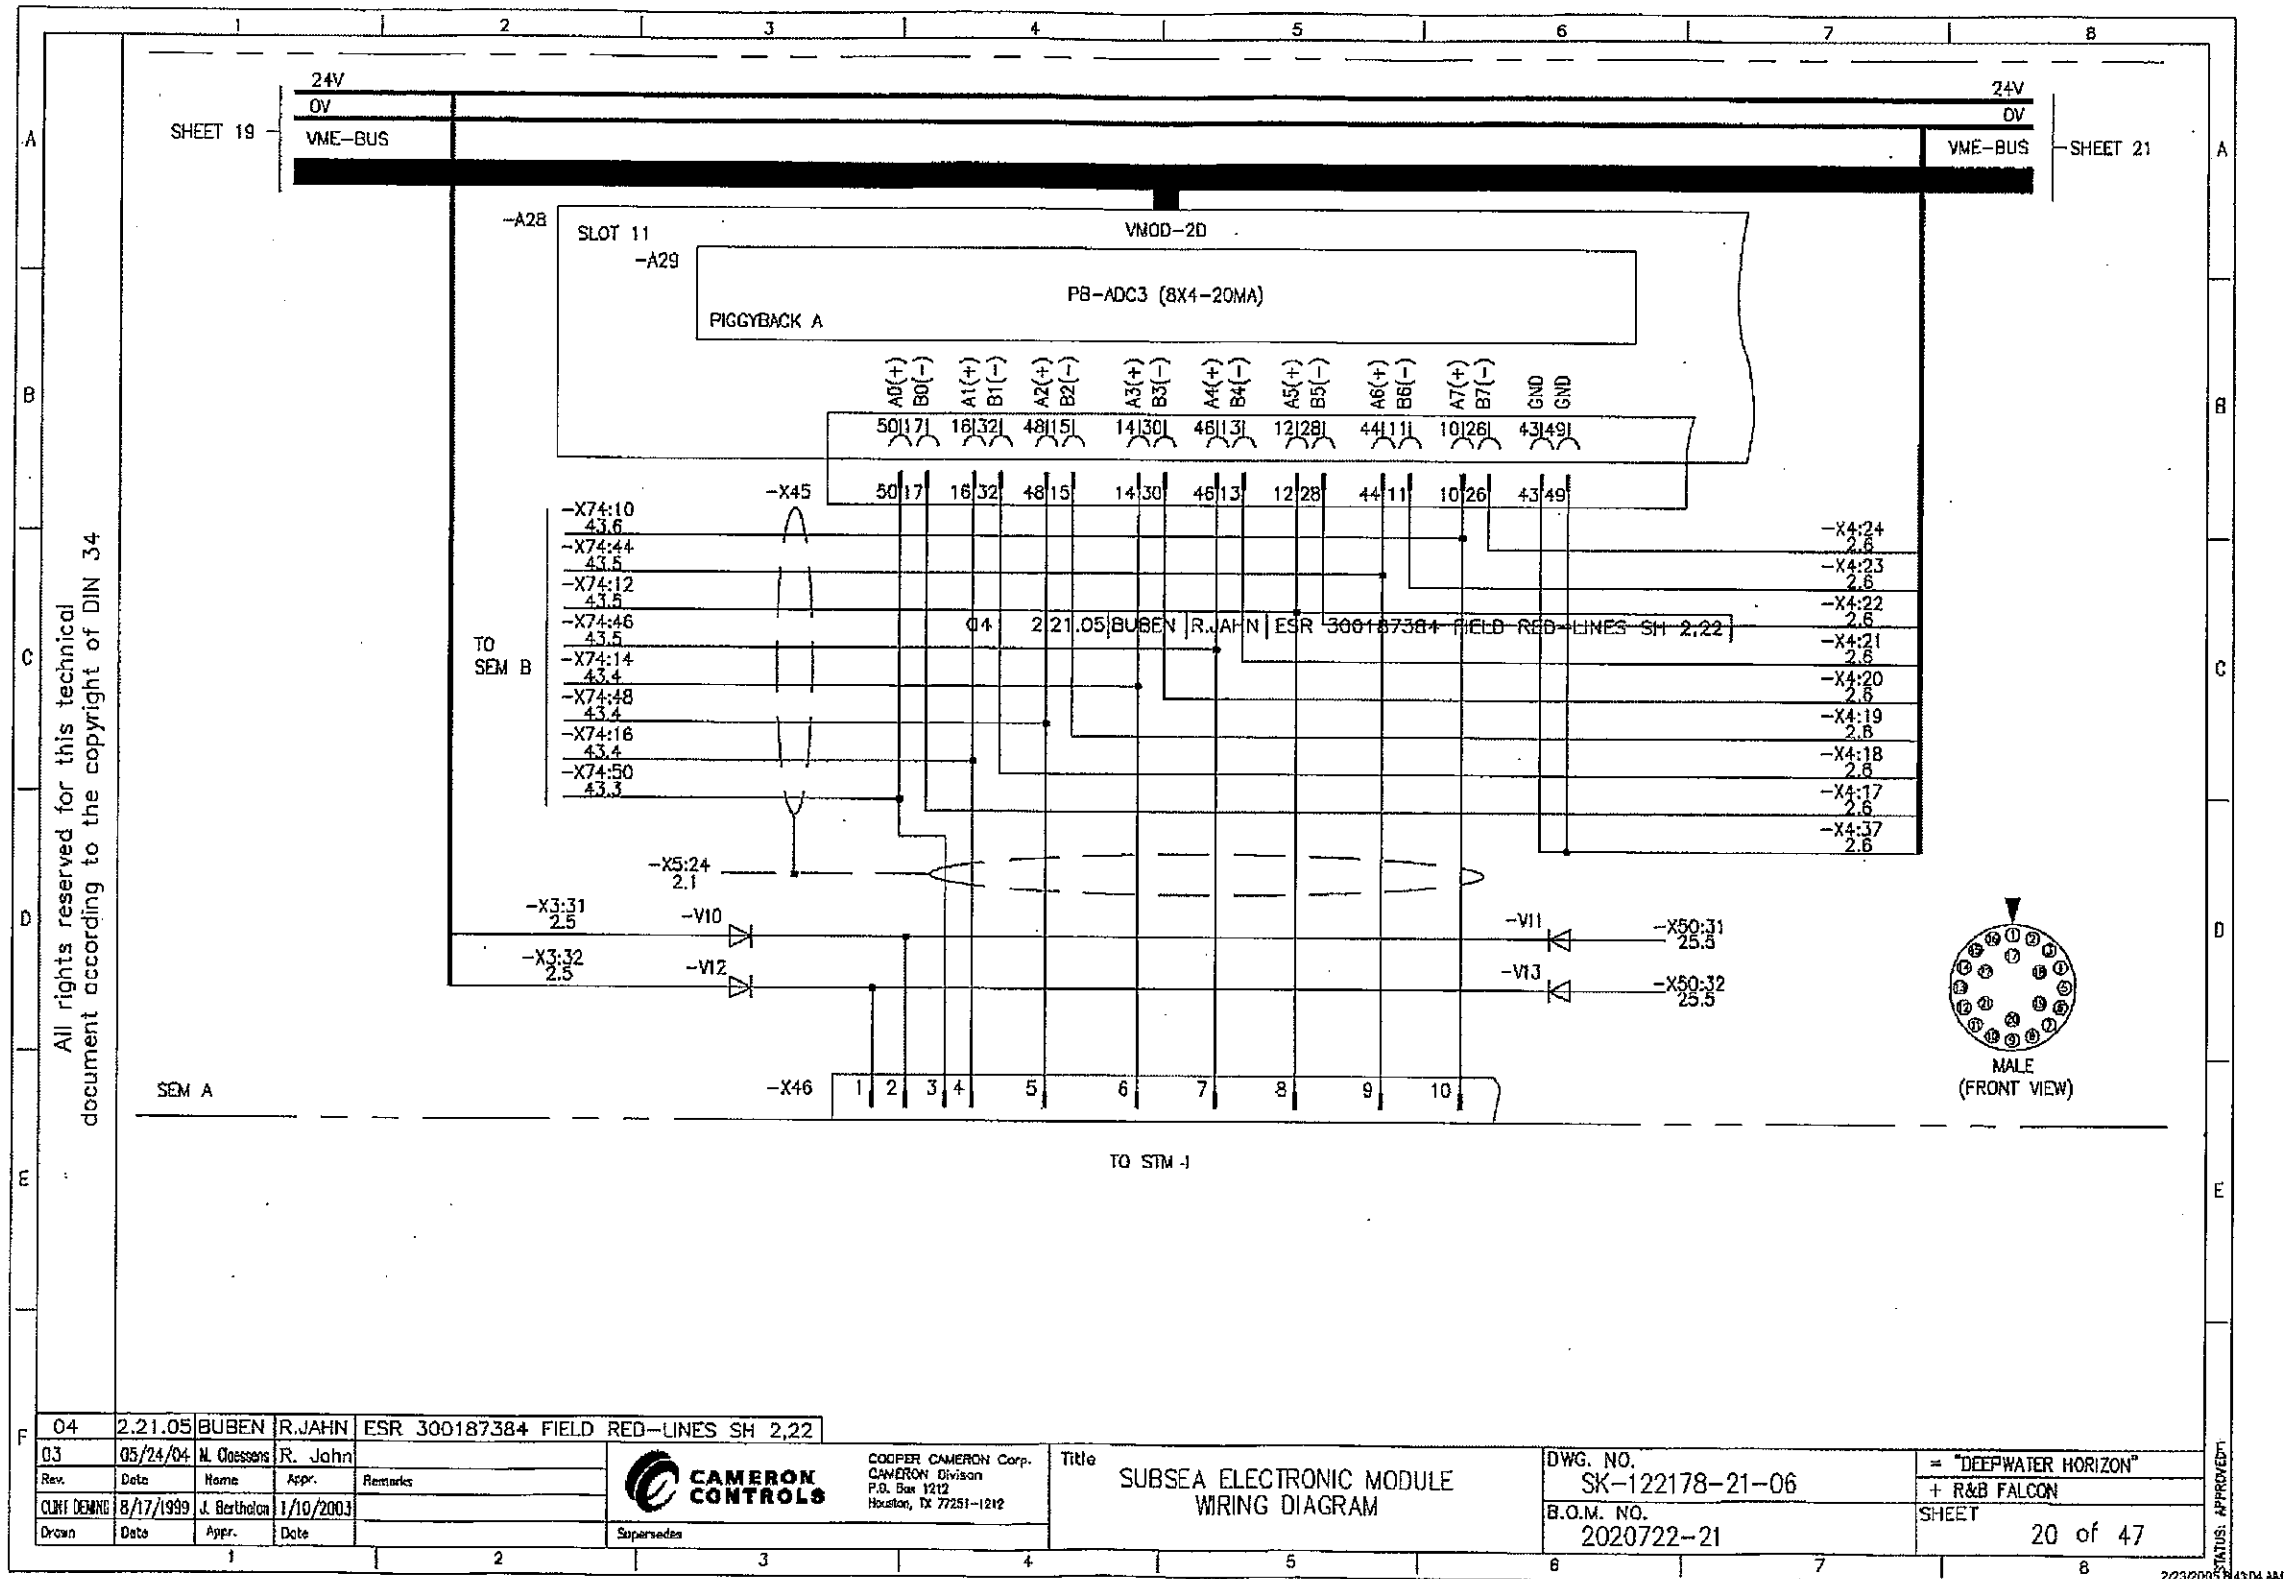

CONFIDENTIAL

TRN-MDL-00304734


2/24/2005 11:22:07 AM SAP-CILMORED SK-122178-21-06.001.000.00_CURRENT_COP100.TIF

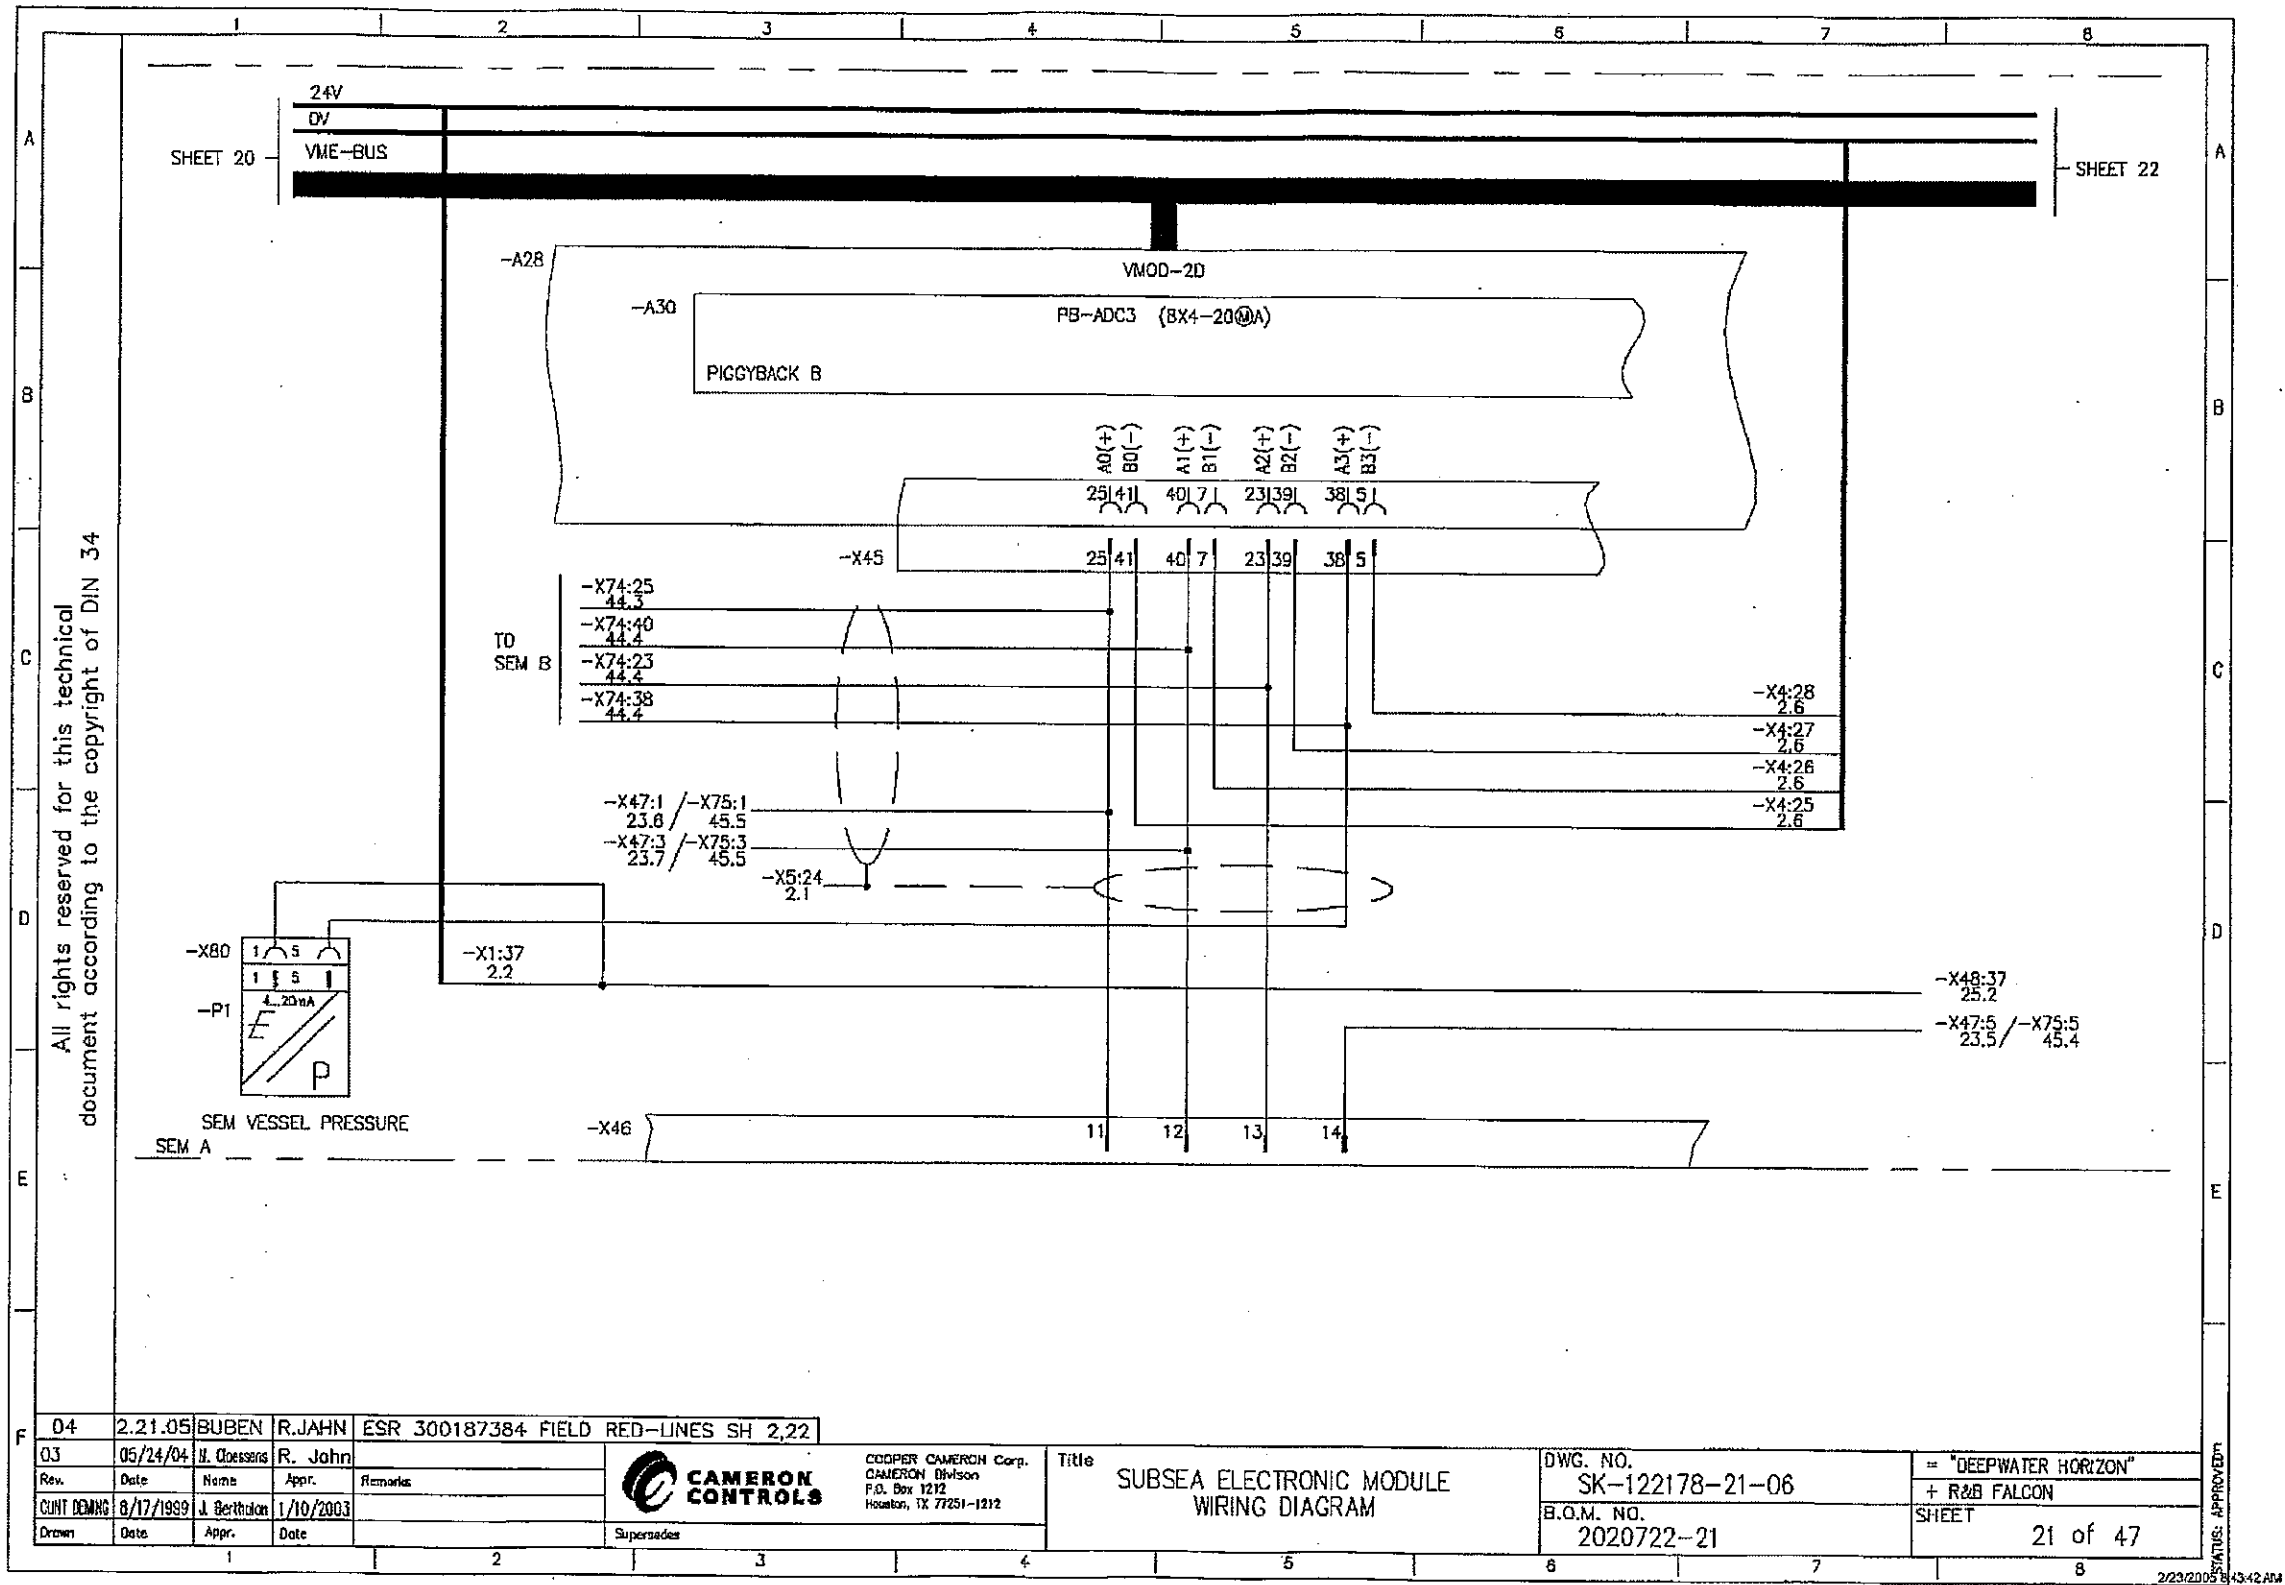

CONFIDENTIAL

TRN-MDL-00304735


2/24/2005 11:22:07 AM SAP-GILMORED SK-122178-21-06_001_000_00_CURRENT_COPY100.TIF

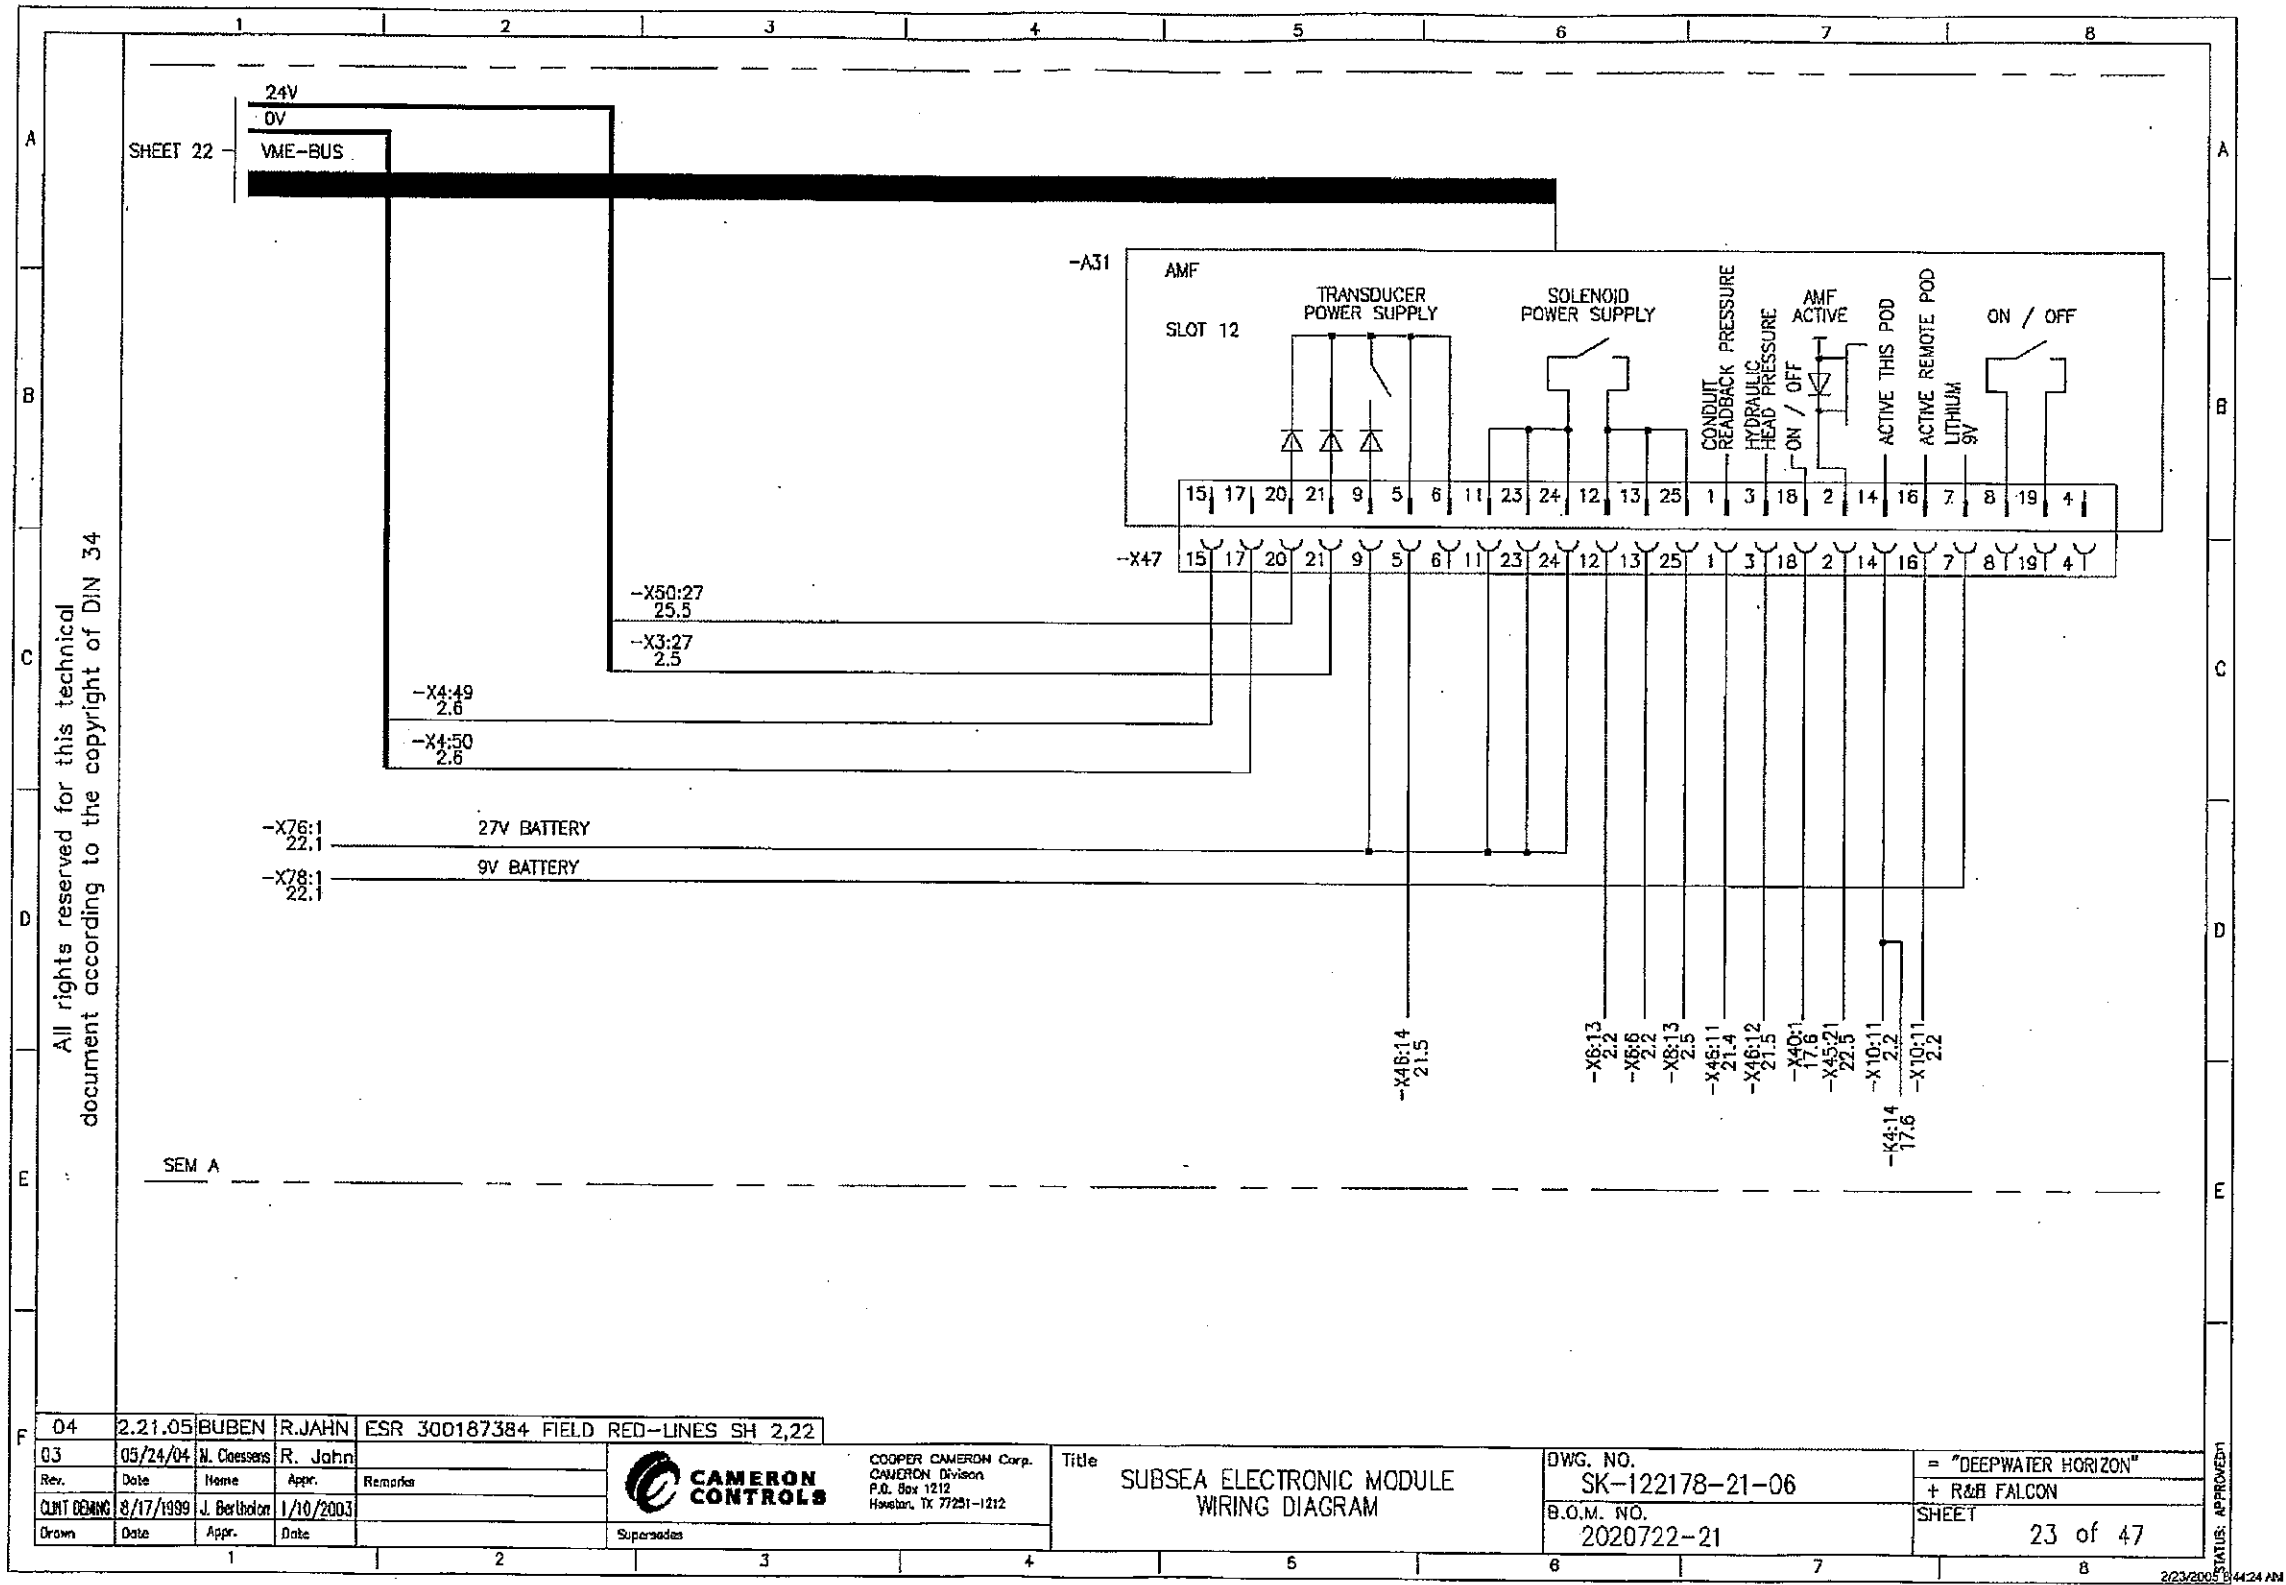

CONFIDENTIAL

TRN-MDL-00304737


2/24/2005 11:22:07 AM SAP-GILMORED SK-122178-21-06_001_000_00_CURRENT_DCP100.TIF

	1	2	3	4	5	6	7	8																																								
A	<div>SHEET 23</div> <div>24V 0V VME-BUS</div> <div>24V 0V VME-BUS</div>																																															
B																																																
C	THIS PAGE HAS BEEN INTENTIONALLY LEFT BLANK																																															
D	SEM B																																															
E																																																
F	<table border="1"><tr><td>04</td><td>2.21.05</td><td>BUBEN</td><td>R.JAHN</td><td colspan="4">ESR 300187384 FIELD RED~LINES SH 2,22</td></tr><tr><td>03</td><td>05/24/04</td><td>M. Claessens</td><td>R. Jahn</td><td colspan="4"></td></tr><tr><td>Rev.</td><td>Date</td><td>Name</td><td>Appr.</td><td colspan="4">Remarks</td></tr><tr><td>001</td><td>08/17/1999</td><td>J. Berthodan</td><td>1/10/2003</td><td colspan="4"></td></tr><tr><td>Drawn</td><td>Date</td><td>Appr.</td><td>Date</td><td colspan="4">Superseded</td></tr></table> <div>CAMERON CONTROLS COOPER CAMERON Corp. CAMERON Division P.O. Box 1212 Houston, TX 77251-1212</div> <div>Title SUBSEA ELECTRONIC MODULE WIRING DIAGRAM</div> <div>DWG. NO. SK-122178-21-06 B.C.M. NO. 2020722-21</div> <div>= "DEEPWATER HORIZON" + R&B FALCON SHEET 24 of 47</div>								04	2.21.05	BUBEN	R.JAHN	ESR 300187384 FIELD RED~LINES SH 2,22				03	05/24/04	M. Claessens	R. Jahn					Rev.	Date	Name	Appr.	Remarks				001	08/17/1999	J. Berthodan	1/10/2003					Drawn	Date	Appr.	Date	Superseded			
04	2.21.05	BUBEN	R.JAHN	ESR 300187384 FIELD RED~LINES SH 2,22																																												
03	05/24/04	M. Claessens	R. Jahn																																													
Rev.	Date	Name	Appr.	Remarks																																												
001	08/17/1999	J. Berthodan	1/10/2003																																													
Drawn	Date	Appr.	Date	Superseded																																												

CONFIDENTIAL

TRN-MDL-00304738


2/24/2005 11:22:07 AM SAP-GILMORED SK-122178-21-06_001_000_00_CURRENT_CCP100.TIF

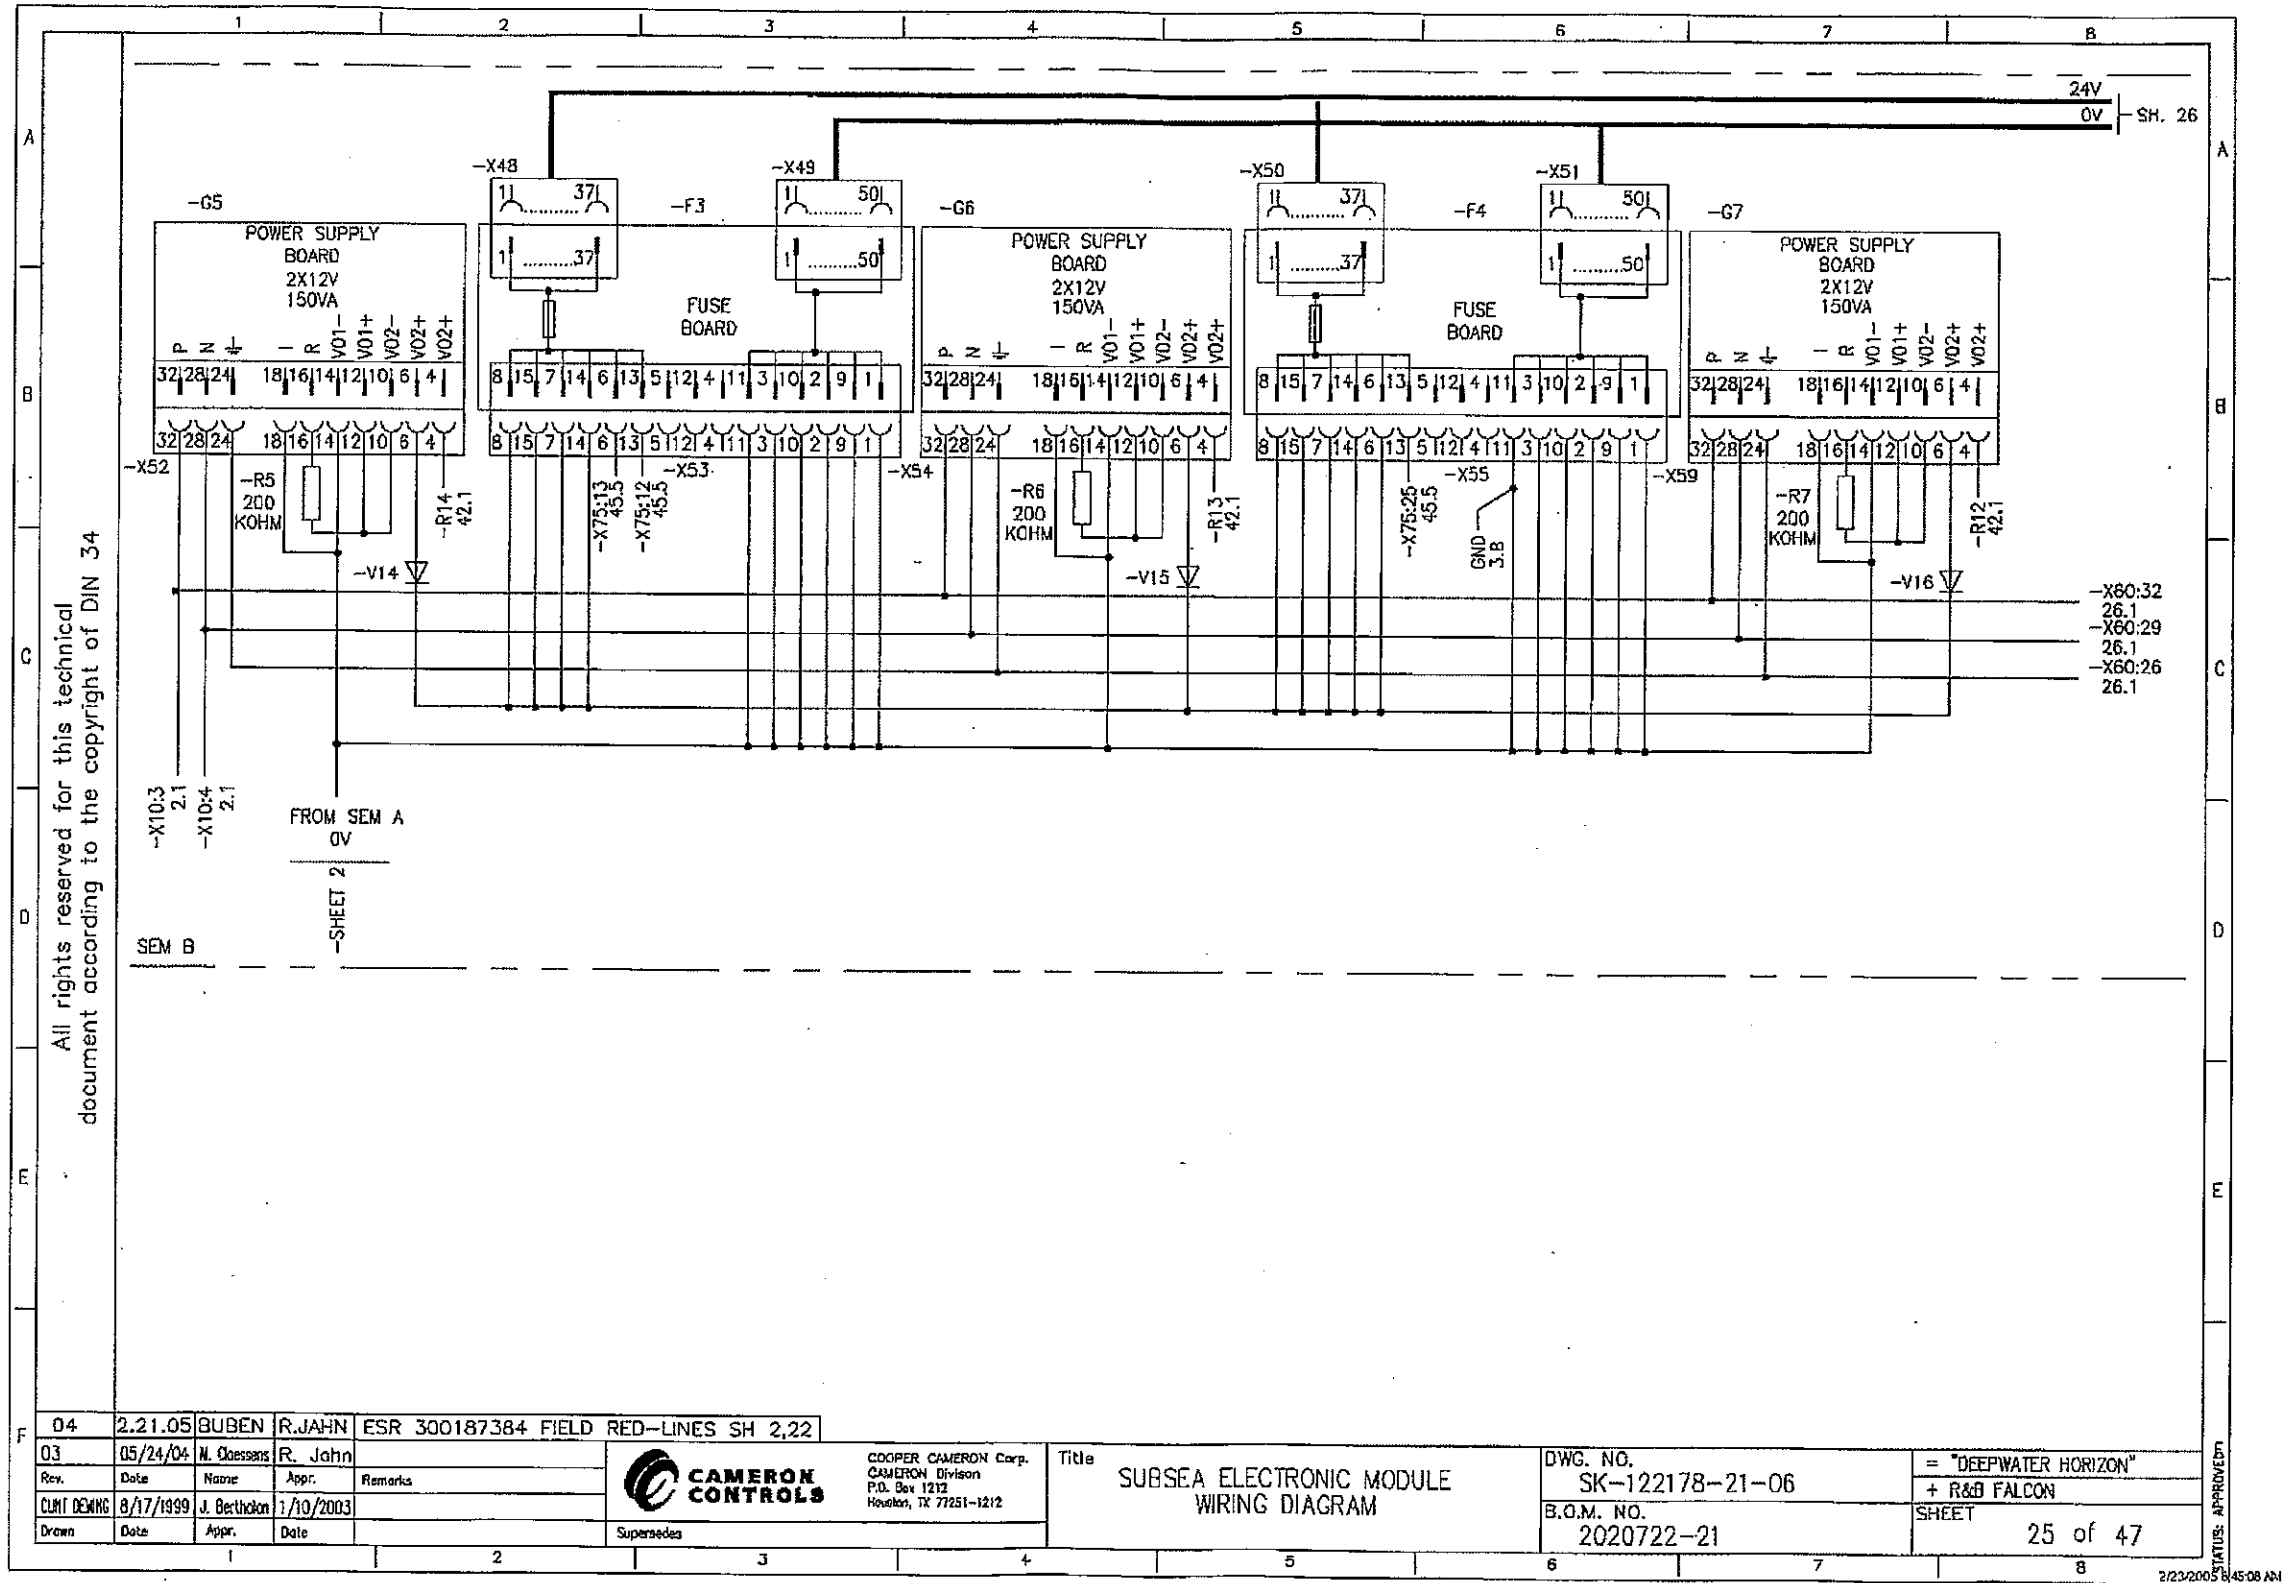

CONFIDENTIAL

TRN-MDL-00304739


2/24/2005 11:22:07 AM SAP-GILMORED SK-122178-21-06_001-000_00_CURRENT_COPY000.TIF

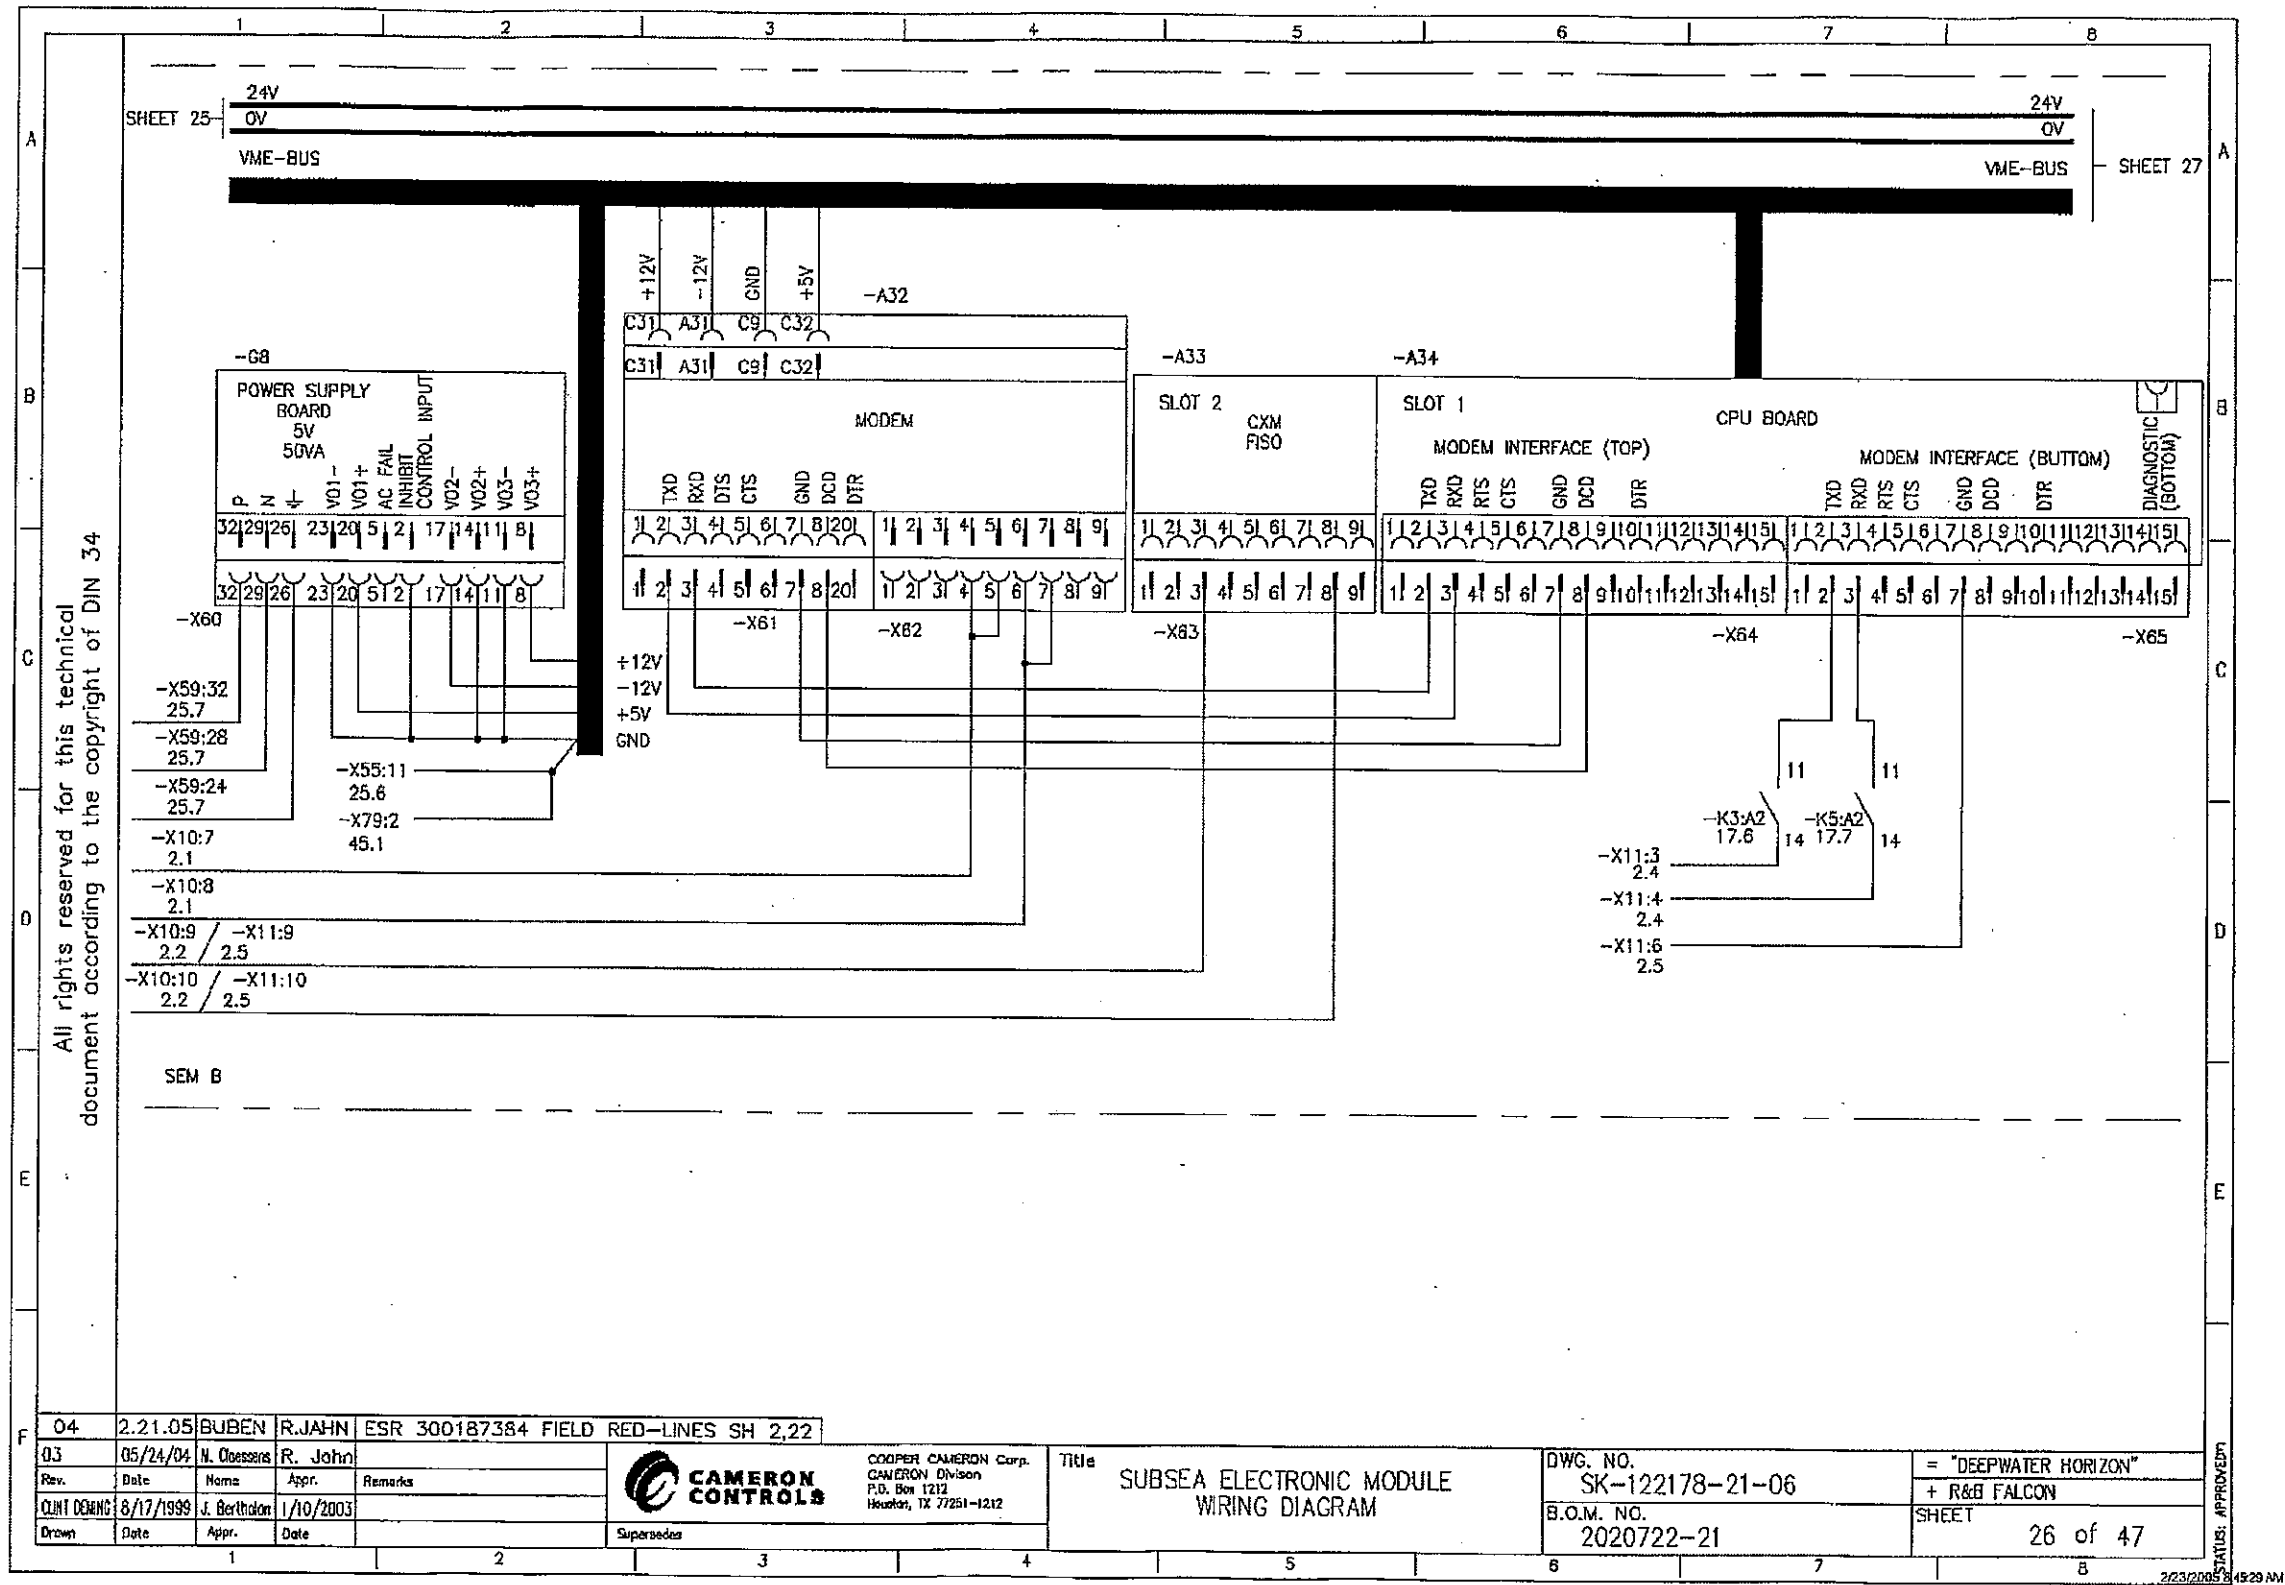

TRN-MDL-00304740

CONFIDENTIAL


2/24/2005 11:22:07 AM SAP-GILMORED SK-122178-21-06_001_000_00_CURRENT_COP100.TIF

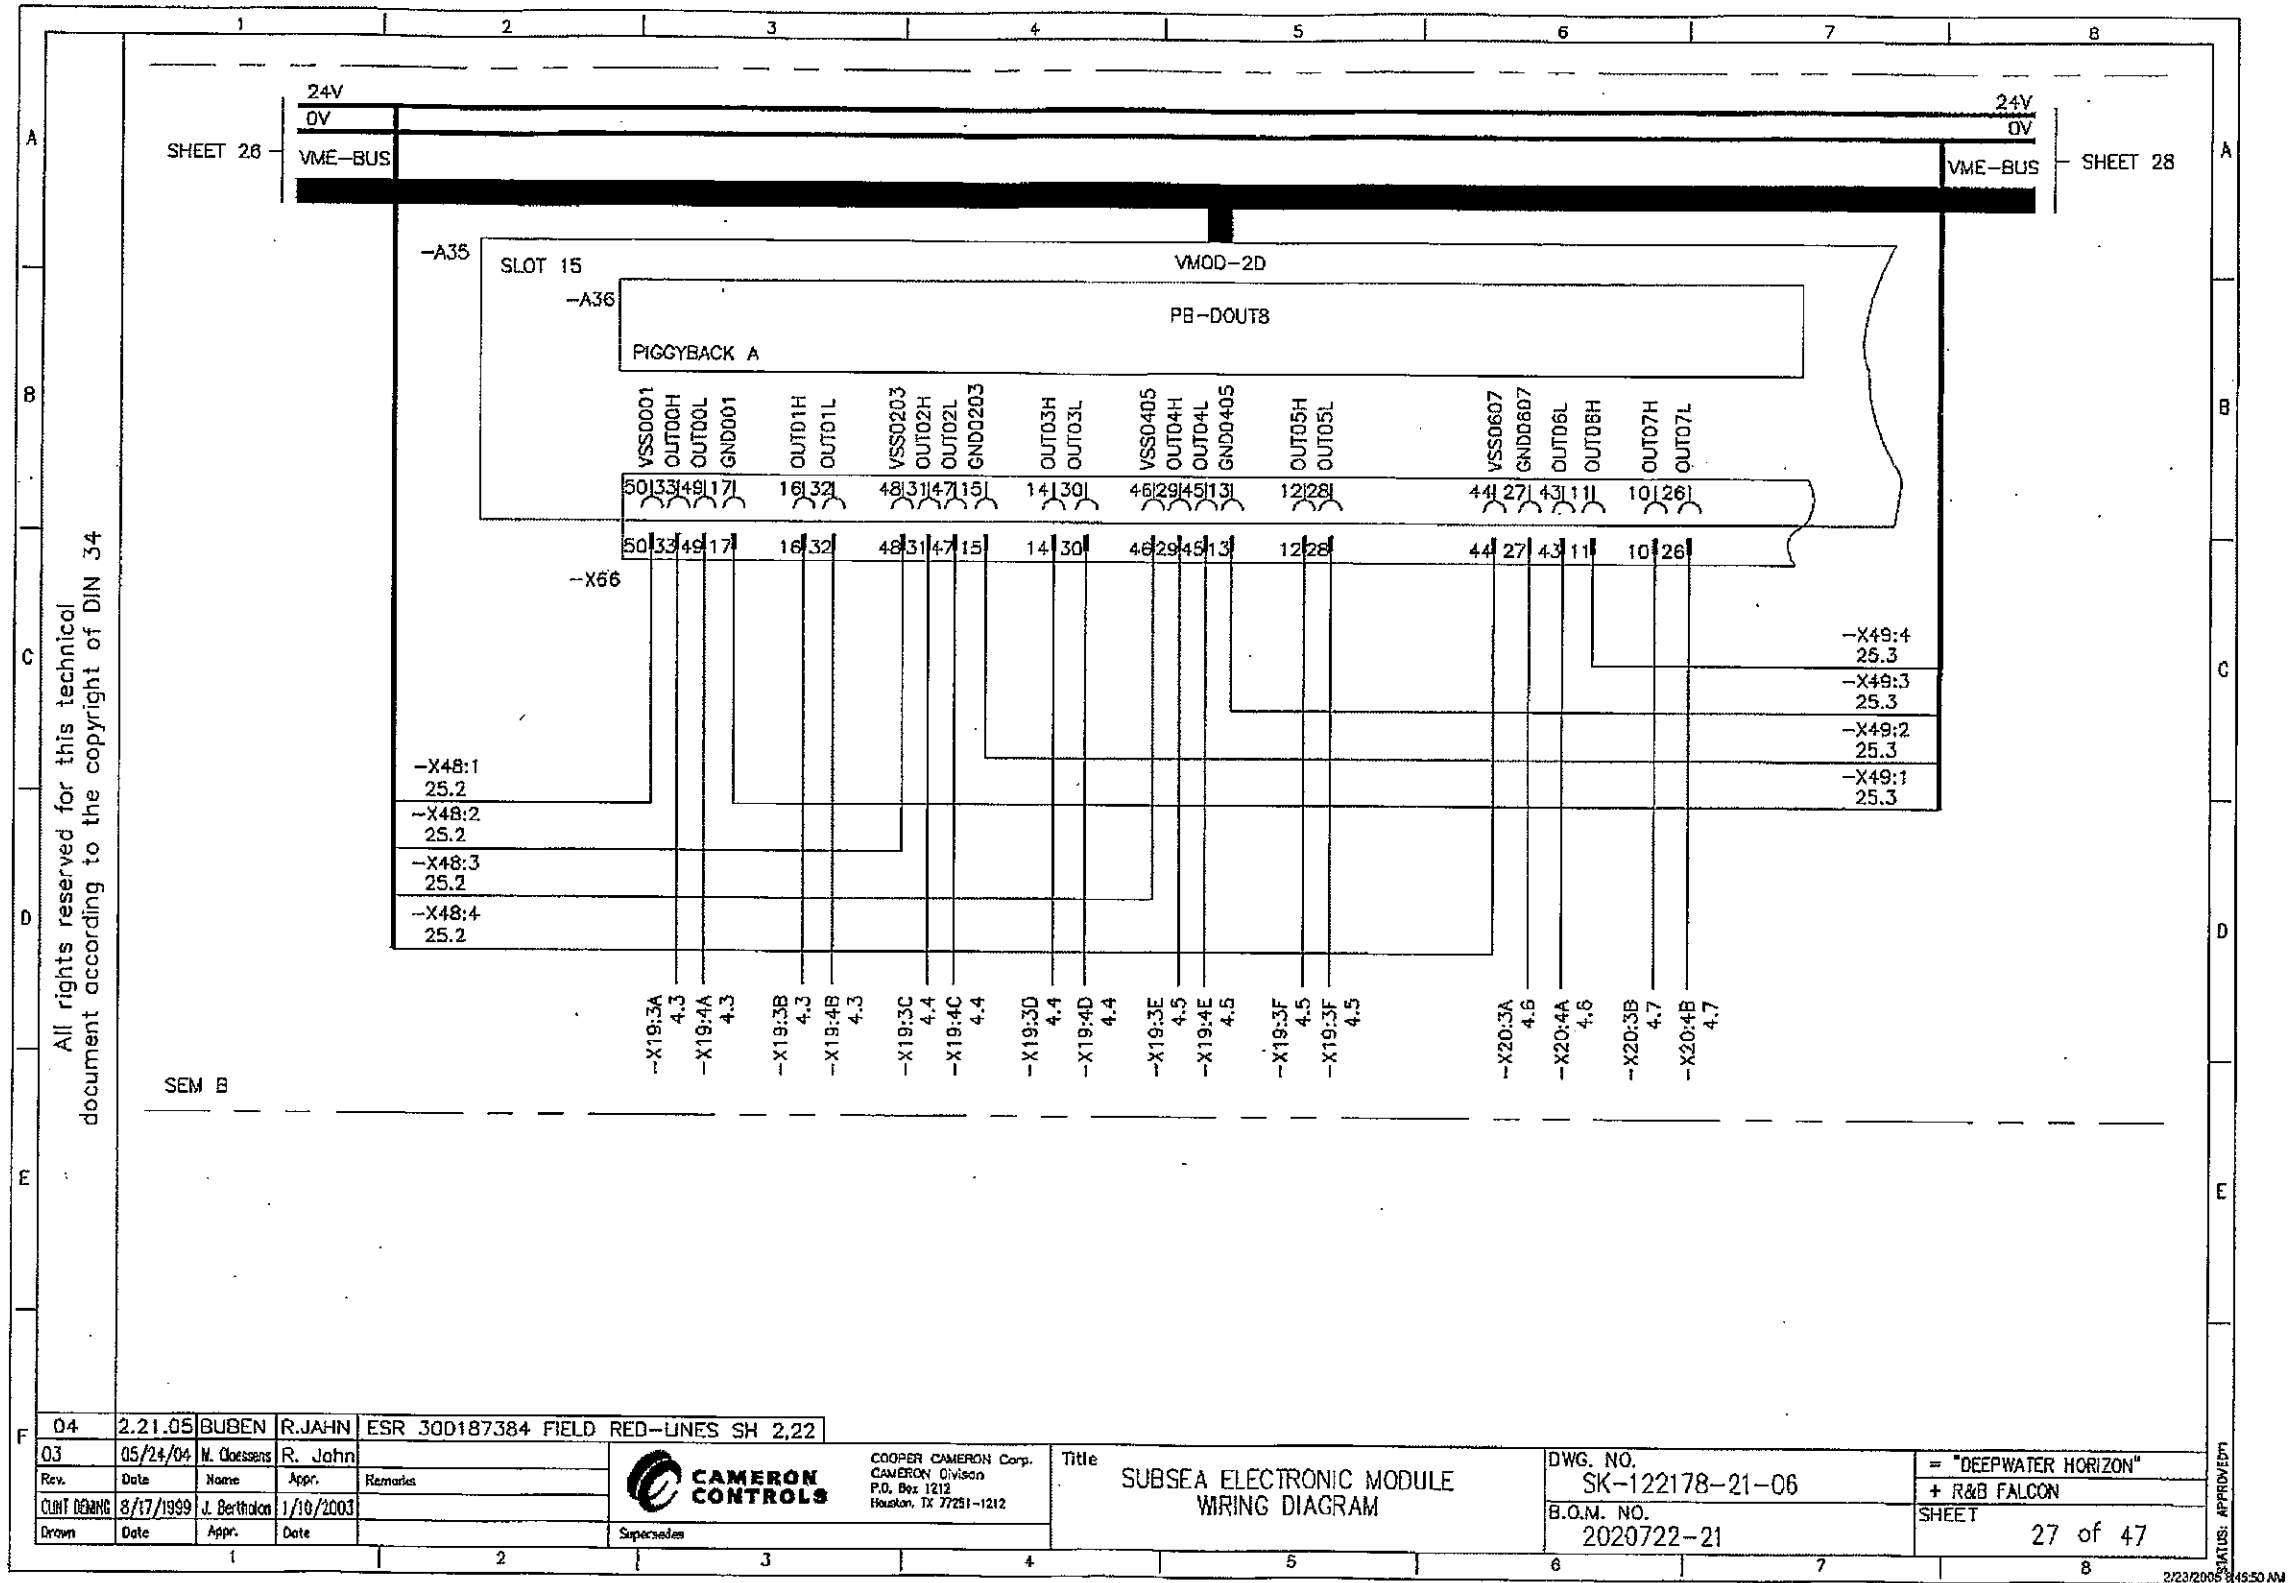

TRN-MDL-00304741


CONFIDENTIAL

2/24/2005 11:22:07 AM SAP-GILMORED SK-122178-21-06_001_000_00_CURRENT_COP100.TIF

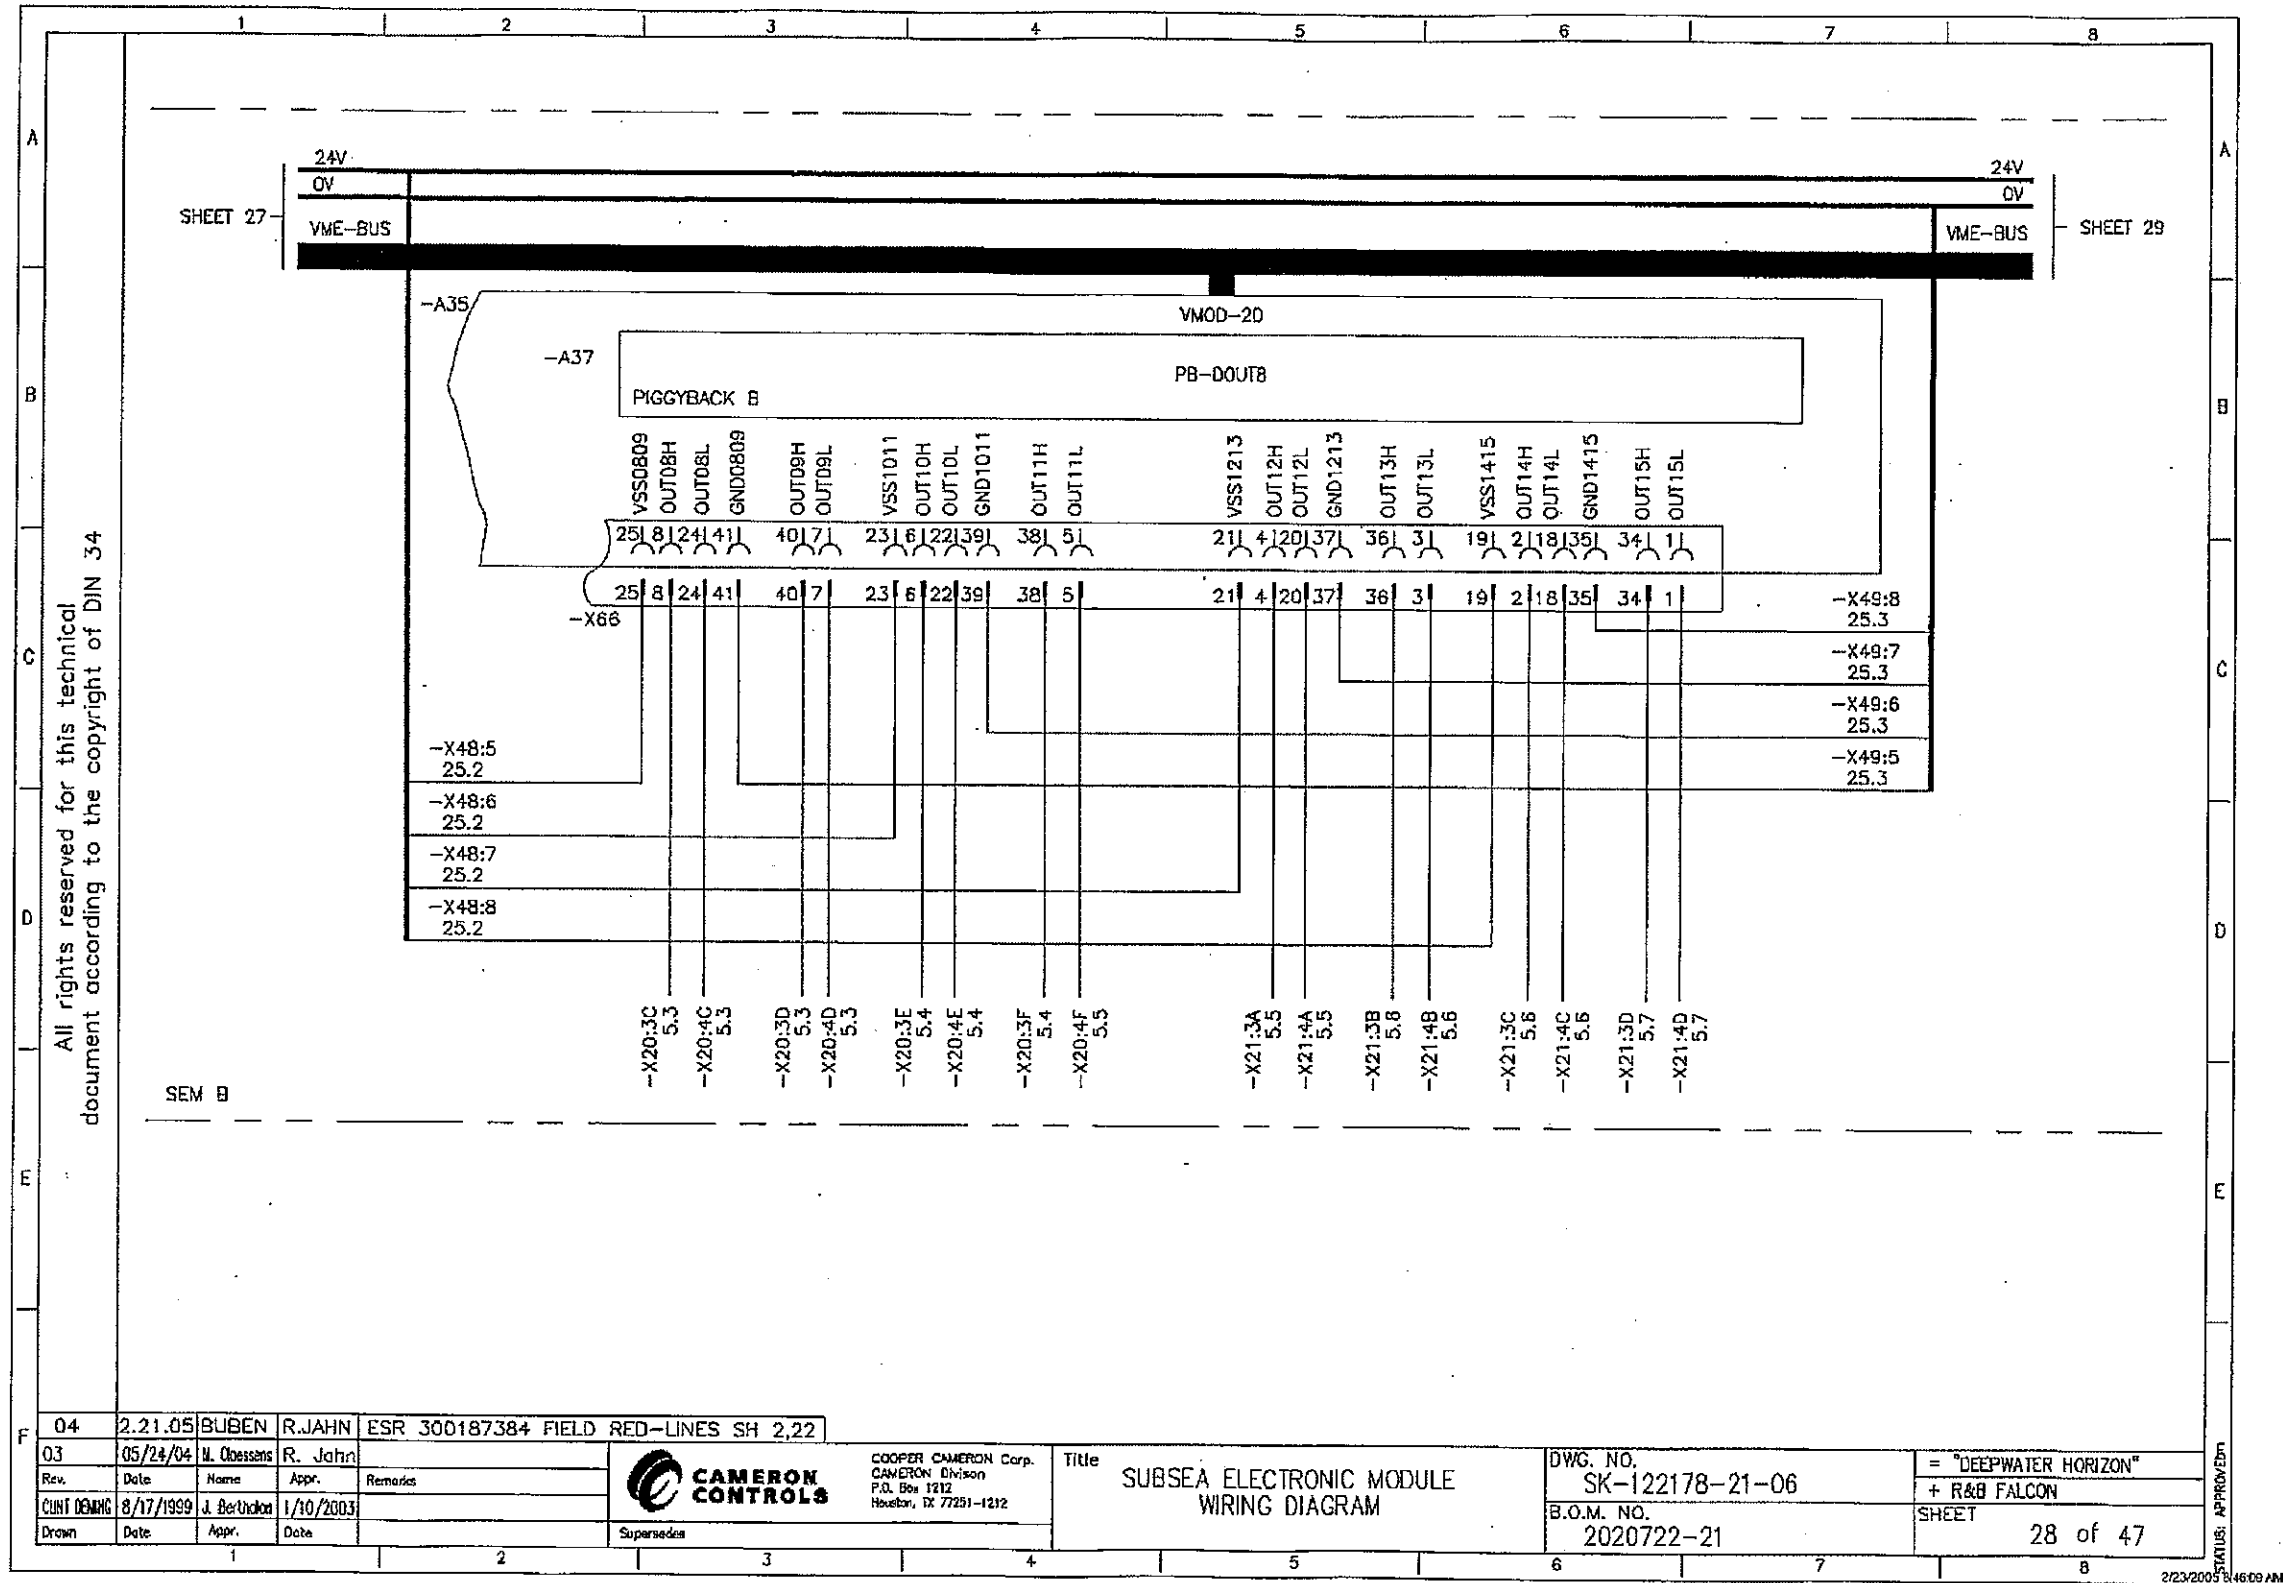


CONFIDENTIAL

TRN-MDL-00304742

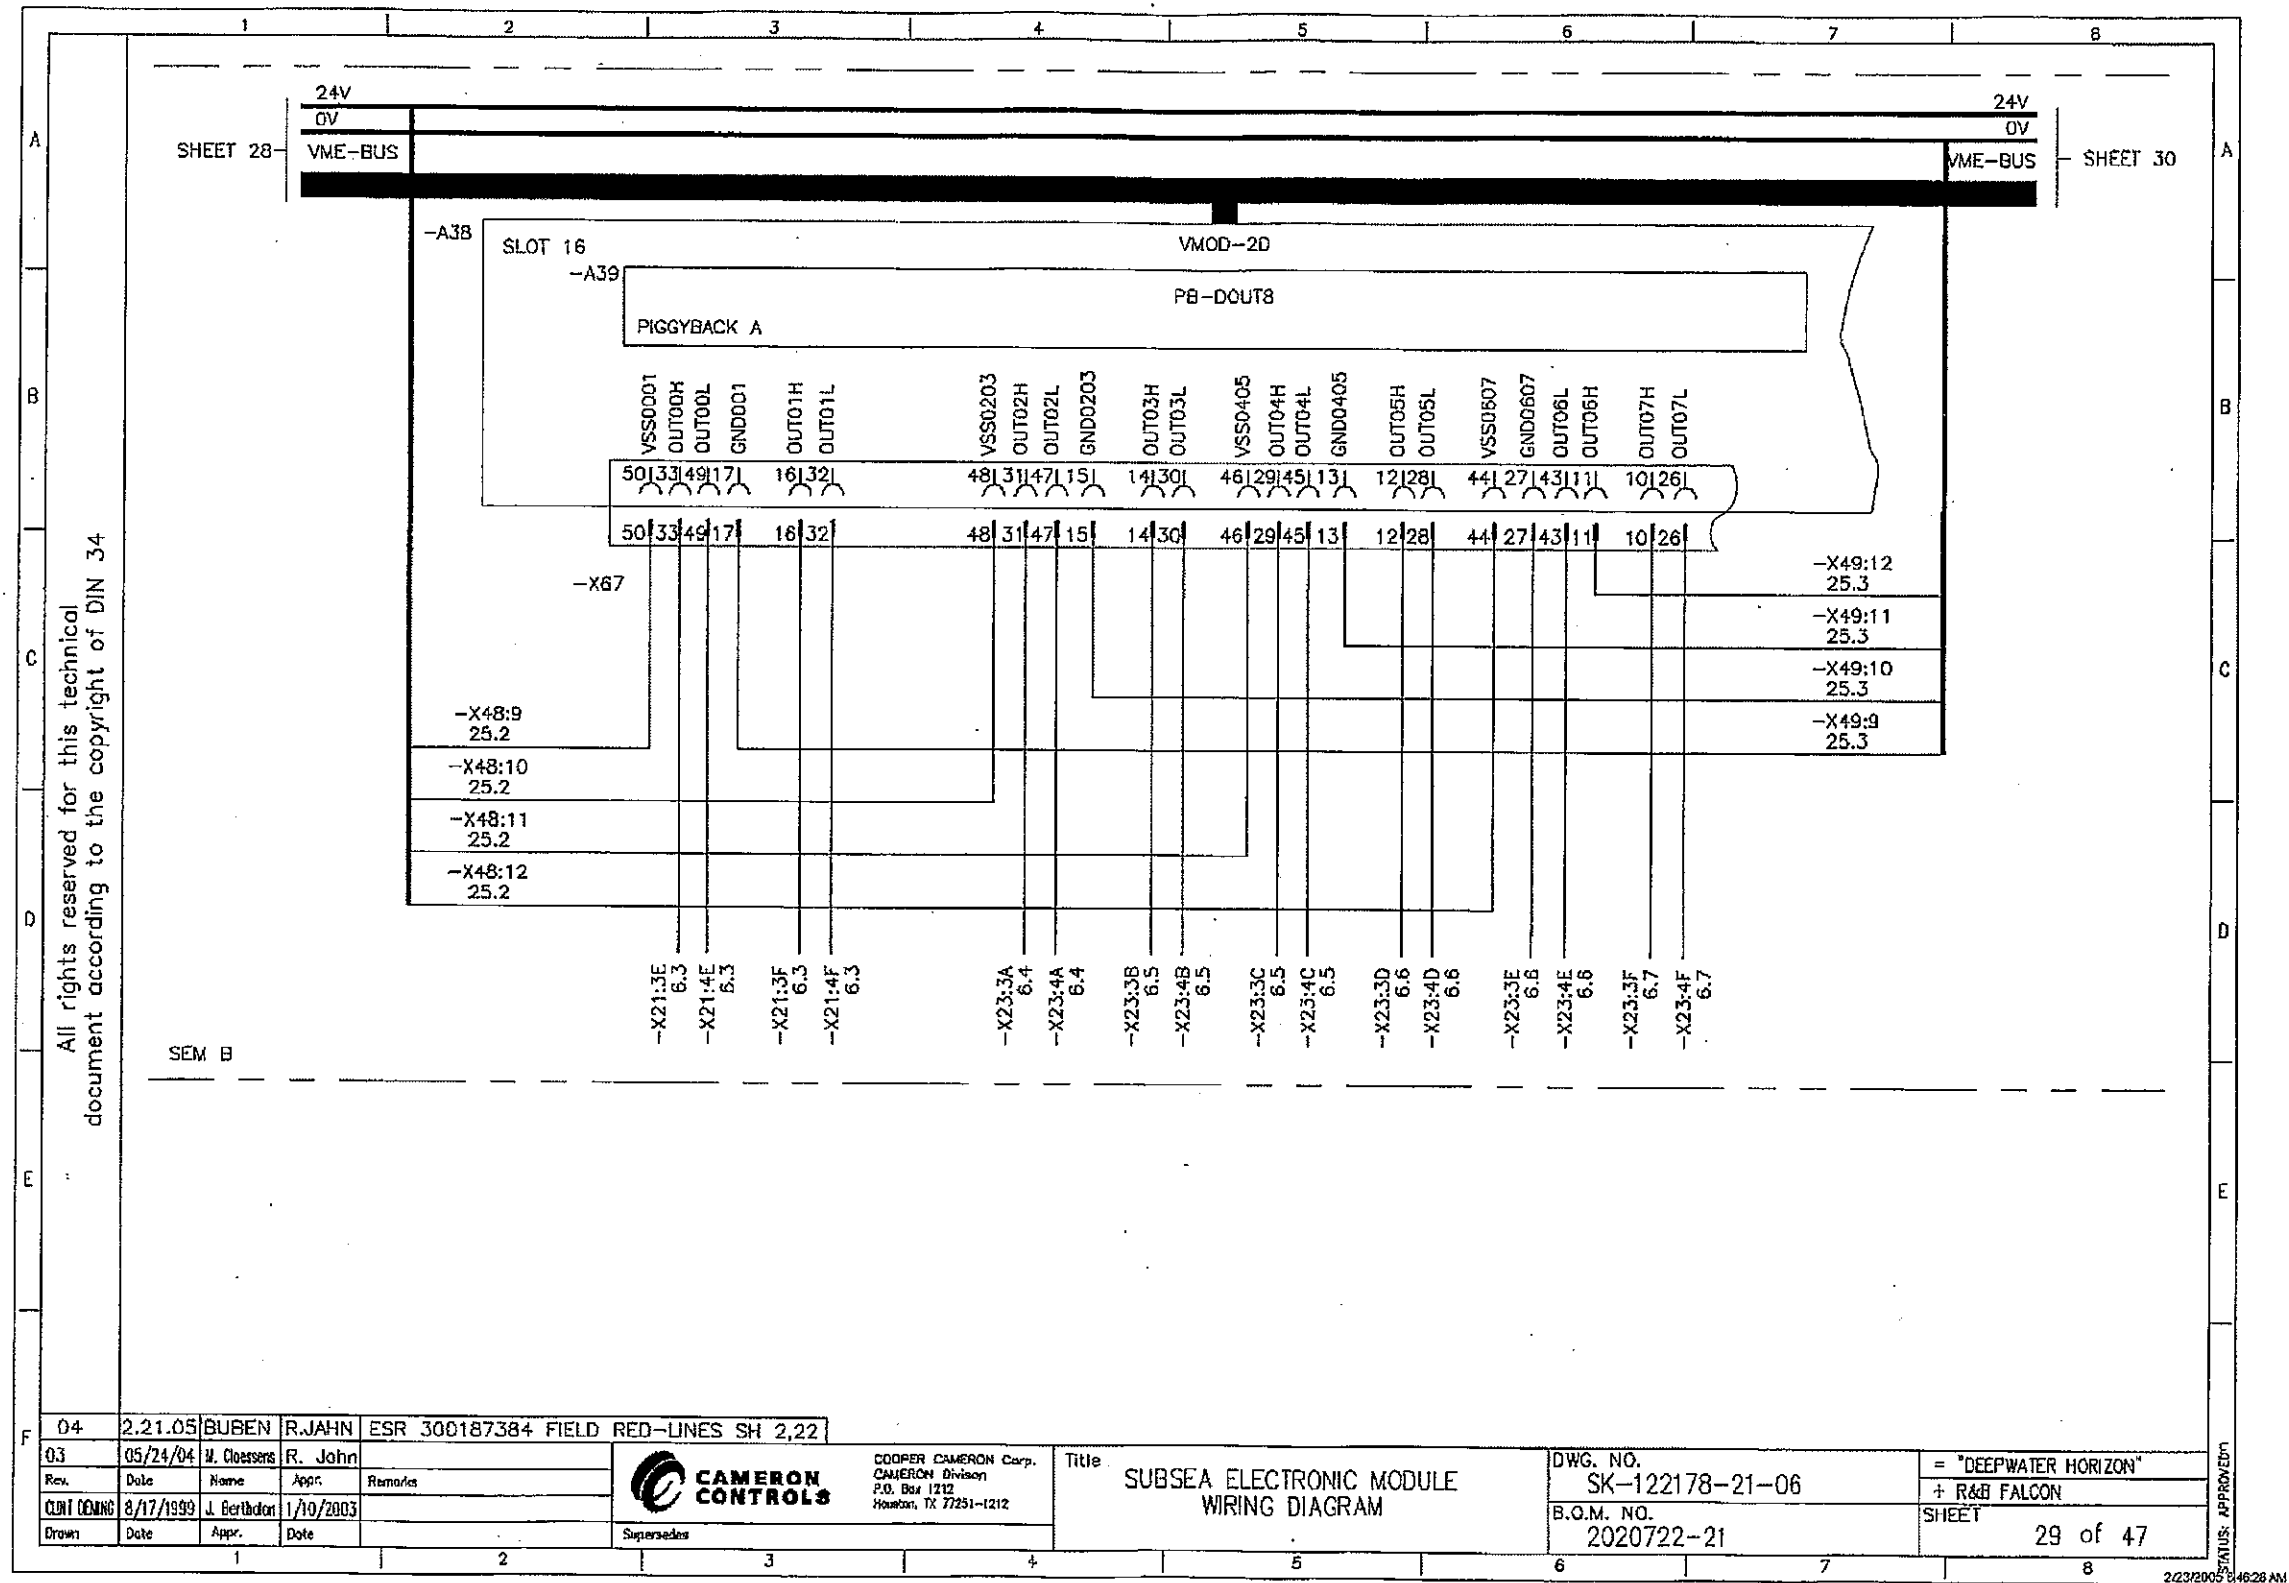


2/24/2005 11:22:07 AM SAP-OILMORED SK-122178-21-06.001.000.00 CURRENT_CCP100.TIF

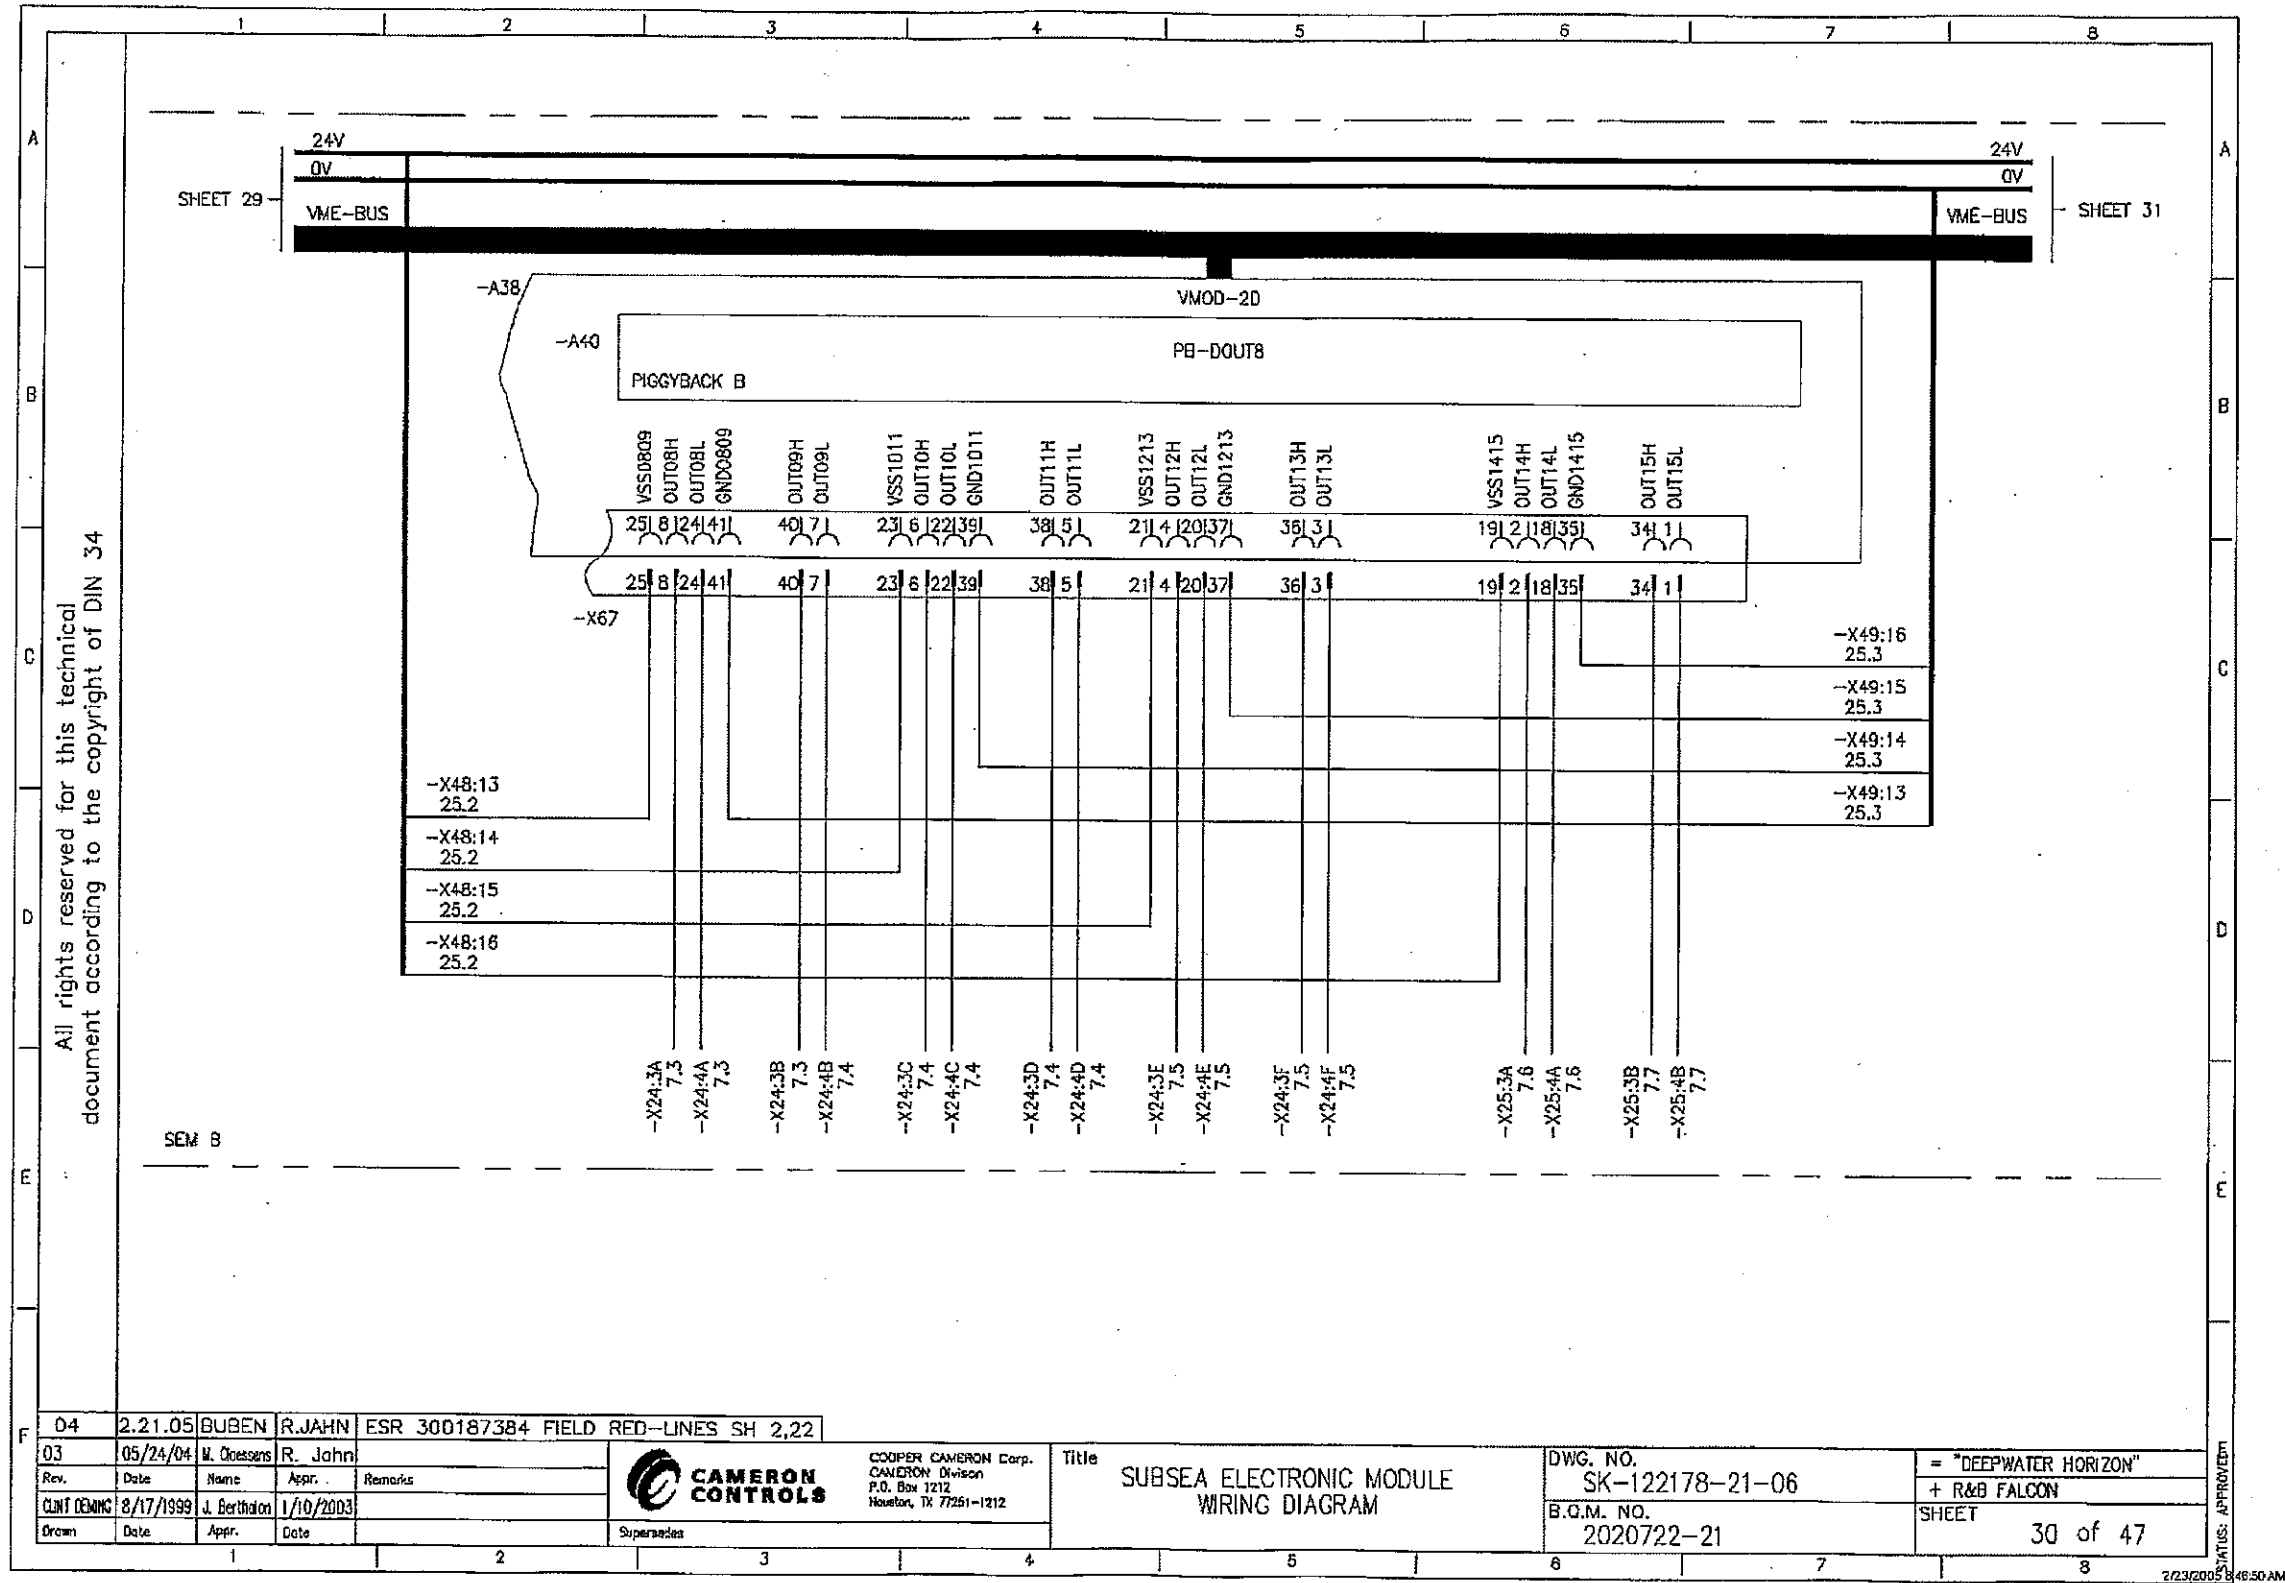

CONFIDENTIAL

TRN-MDL-00304744

2/24/2005 11:22:07 AM SAP-GILMORED SK-122178-21-06_001_000_00_CURRENT_COP100.TIF

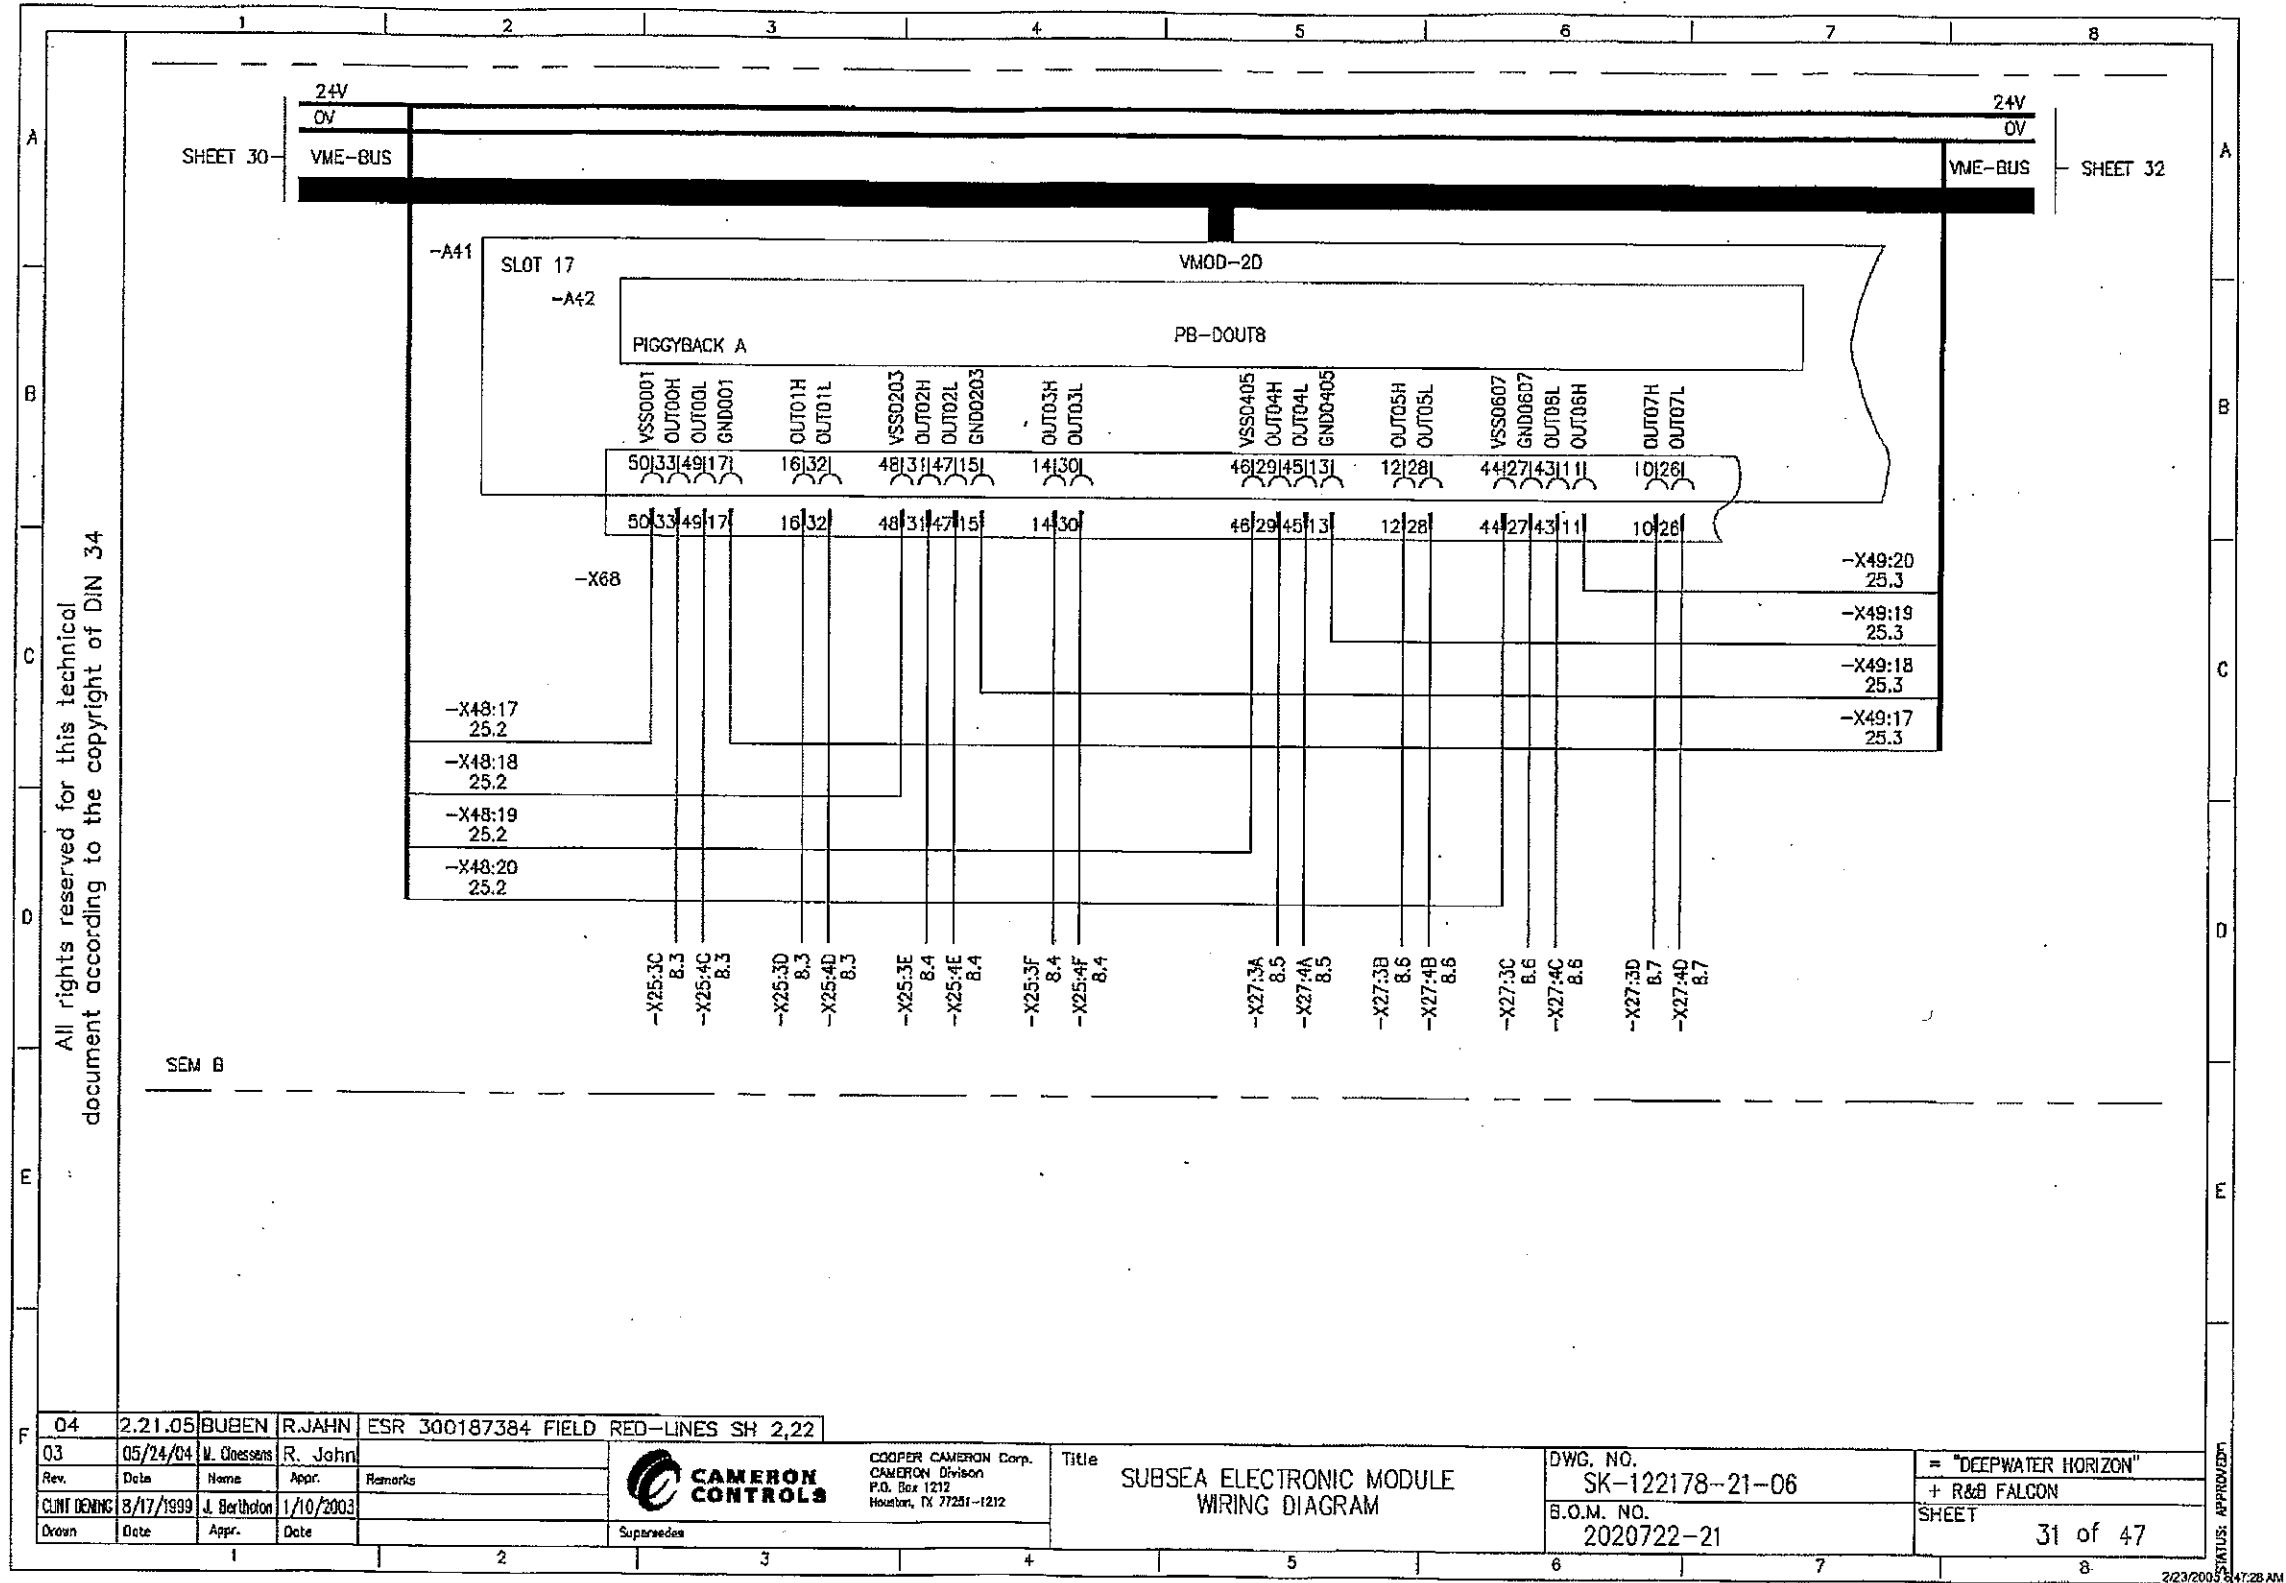

All rights reserved for this technical document according to the copyright of DIN 34

04	2.21.05	BUBEN	R. JAHN	ESR 300187384 FIELD RED-LINES SH 2,22
03	05/24/04	M. Oessens	R. Jahn	
Rev.	Date	Name	Appr.	Remarks
CLINT DENING	8/17/1999	J. Bertholon	1/10/2003	
Drawn	Date	Appr.	Date	



COOPER CAMERON Corp.
CAMERON Division
P.O. Box 1212
Houston, TX 77251-1212

Title
SUBSEA ELECTRONIC MODULE
WIRING DIAGRAM


DWG. NO.
SK-122178-21-06
B.O.M. NO.
2020722-21


= "DEEPWATER HORIZON"
+ R&B FALCON
SHEET
31 of 47

STATUS: APPROVED

CONFIDENTIAL

TRN-MDL-00304745

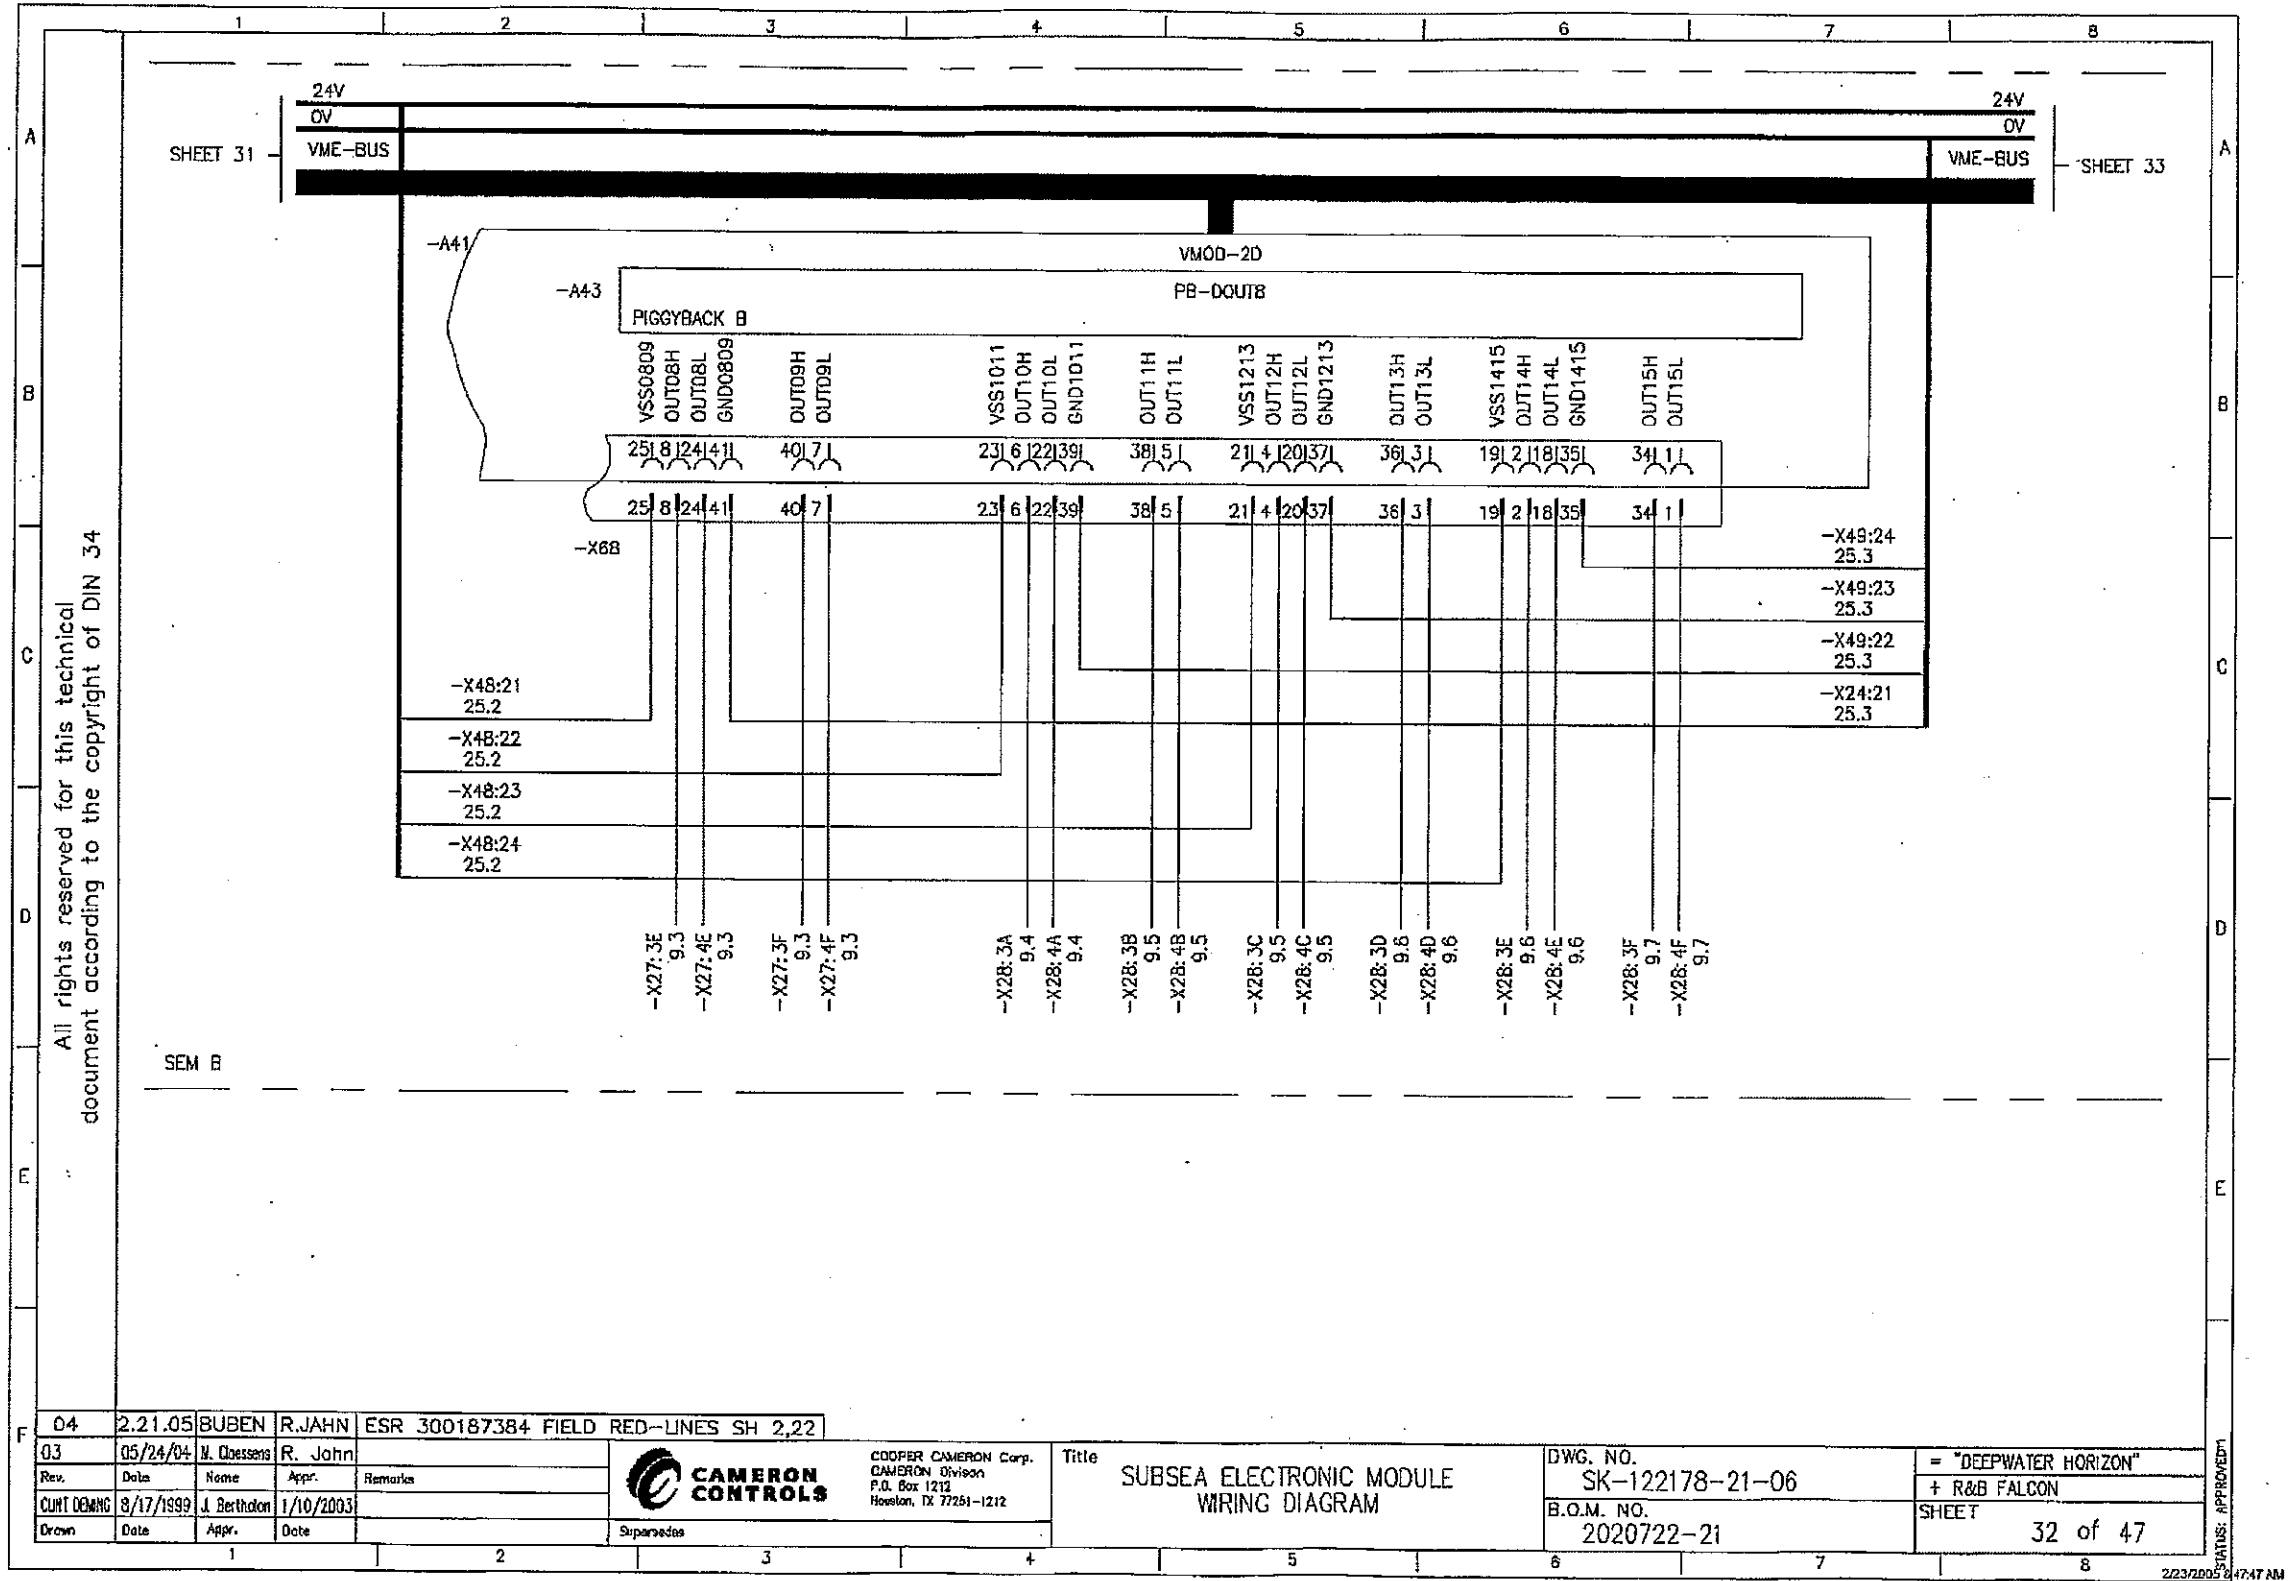

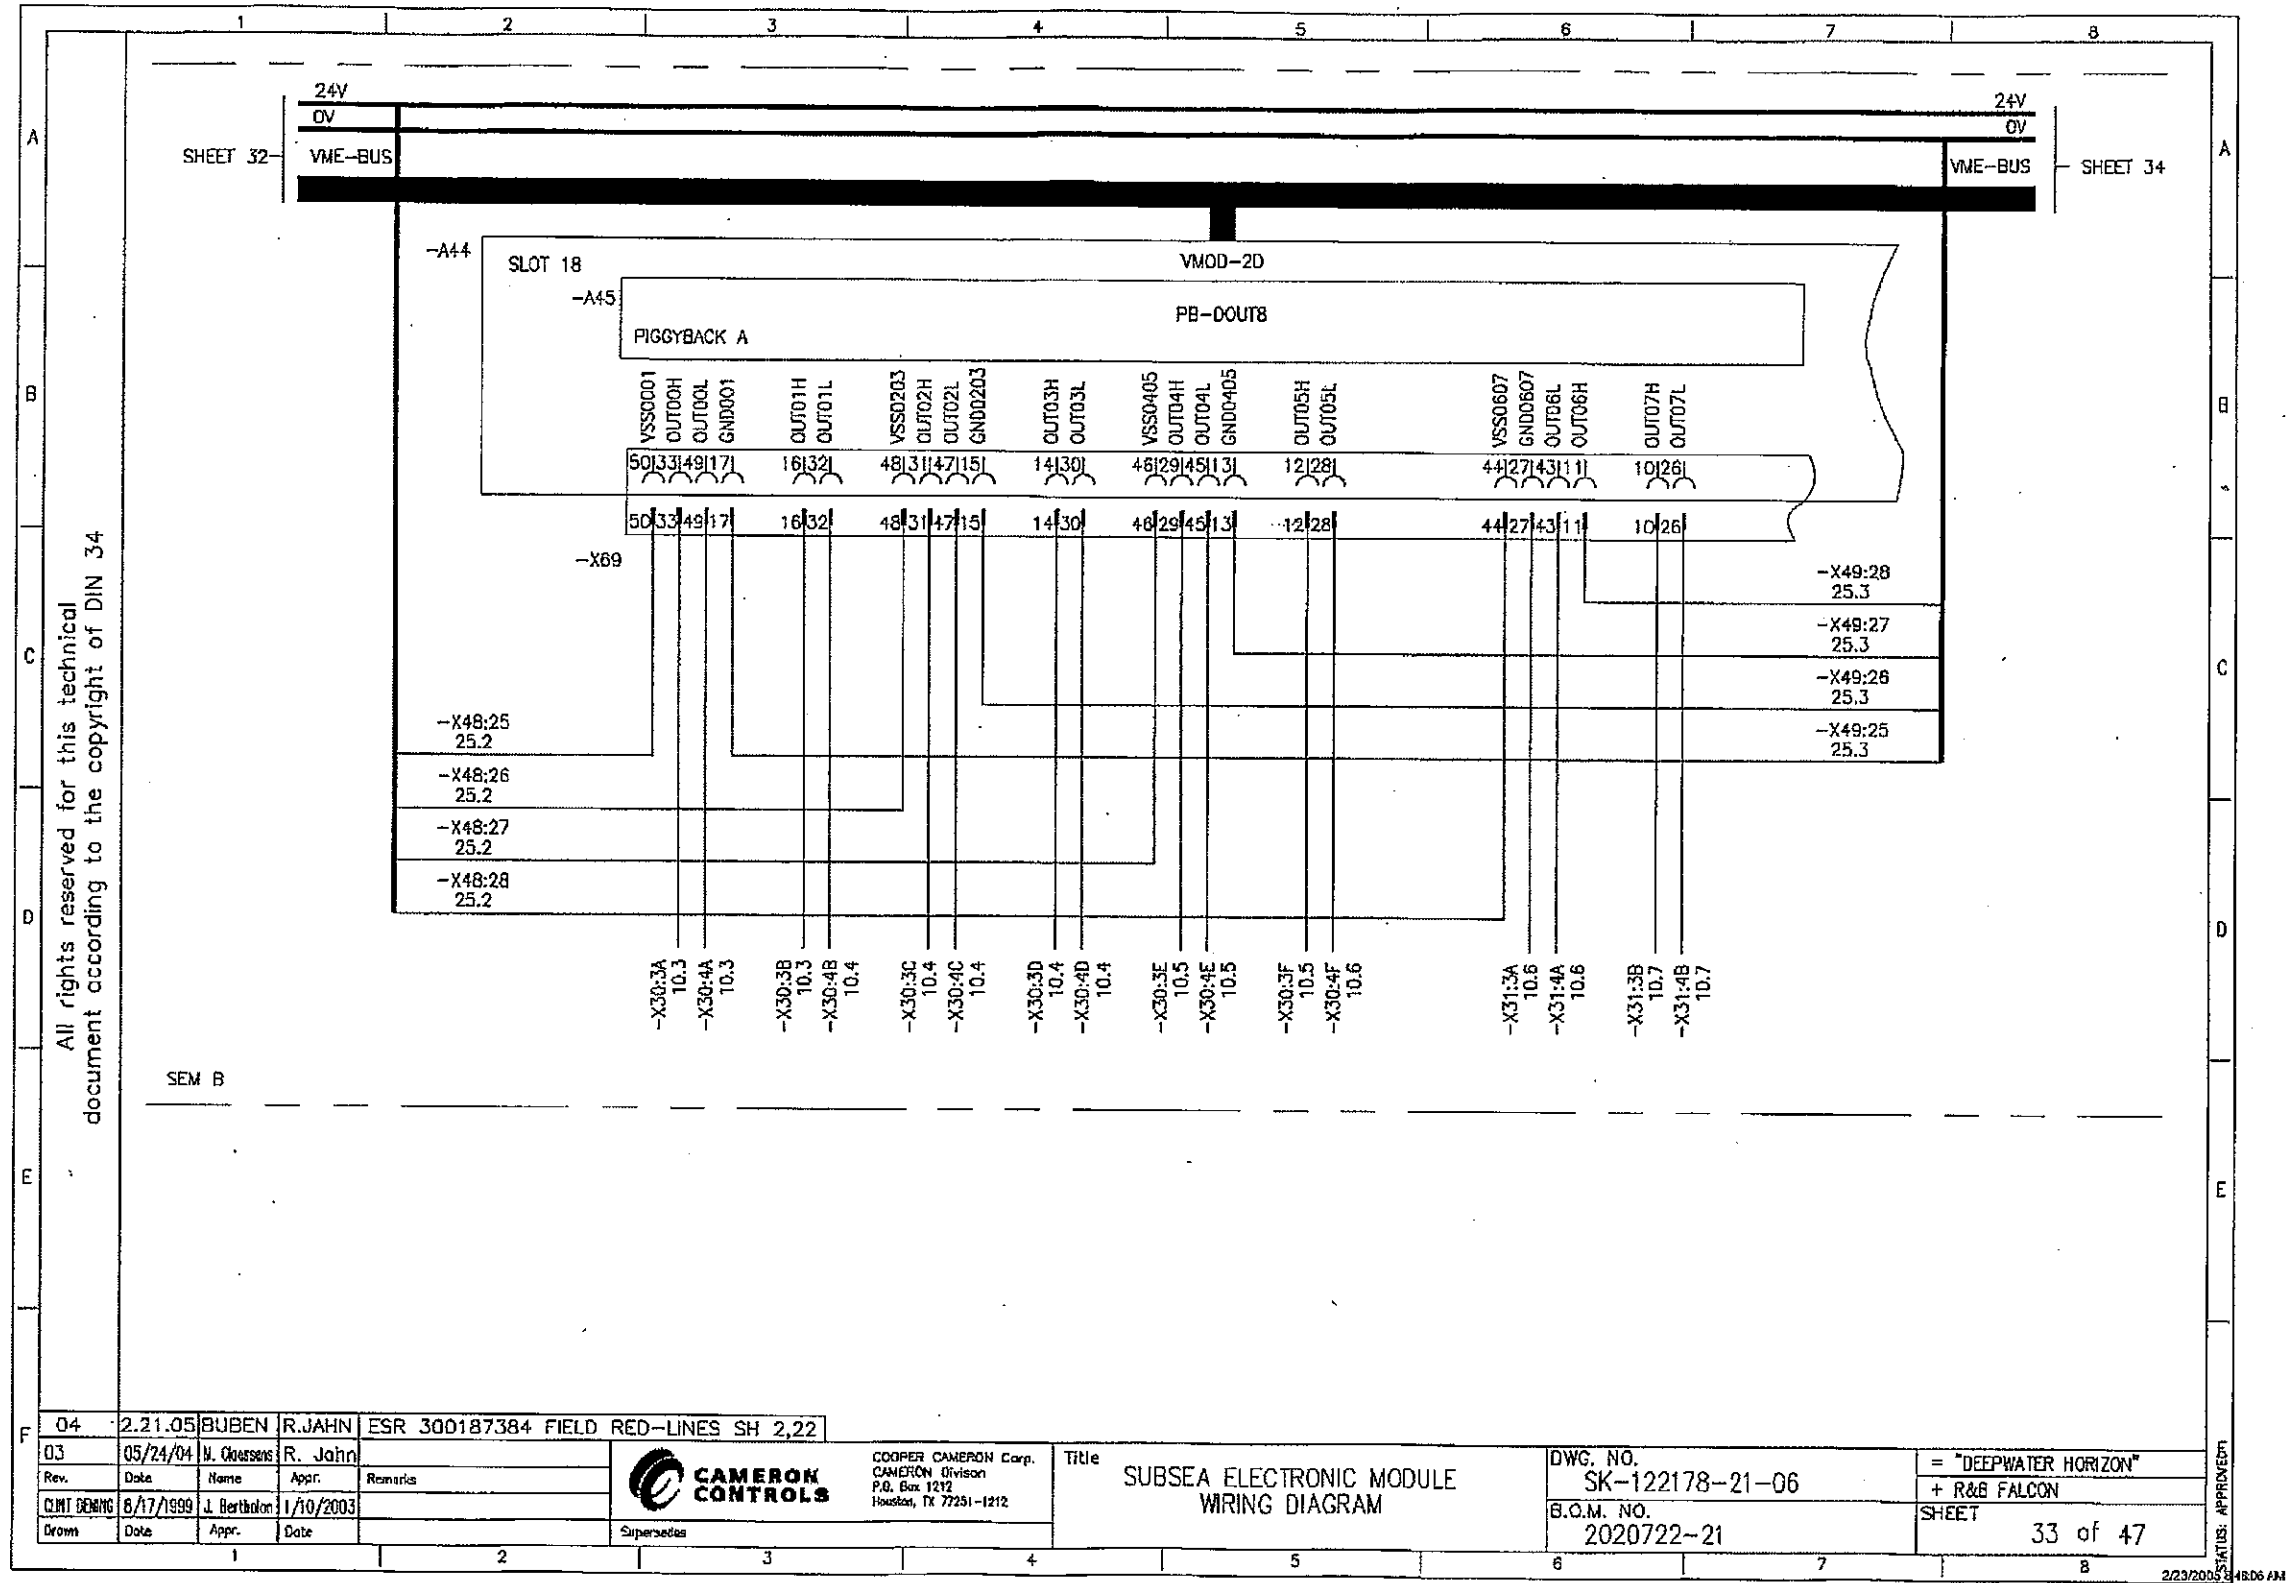

All rights reserved for this technical document according to the copyright of DIN 34

04	2.21.05	BUBEN	R. JAHN	ESR 300187384 FIELD RED-LINES SH 2,22
03	05/24/04	N. Goussens	R. Jahn	
Rev.	Date	Name	Appr.	Remarks
CMIT DENING	8/17/1999	J. Bertillon	1/10/2003	
Drawn	Date	Appr.	Date	



COOPER CAMERON Corp.
CAMERON Division
P.O. Box 1212
Houston, TX 77251-1212

Title
SUBSEA ELECTRONIC MODULE
WIRING DIAGRAM

DWG. NO.
SK-122178-21-06
B.O.M. NO.
2020722-21

= "DEEPWATER HORIZON"
+ R&B FALCON
SHEET
33 of 47


STATUS: APPROVED

CONFIDENTIAL

TRN-MDL-00304747




2/24/2005 11:22:07 AM SAP-GILMORED SK-122178-21-06_001_000_00_CURRENT_COP100.TIF

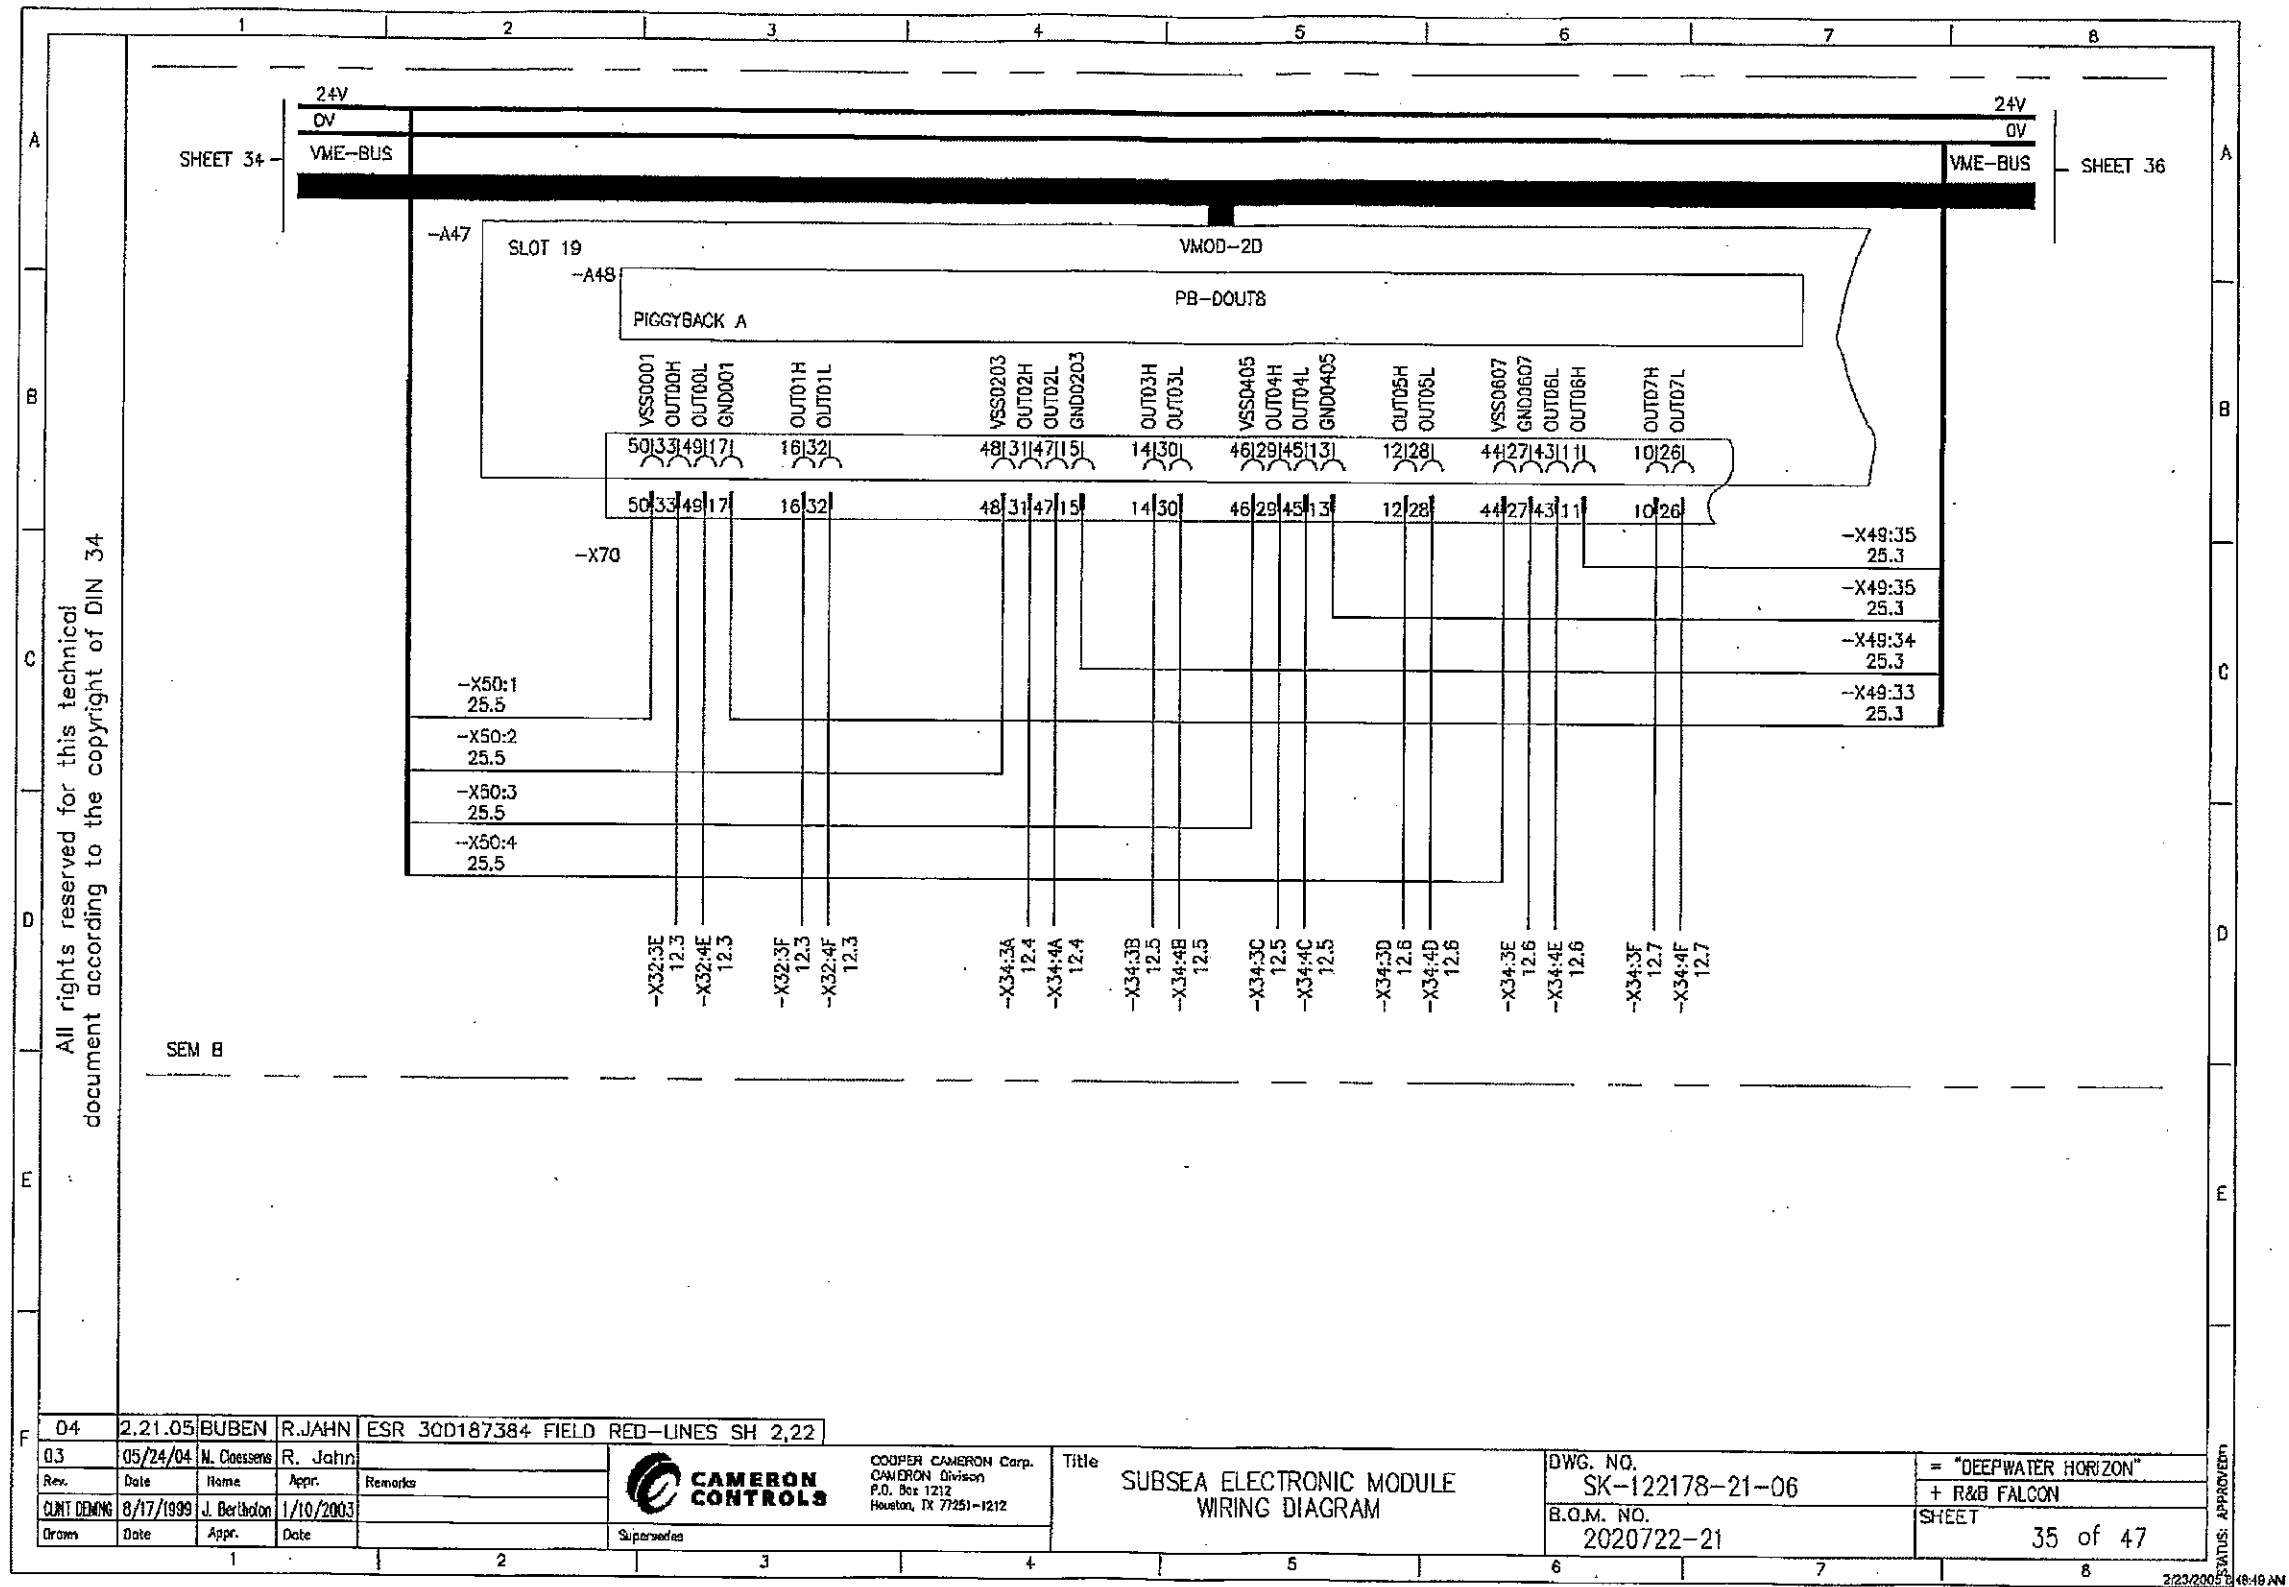

CONFIDENTIAL


TRN-MDL-00304749

2/24/2005 11:22:07 AM SAP-CILMORED SK-122178-21-06.001.000.00_CURRENT_COP100.TIF

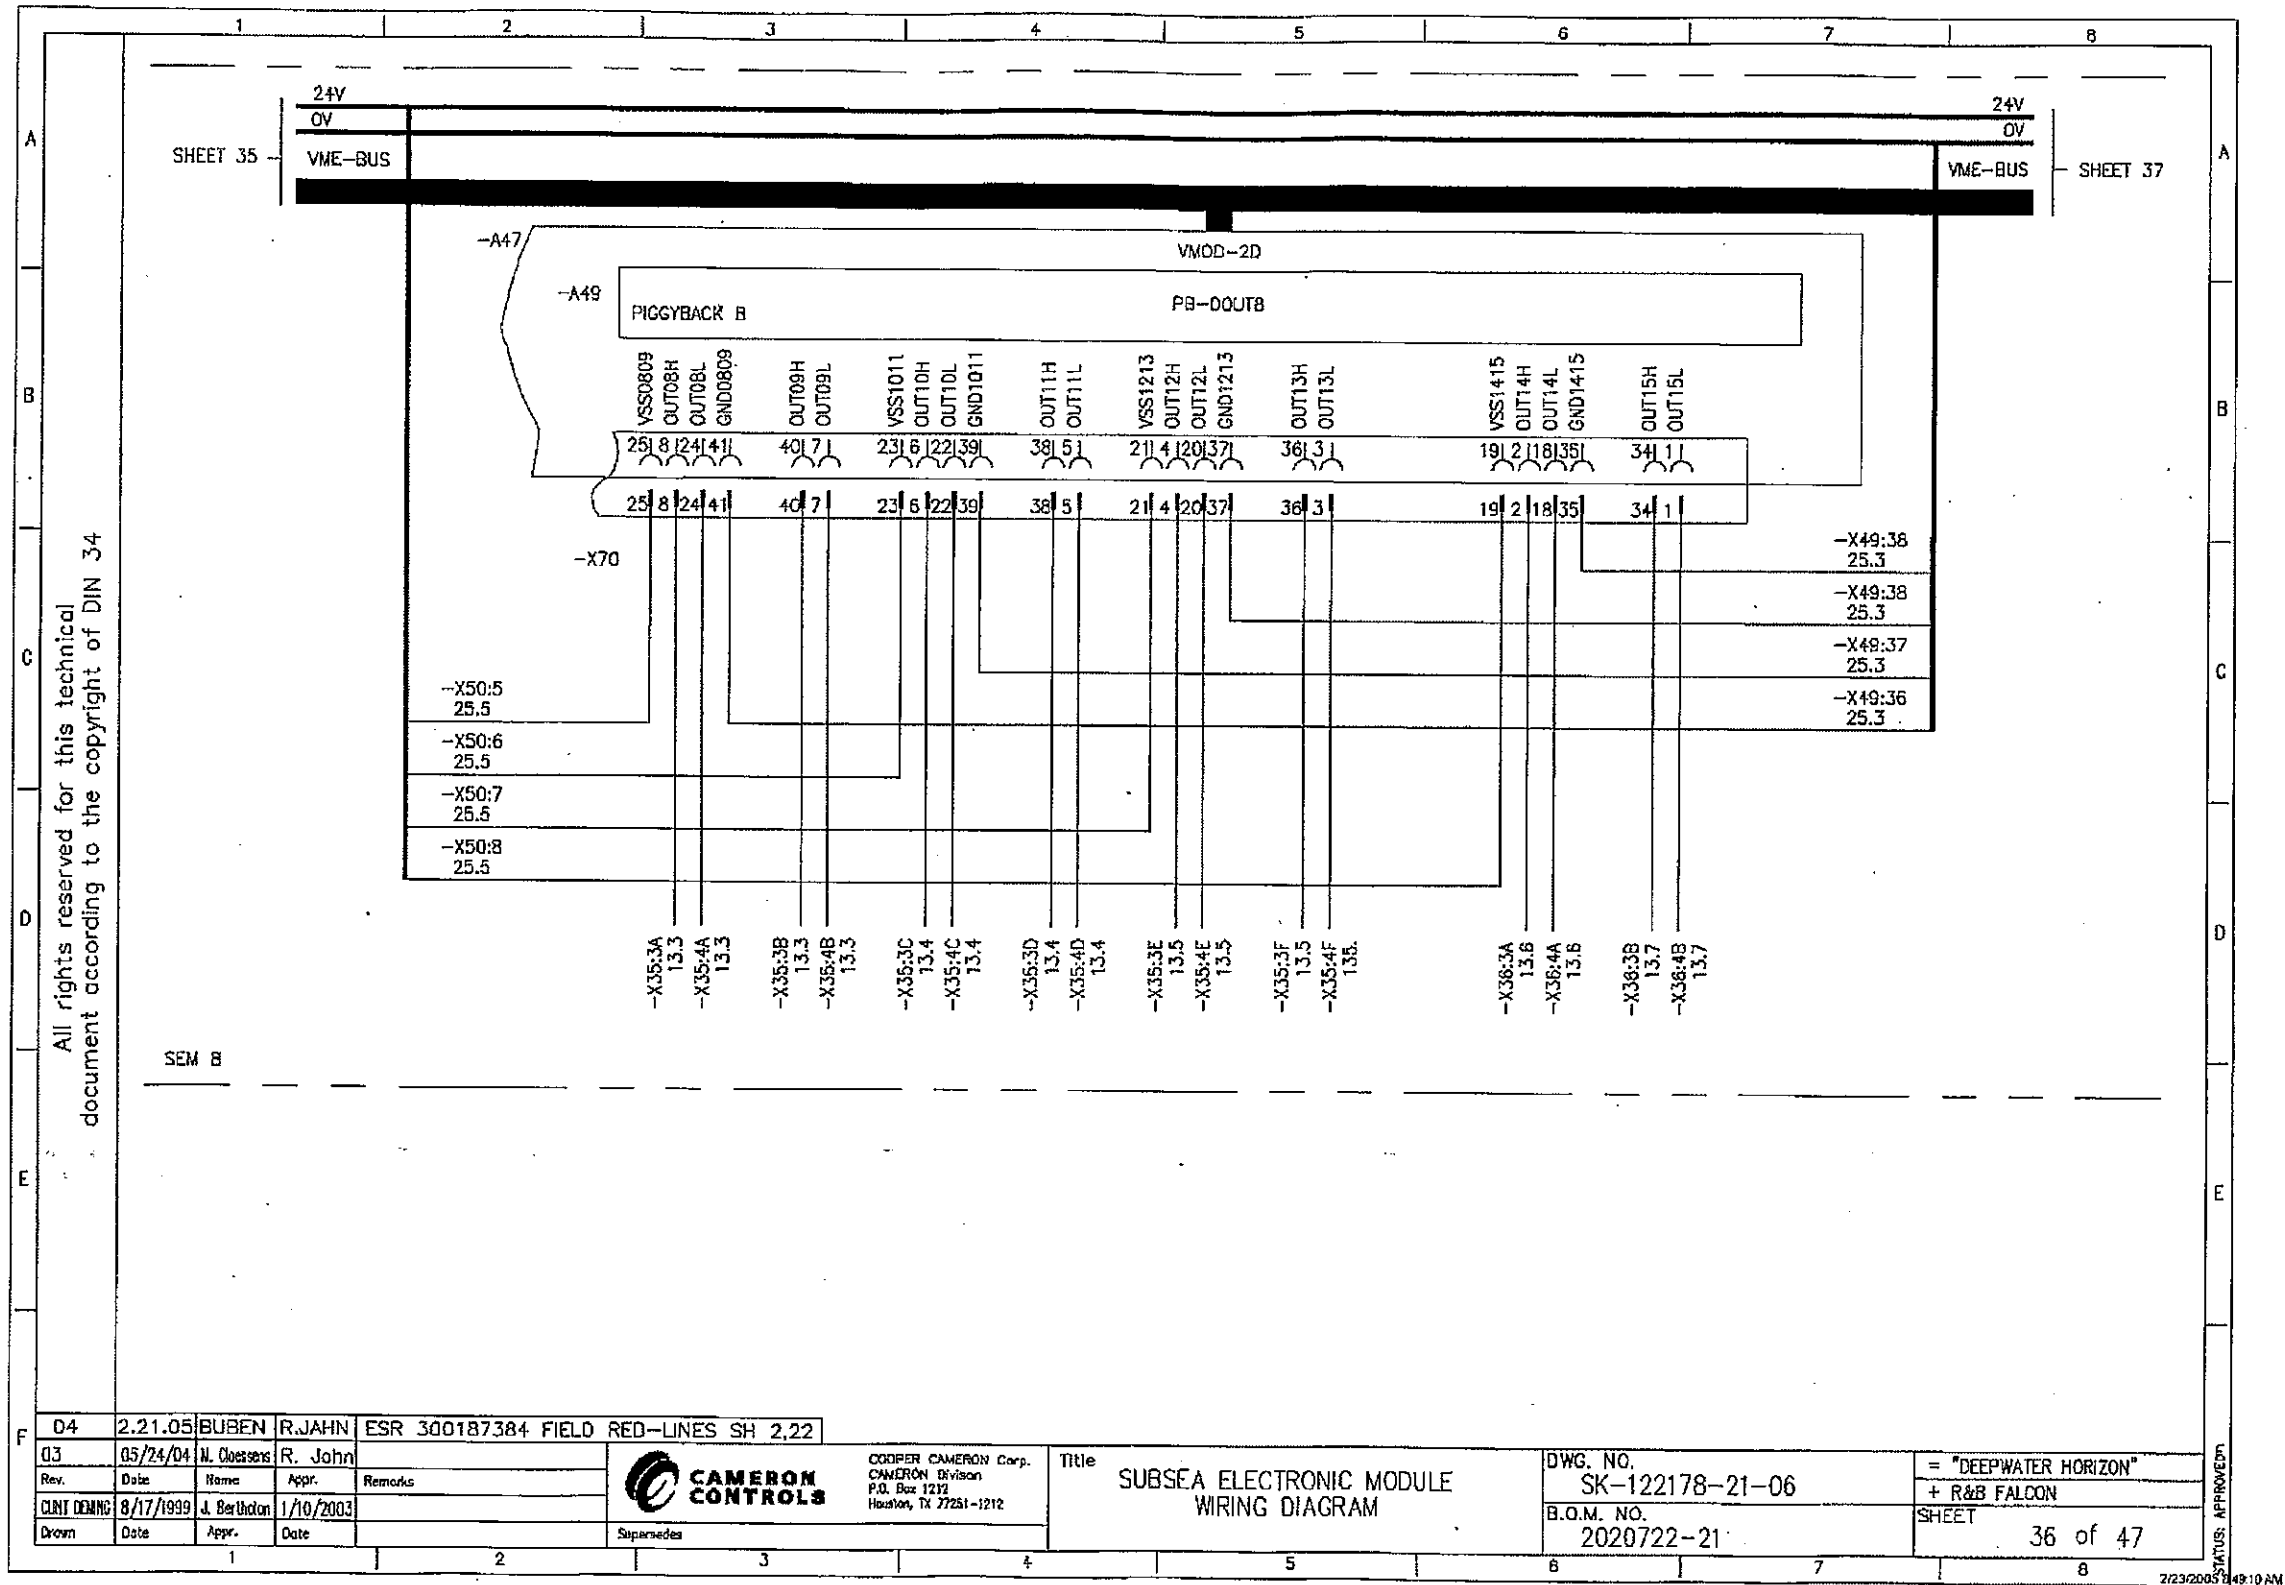


CONFIDENTIAL

TRN-MDL-00304750

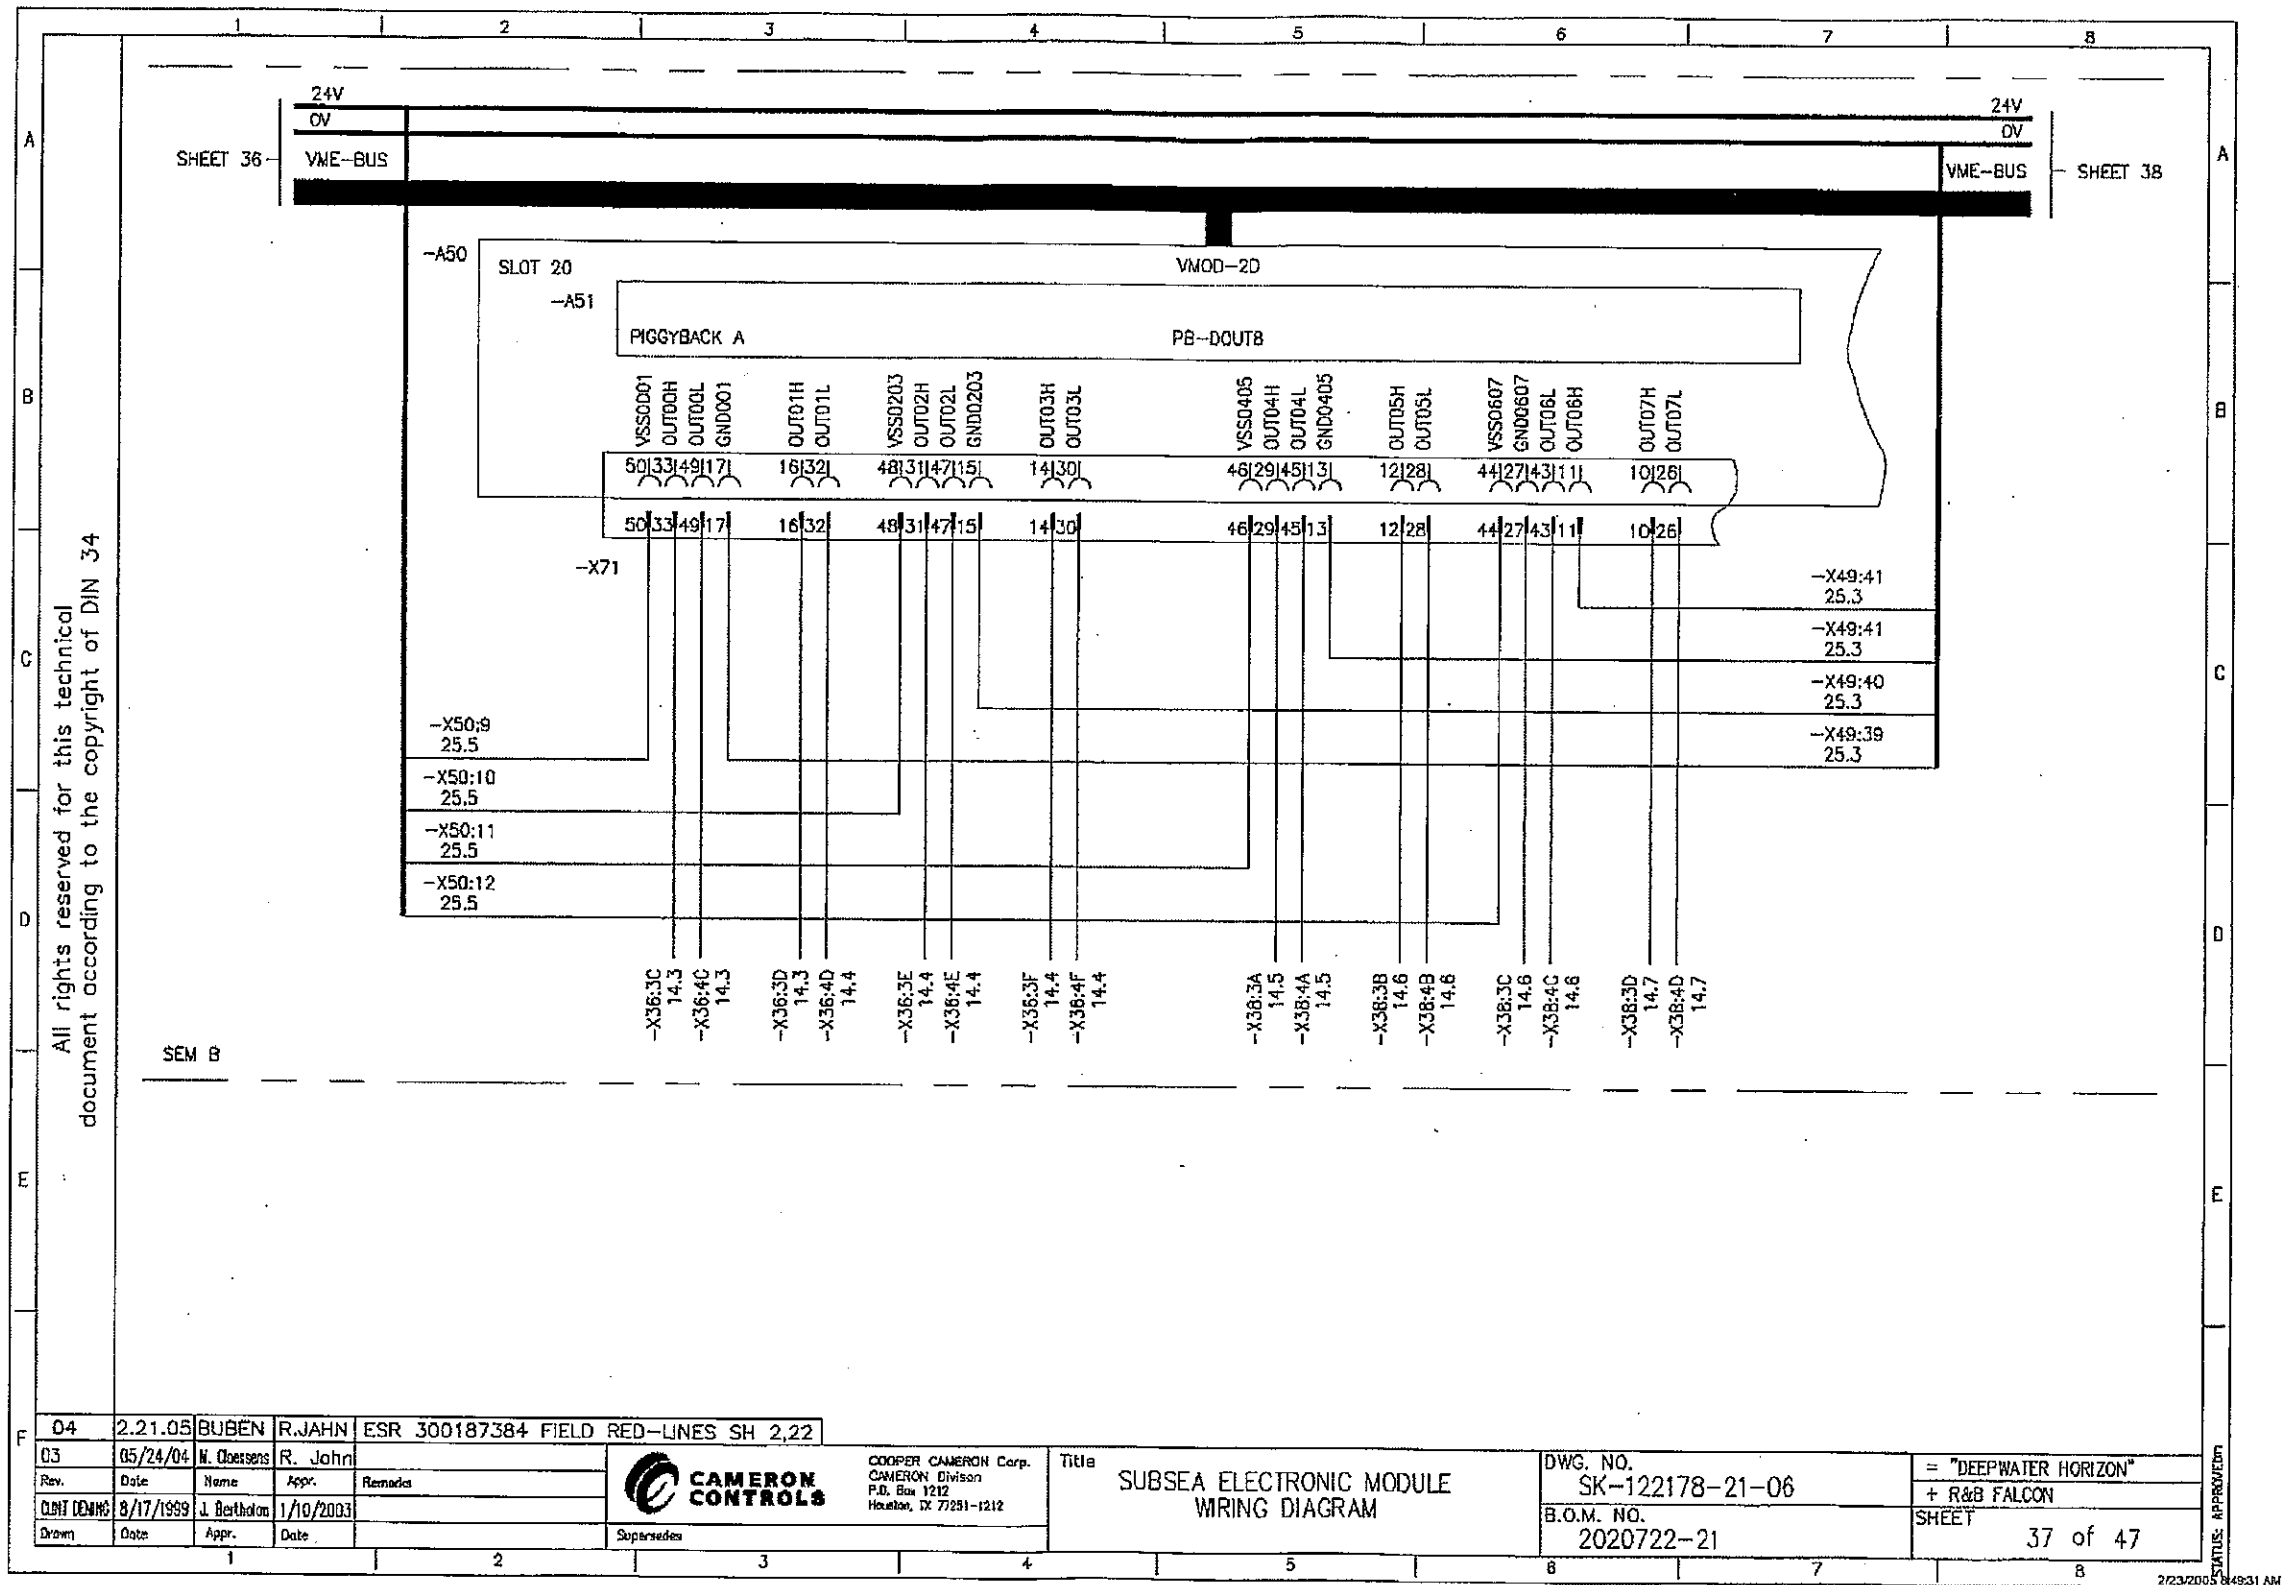


2/24/2005 11:22:07 AM SAP-OTLMORED SK-122178-21-06_001_000_00_CURRENT_CCP100.TIF

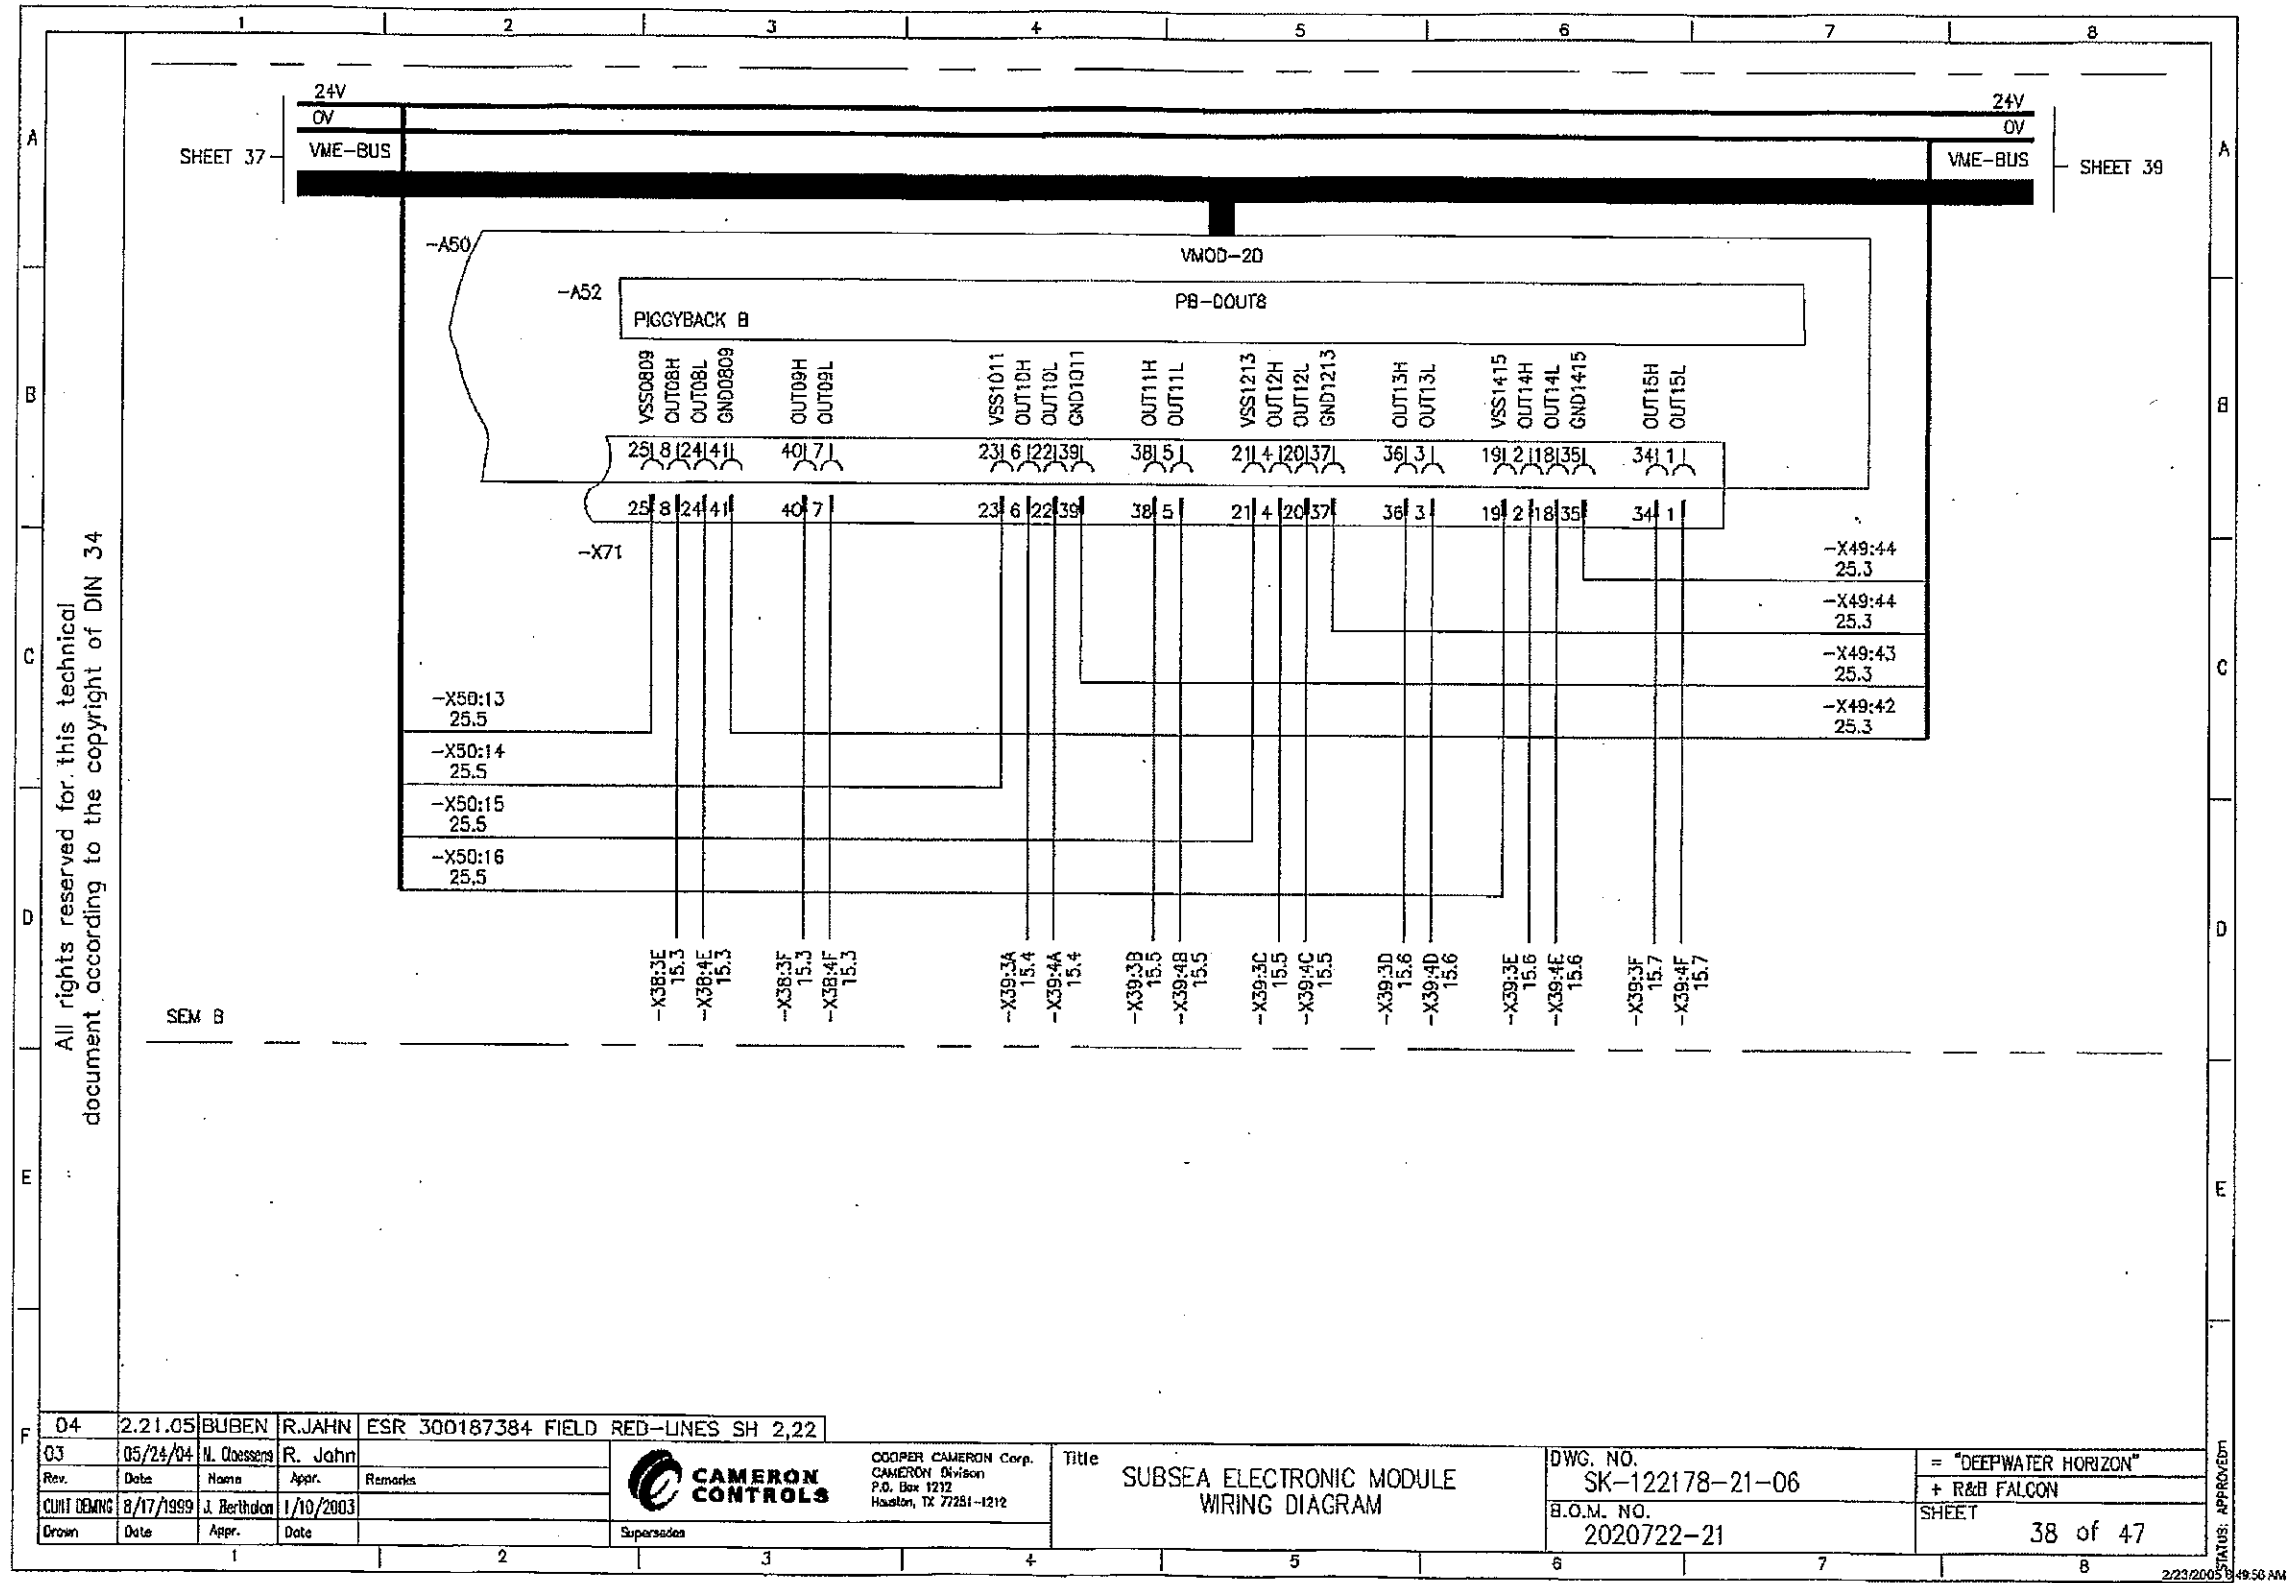


CONFIDENTIAL

TRN-MDL-00304752

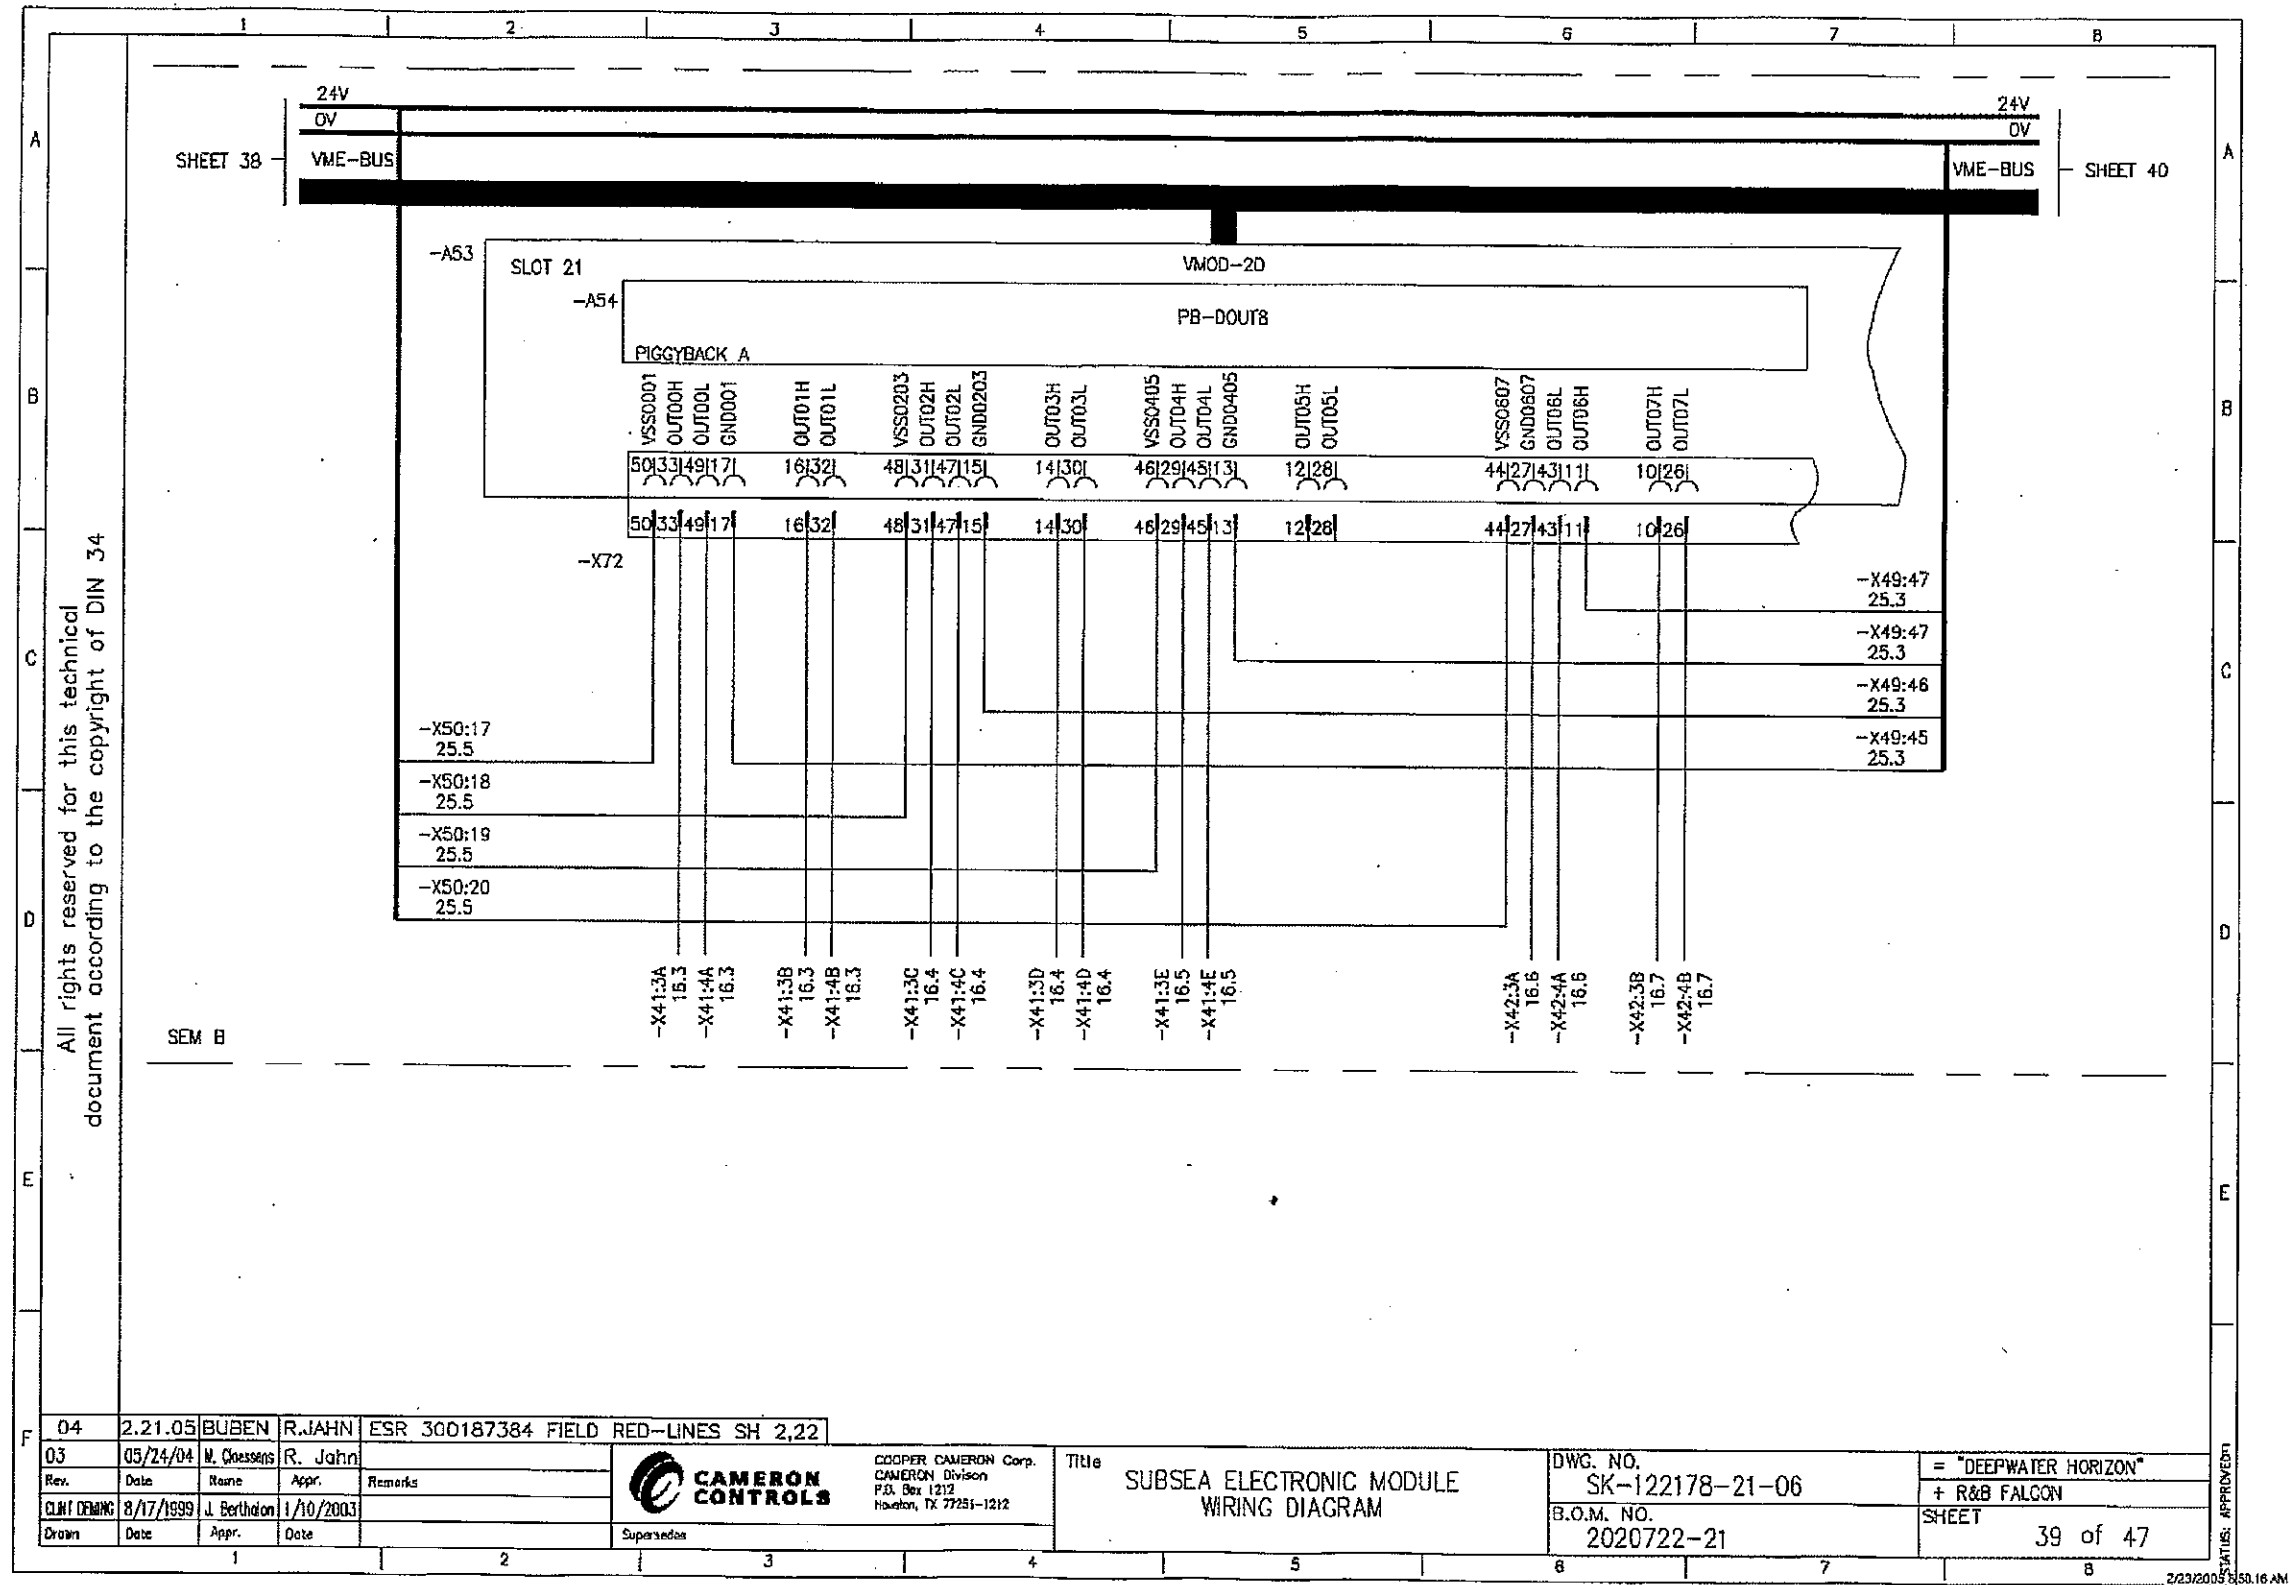




2/24/2005 11:22:07 AM SAP-GILMORED SK-122178-21-06-001...000_00.CURRENT_CCP100.TIF

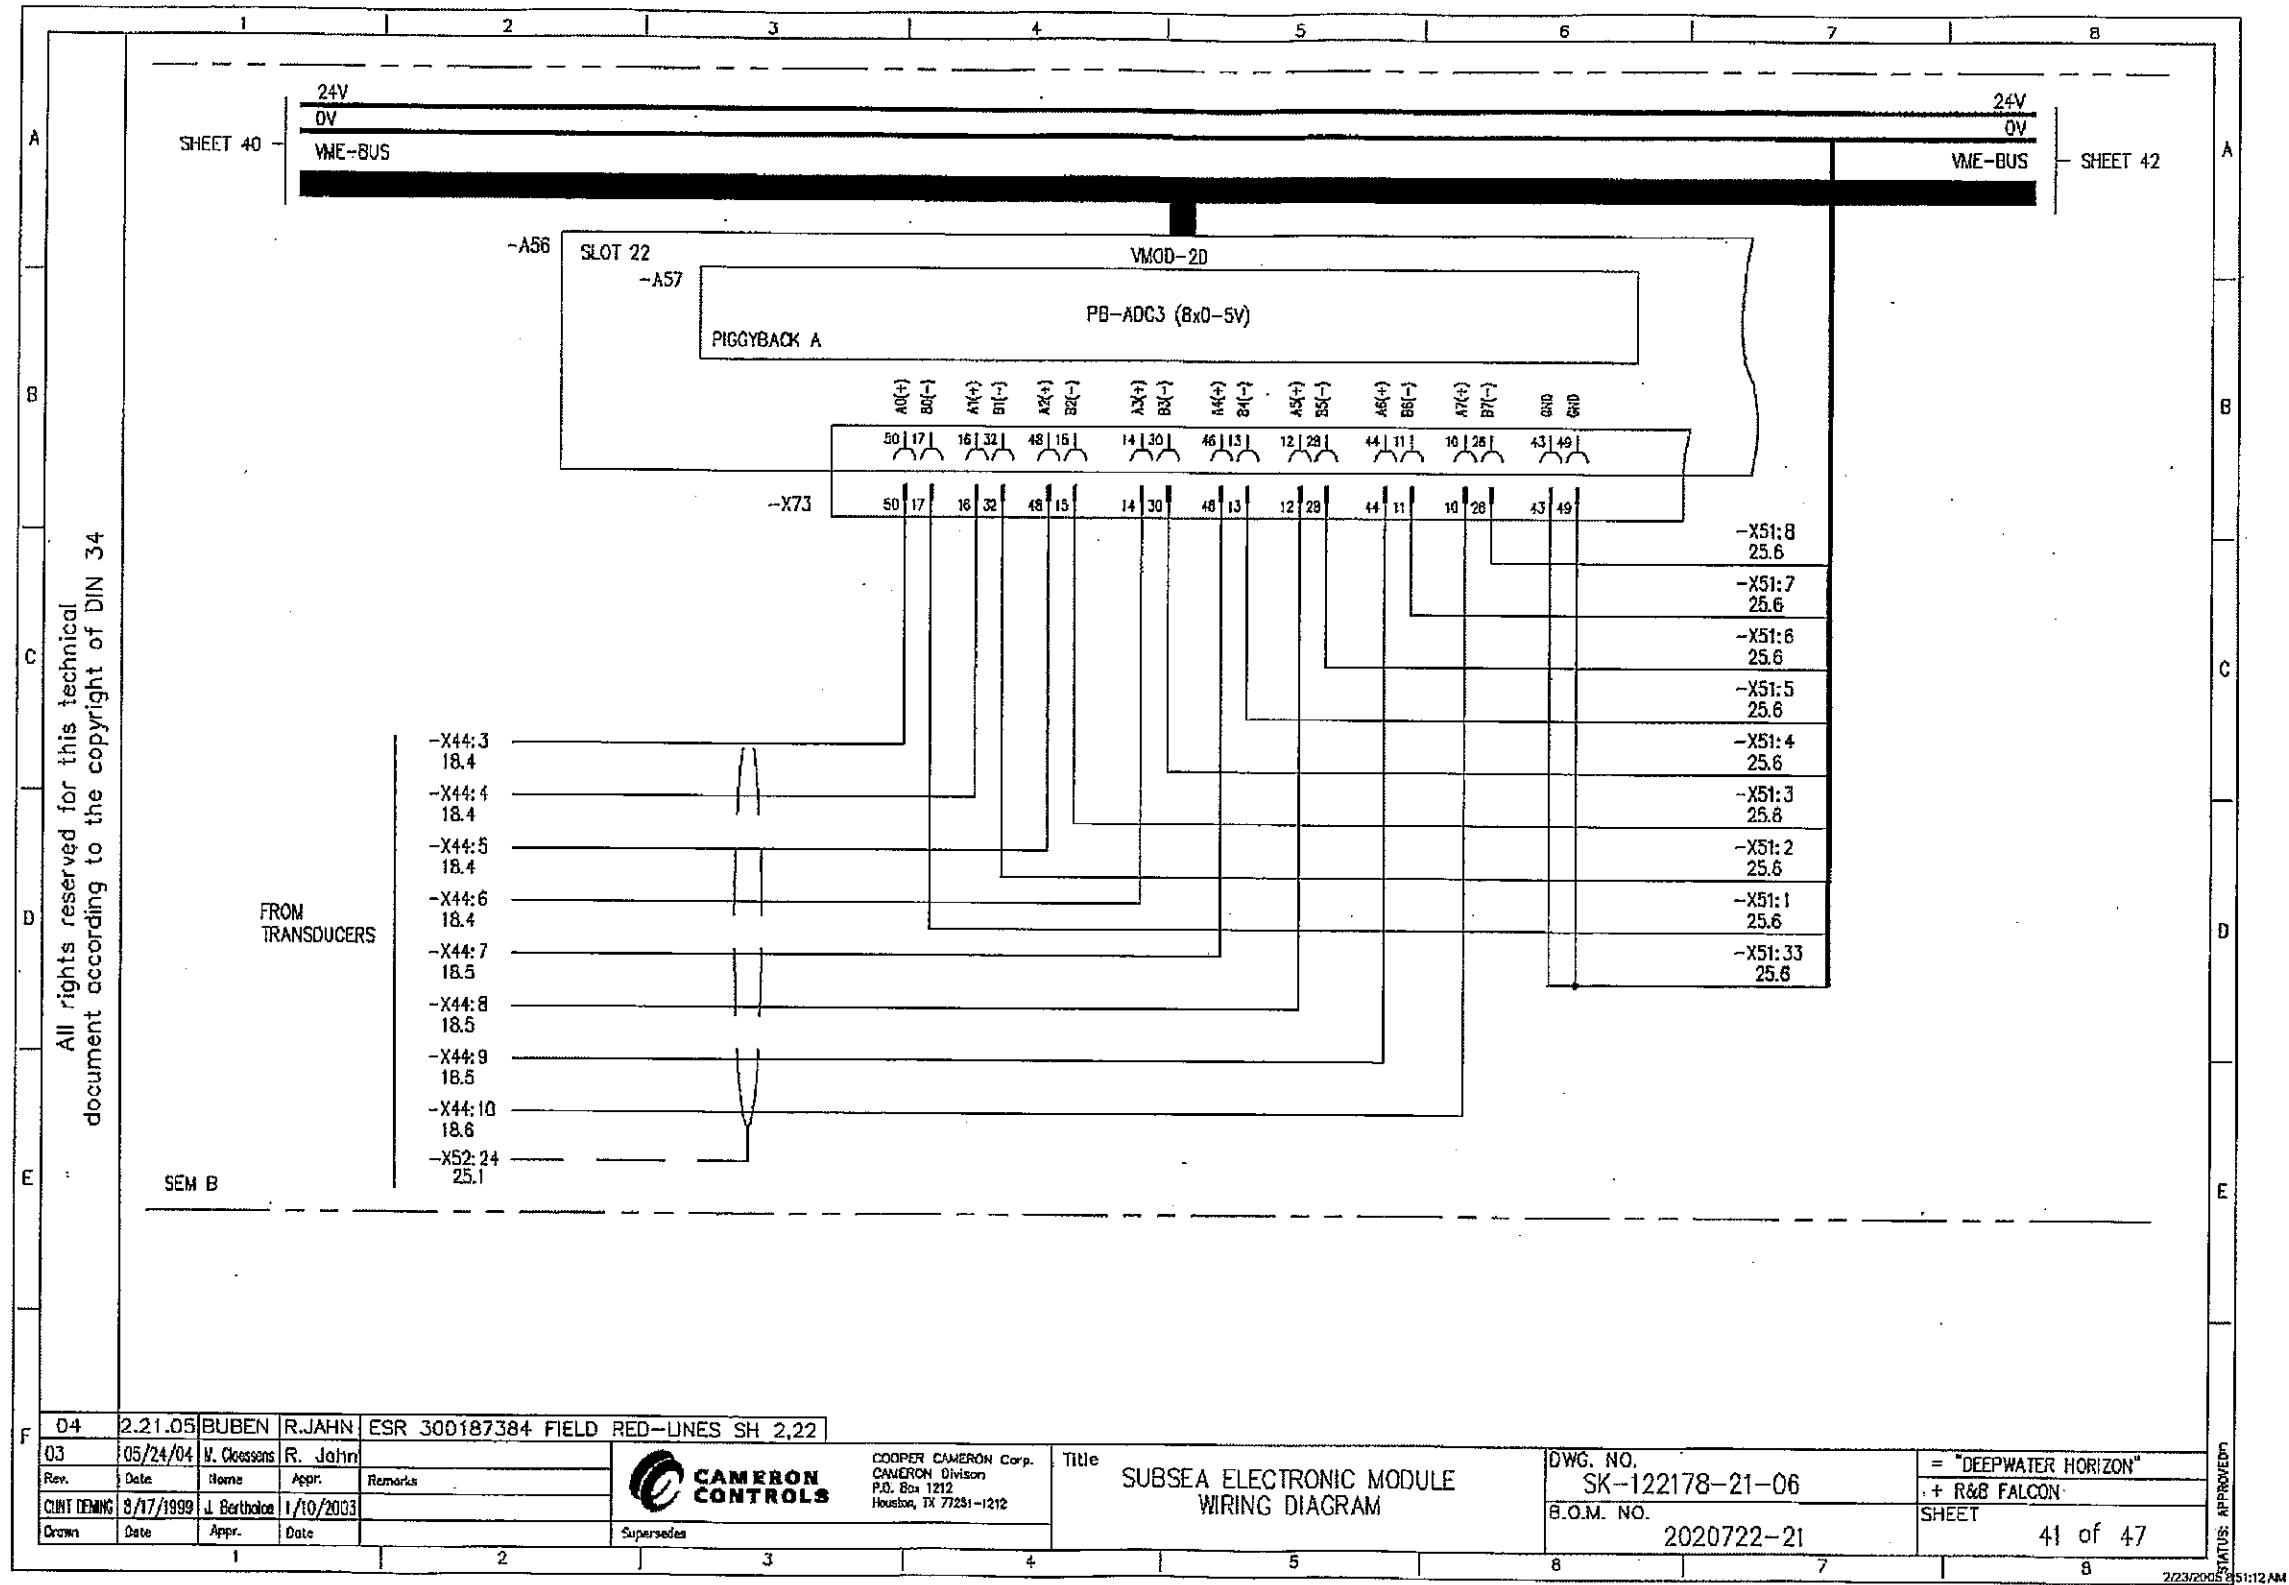

CONFIDENTIAL

TRN-MDL-00304755


2/24/2005 11:22:07 AM SAP-OTLMORED SK-122178-21-06_001_000_00_CURRENT_COPY000.TIF

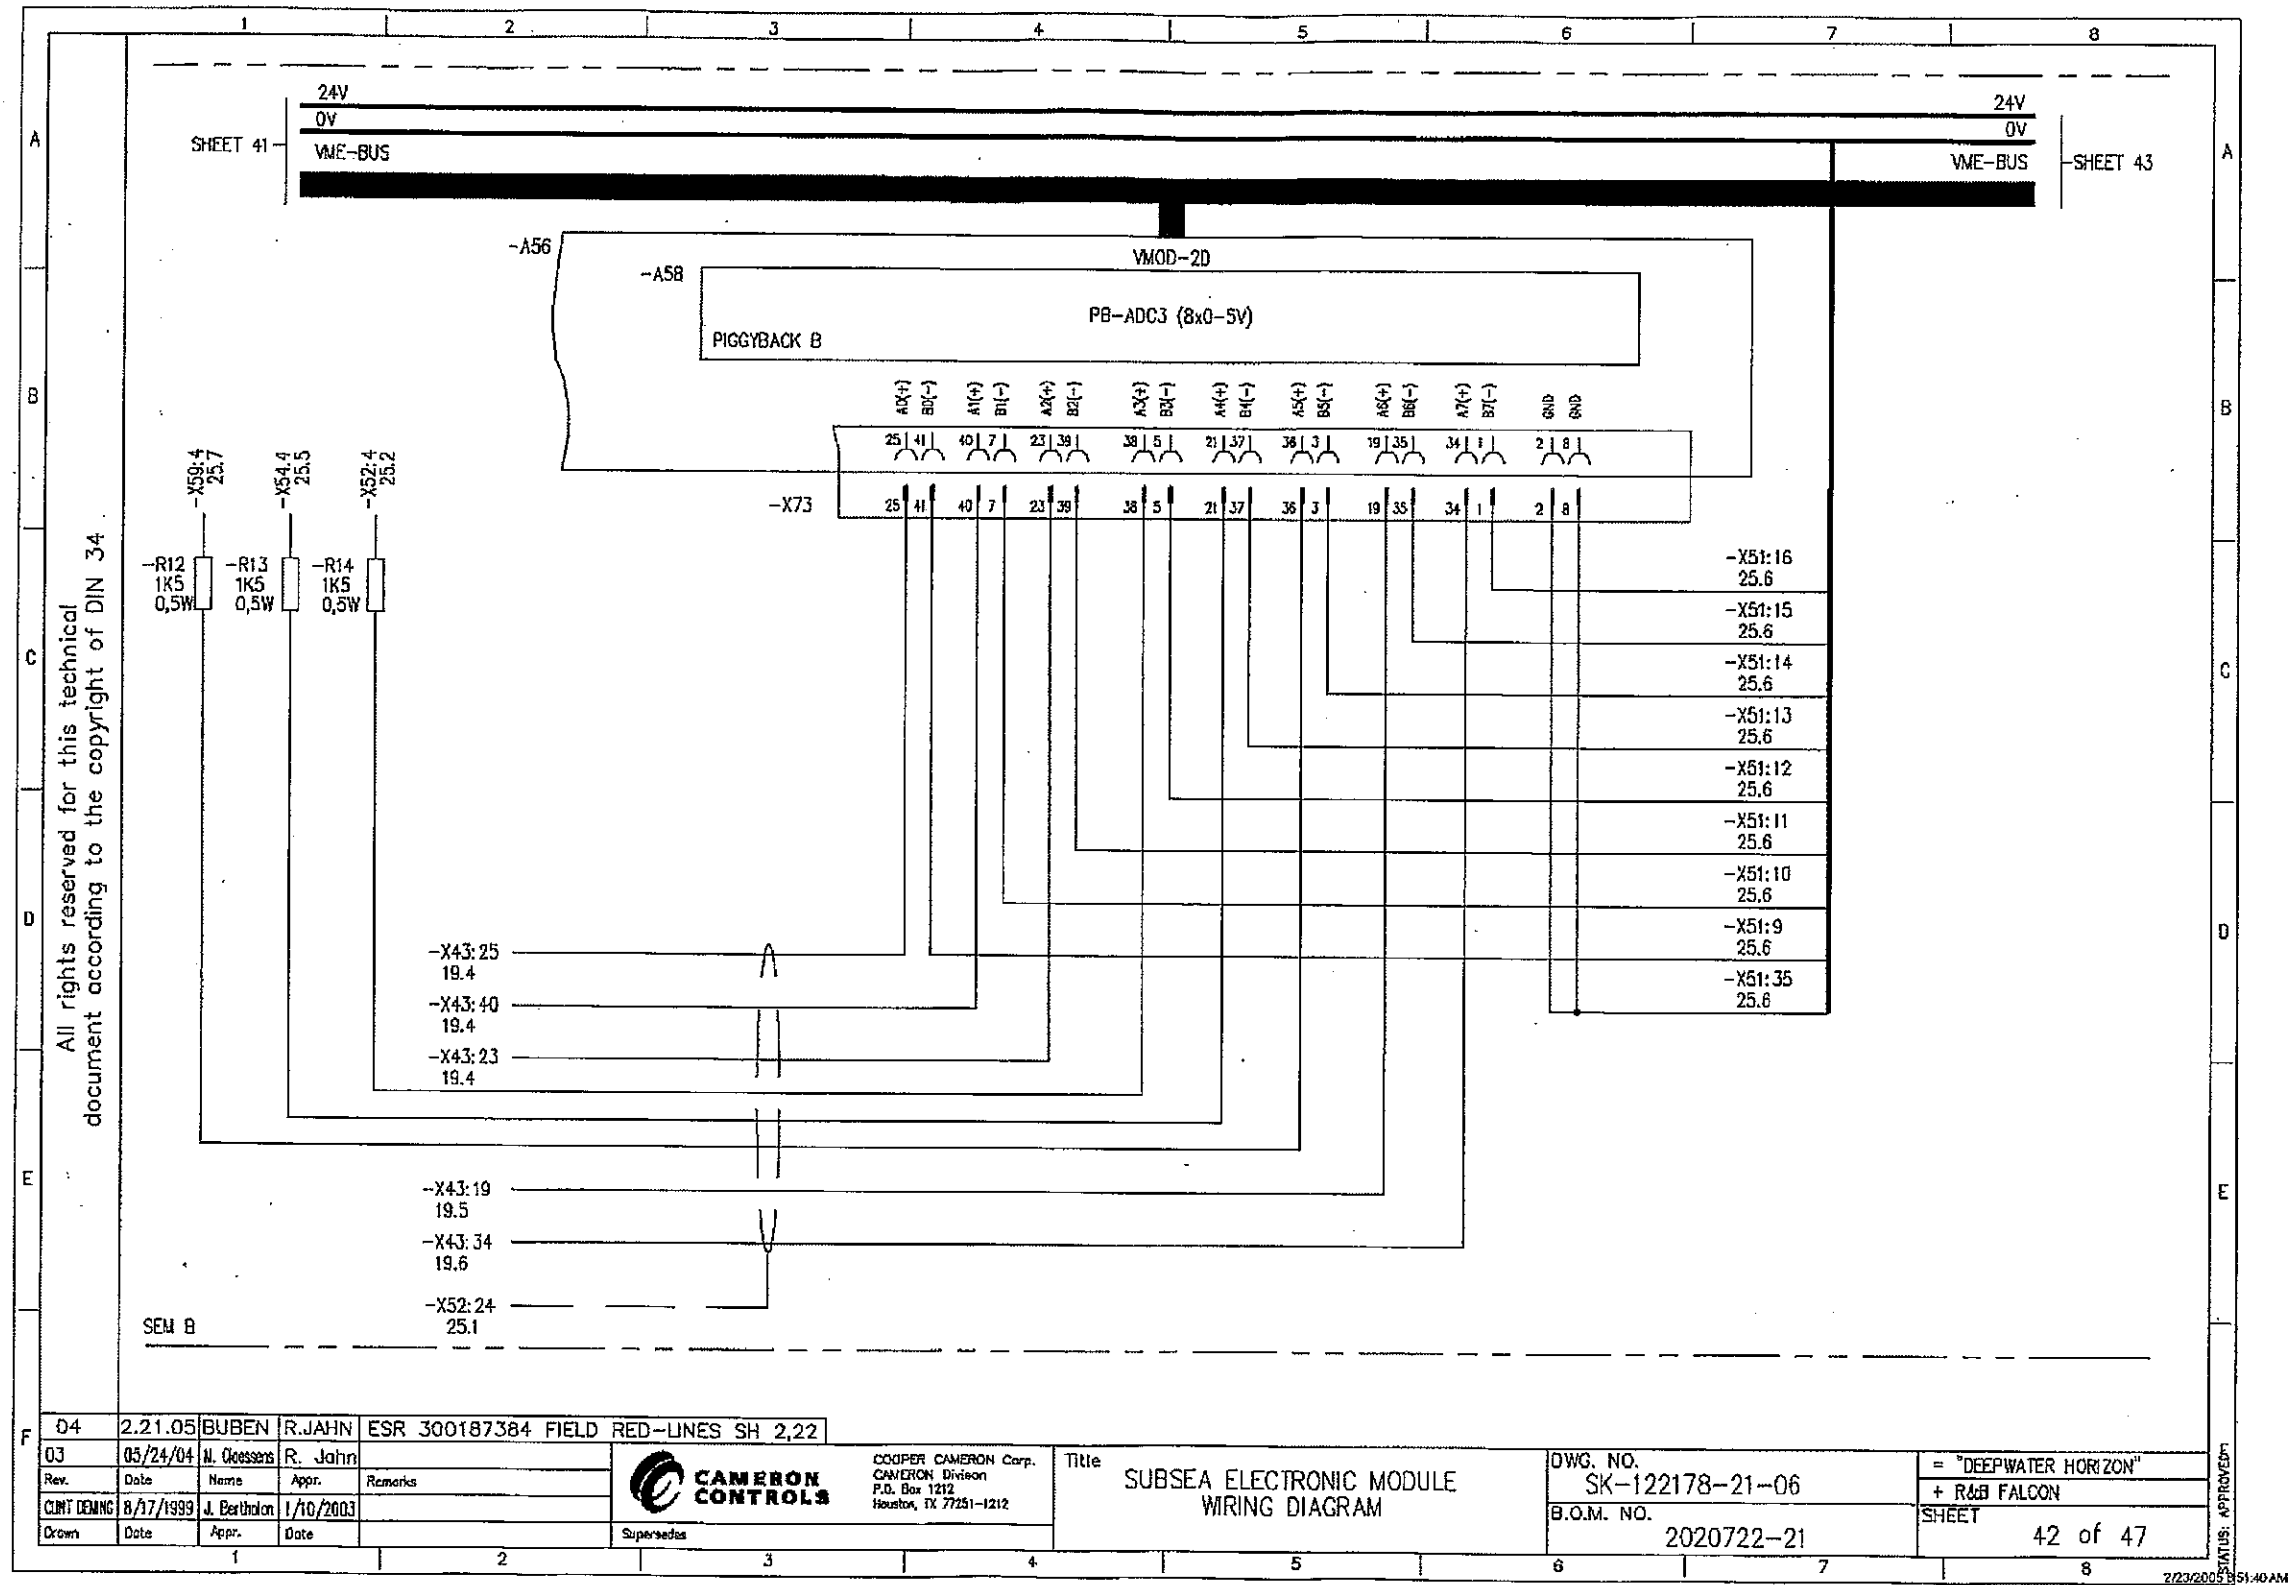

CONFIDENTIAL

TRN-MDL-00304756


2/24/2005 11:22:07 AM SAP-GILMORED SK-122178-21-06.001.000.00_CURRENT_COP100.TIF

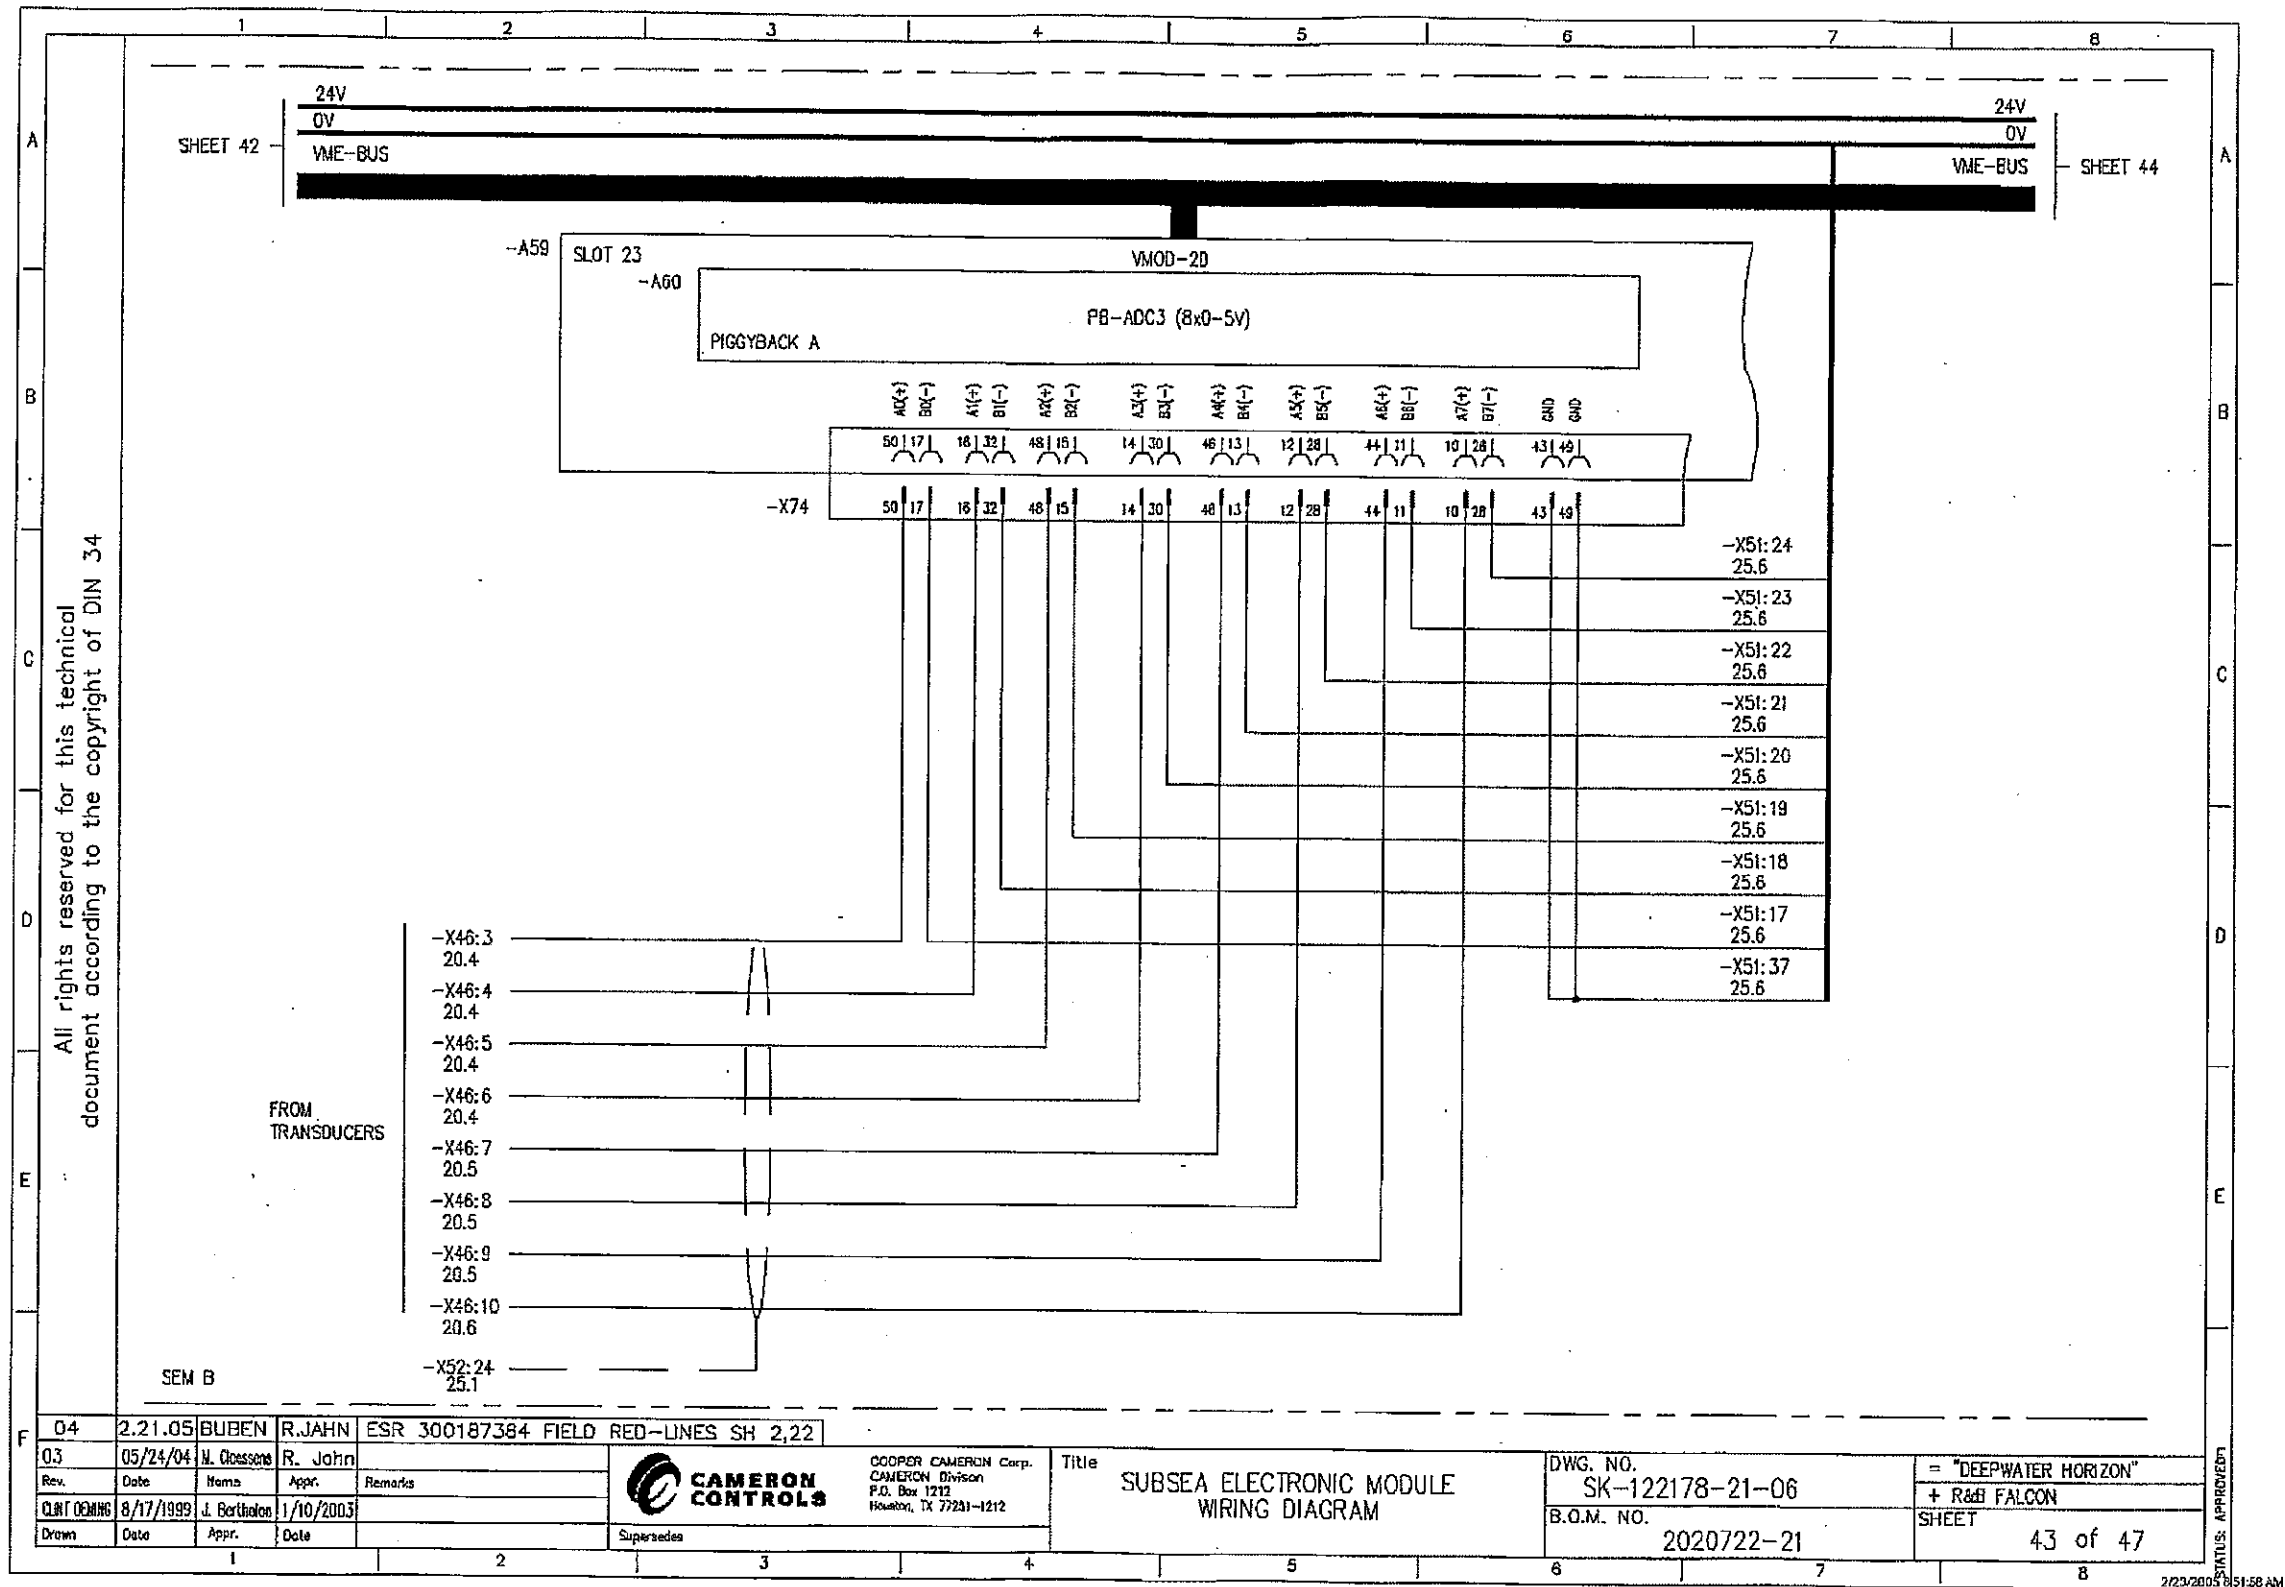

CONFIDENTIAL

TRN-MDL-00304757


2/24/2005 11:22:07 AM SAP-GILMORED SK-122178-21-06_001_000_00_CURRENT_CCP100.TIF

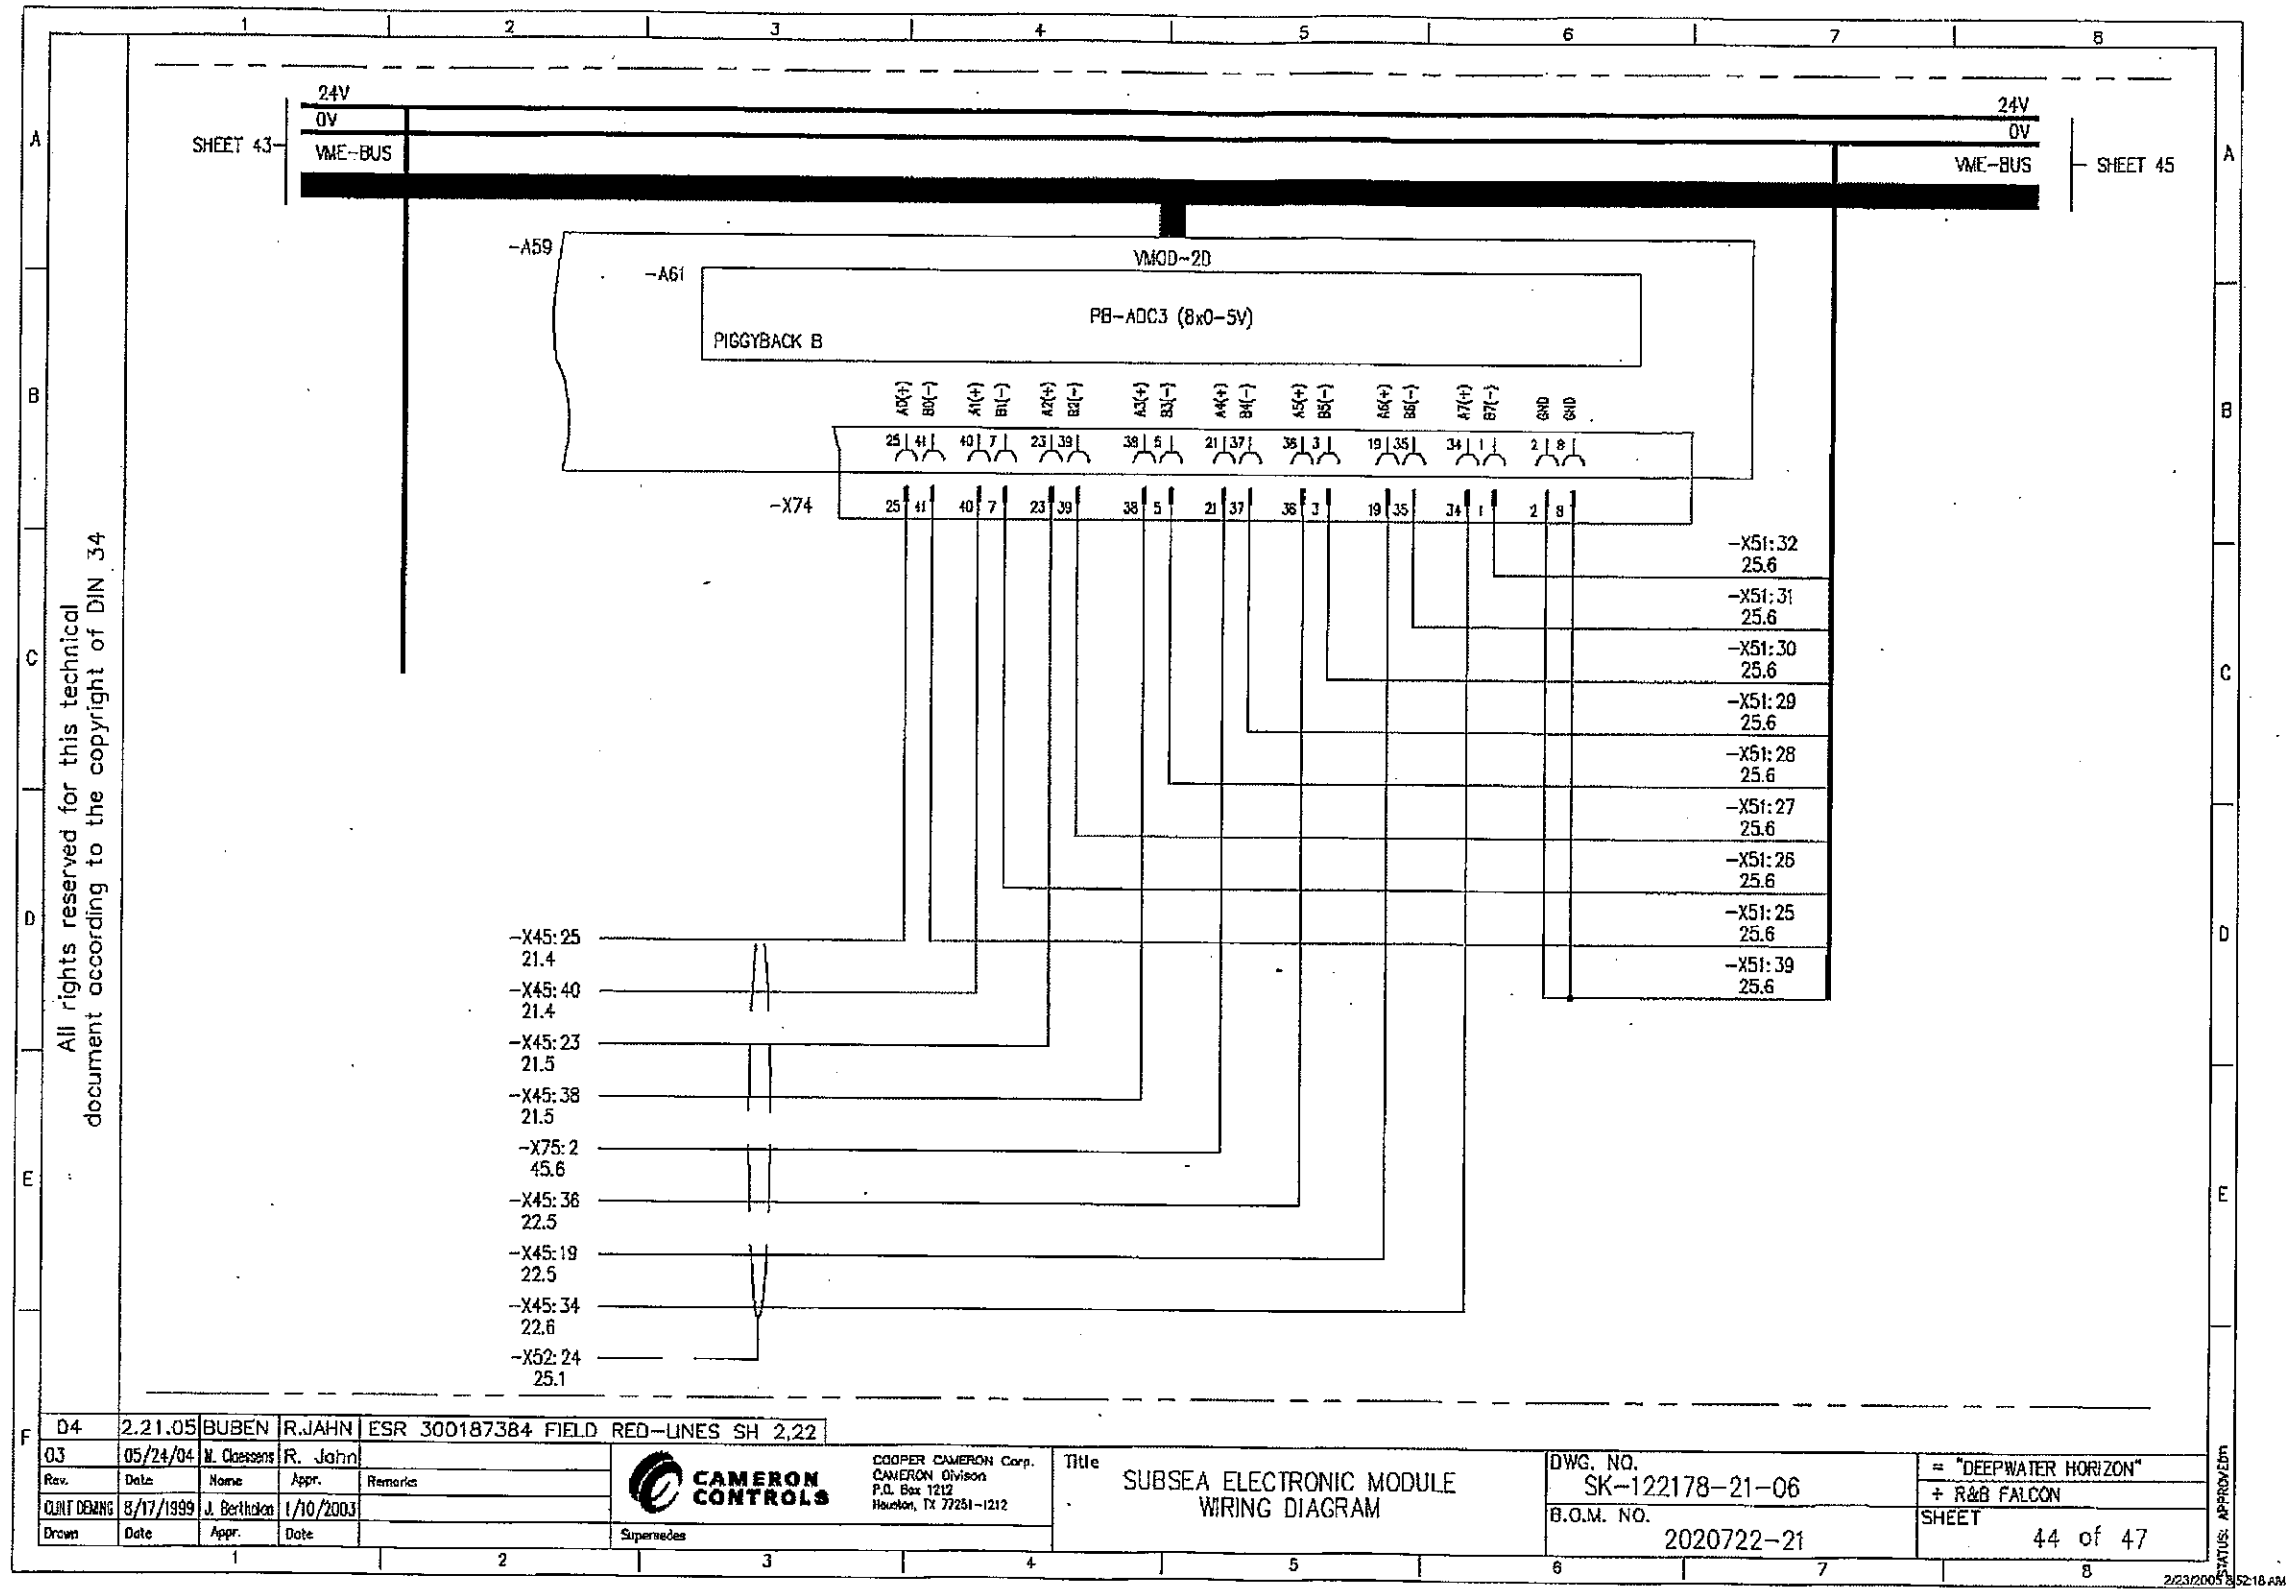

CONFIDENTIAL

TRN-MDL-00304758

2/24/2005 11:22:07 AM SAP-CILMORED SK-122178-21-06_001_000_00_CURRENT_CCP100.TIF

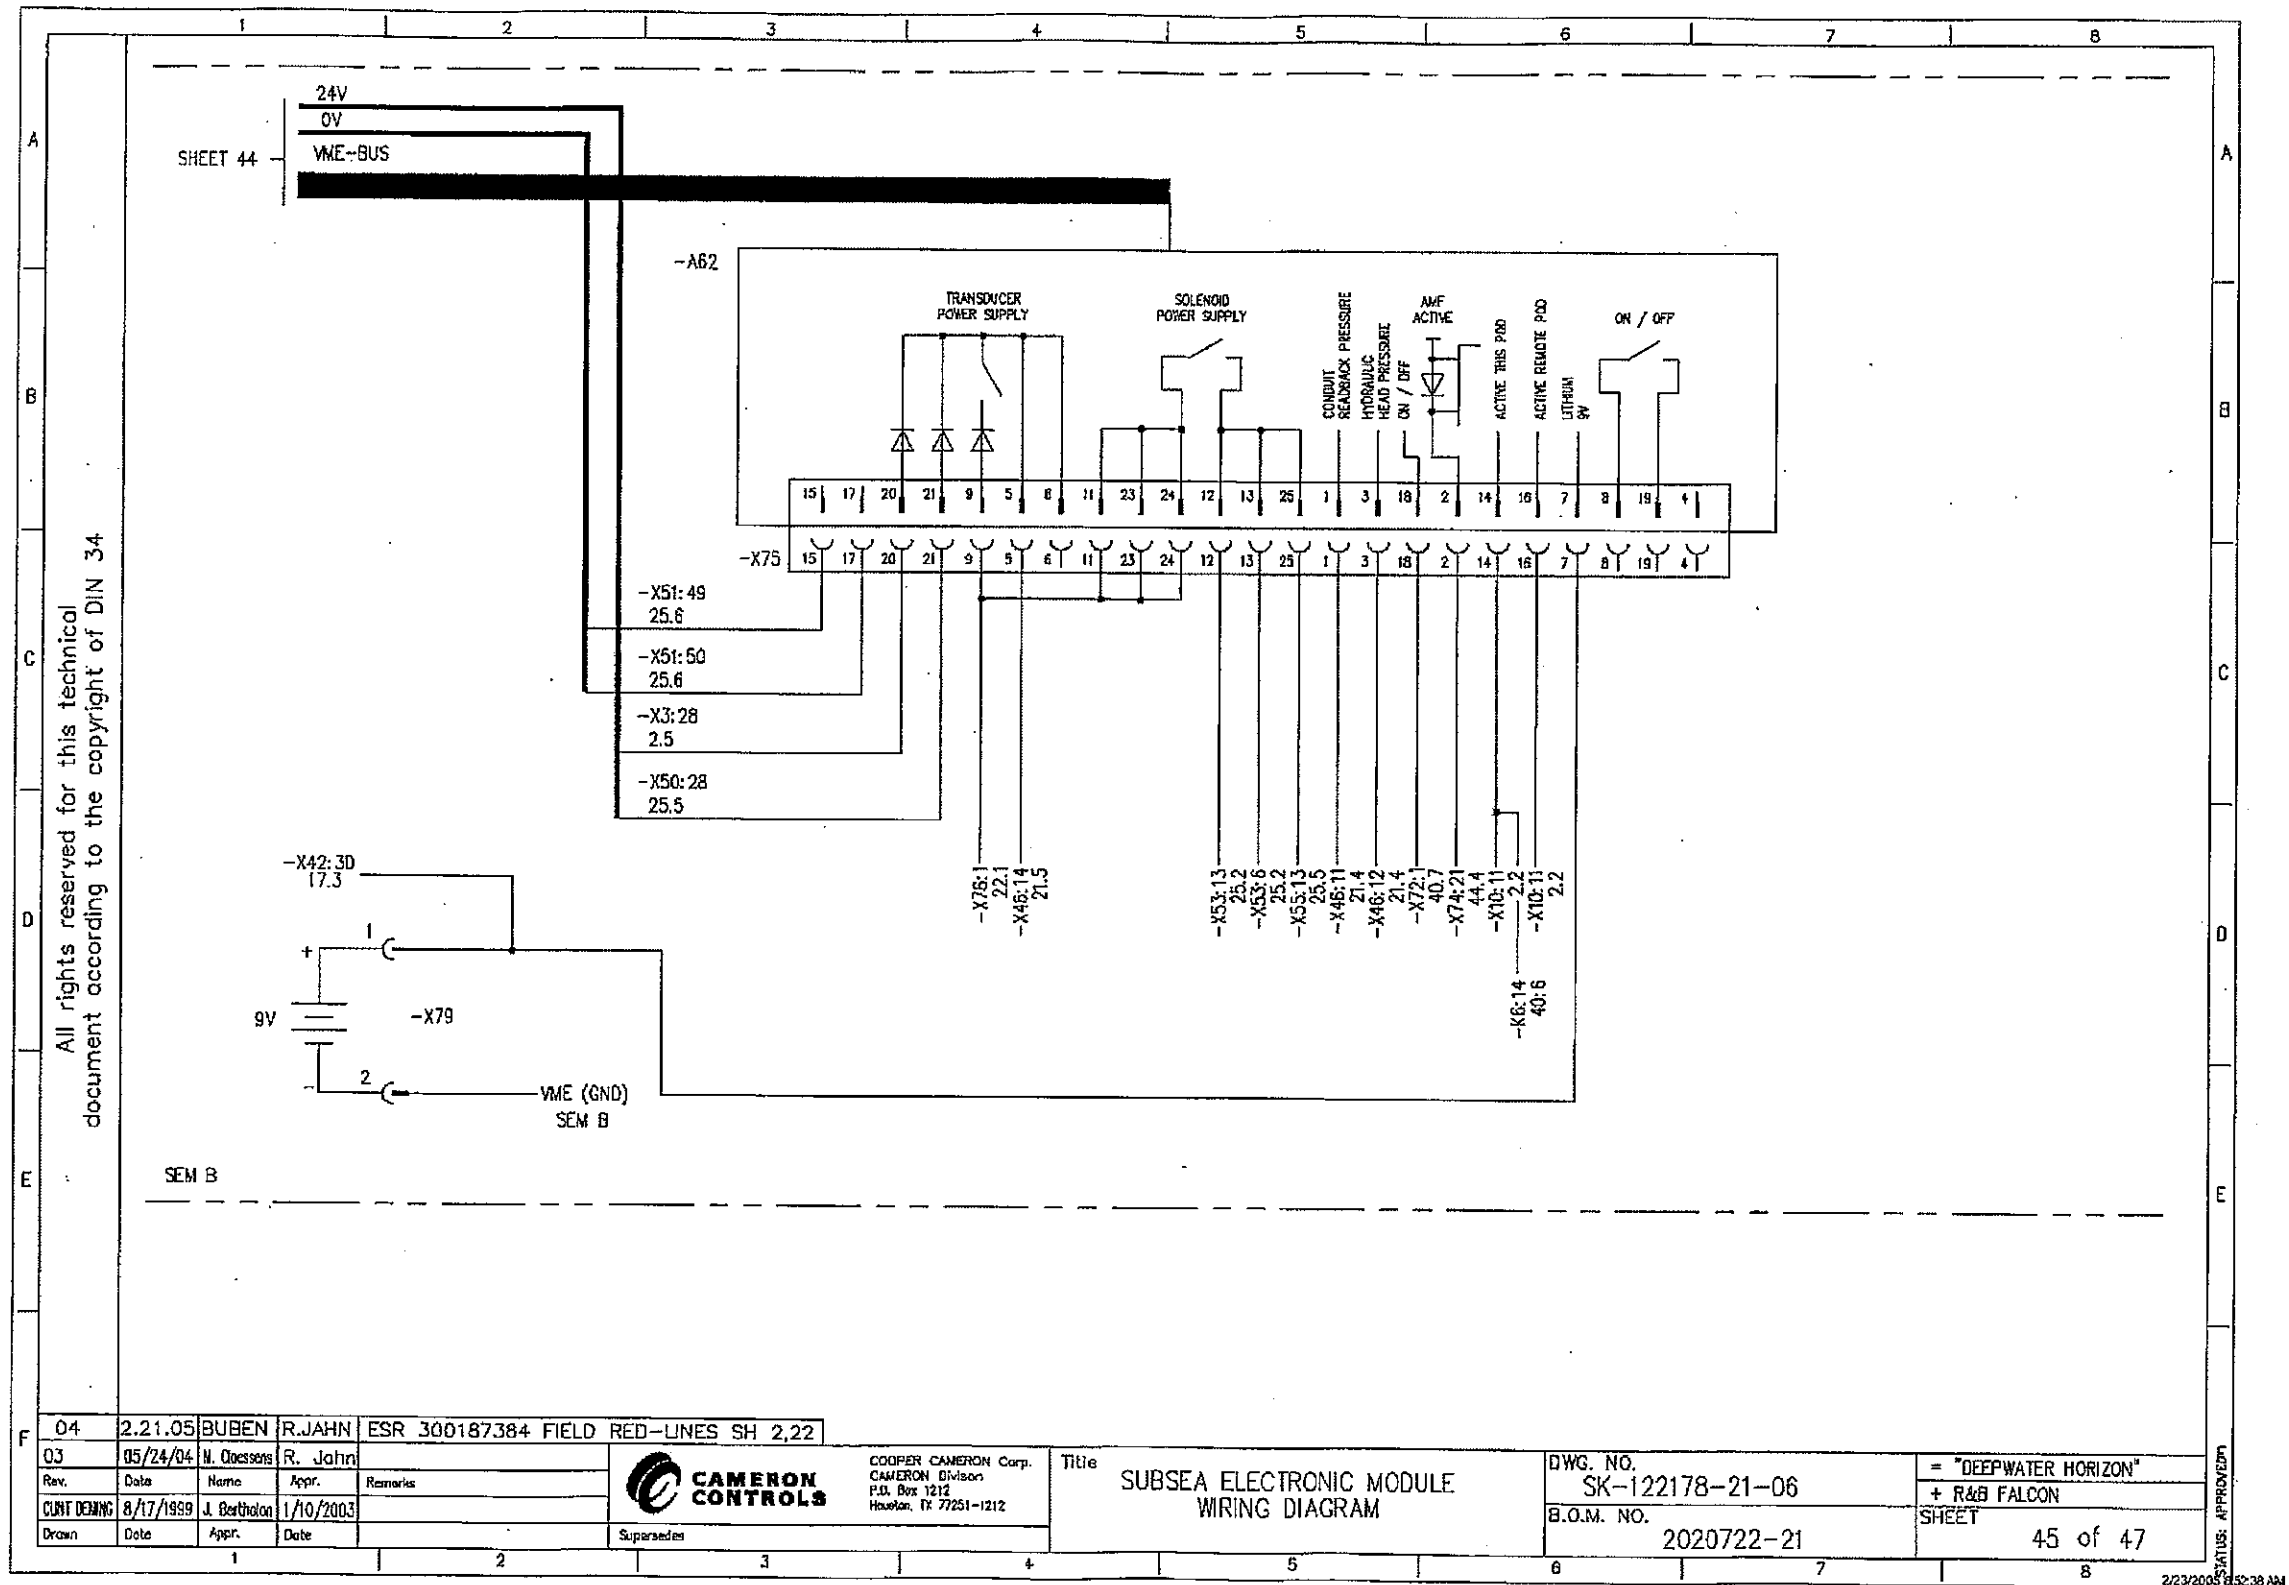

CONFIDENTIAL


TRN-MDL-00304759

2/24/2005 11:22:07 AM SAP-GILMORED SK-122178-21-06_001_000_00_CURRENT.DCP100.TIF

A		24V		24V		A	
B		0V		0V		B	
C		VME-BUS		VME-BUS		C	
D		SHEET 45		SHEET 47		D	
E						E	
F						F	

THIS PAGE HAS BEEN INTENTIONALLY LEFT BLANK

SEM B

04	2.21.05	BUBEN	R.JAHN	ESR 300187384 FIELD RED-LINES SH 2,22	 COOPER CAMERON Corp. CAMERON Division P.O. Box 1212 Houston, TX 77251-1212	Title SUBSEA ELECTRONIC MODULE WIRING DIAGRAM	DWG. NO. SK-122178-21-06	= "DEEPWATER HORIZON"
03	05/24/04	N. Olessens	R. John				+ R&B FALCON	
Rev.	Date	Name	Appr.	Remarks			B.O.M. NO.	SHEET
CLINT BOWING	8/17/1999	J. Bertickson	1/10/2003				2020722-21	46 of 47

2/23/2005 8:53:00 AM

CONFIDENTIAL


TRN-MDL-00304760

2/24/2005 1:22:07 AM SAP-GILMORED SK-122178-21-06-001-000-00-CURRENT-CCP100.TIF

A				2				3				4				5				6				7				8			
SHEET 46				24V				0V				24V				0V				VME-BUS				VME-BUS							
B																															
C																															
D																															
E																															
F																															

THIS PAGE HAS BEEN INTENTIONALLY LEFT BLANK

SEM B

04				2.21.05				BUBEN R. JAHN				ESR 300187384 FIELD RED-LINES SH 2,22											
Rev.	Date	Name	Appr.	Remarks				 COOPER CAMERON Corp. CAMERON Division P.O. Box 1212 Houston, TX 77251-1212				Title SUBSEA ELECTRONIC MODULE WIRING DIAGRAM				DWG. NO. SK-122178-21-06				= "DEEPWATER HORIZON"			
03	05/24/04	M. Goessens	R. Jahn													B.O.M. NO. 2020722-21				+ R&E FALCON			
02	08/17/1999	J. Berthoin	1/10/2003					Supersedes								SHEET 47 of 47							
01	08/17/1999	J. Berthoin	1/10/2003																				

2/23/2005 8:53:21 AM

CONFIDENTIAL

TRN-MDL-00304761